

ABERNATHY and ASSOCIATES

Kenneth B. Abernathy Jr.

Wisconsin Registered Land Surveyor S-1594

Rt. 3, Box 273
Elkhorn, Wisconsin 53121
Phone: (414) 723-4260 (office)
(414) 723-4813 (residence)

PLAT OF SURVEY

LOT 3 OF CERTIFIED SURVEY MAP NO.
1059 AS RECORDED IN VOL. 5 OF
CERTIFIED SURVEY MAPS ON PAGES 39, 40
AND 41 AS DOCUMENT NO. 60697,
LOCATED IN THE SOUTHEAST 1/4 OF
SECTION 22, TOWN 2 NORTH, RANGE 18
EAST, WALWORTH COUNTY, WISCONSIN.

LOT 2

R = 60.00'

ROAD 66' WIDE

PRIVATE

LOT 1 C. S. M. 1058

LOT 3
2.05 ACRES

LOT 4

ORDERED BY: SCHAUDER BUILDERS
RT. 2 BOX 28A
LAKE GENEVA, WI. 53147

OWNERS: MIKE AND SUSAN REKENTHALER
3140 BARRY
LAKE GENEVA, WI. 53147

PROPOSED DRIVEWAY

PROPOSED RESIDENCE

20' WIDE EASEMENT

EXISTING WIRE FENCE


C. S. M. 1059



SCALE 1" = 40 FEET

Legend

- FOUND IRON PIPE
- FOUND IRON ROD
- FOUND BRASS CAPPED MONUMENT
- ✱ FOUND CONCRETE MONUMENT
- + CHISEL CUT IN CONCRETE
- SET IRON ROD, 24" LONG, WEIGHING 1.5 LBS., LINEAL FT., 3/4" DIA.
- SET IRON ROD, 30" LONG, WEIGHING 4.5 LBS., LINEAL FT., 1-11/16" DIA.
- (xx) RECORDED AS DIMENSION
- x-x- EXISTING FENCE

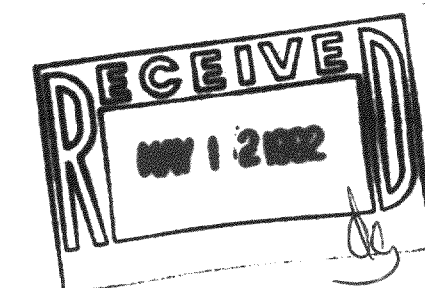


SCALE 1" = 40 FEET

"I hereby certify that I have surveyed the above described property and that the above map is a true representation thereof and shows the size and location of the property, its exterior boundaries, the location of all visible structures and dimensions of all principal buildings thereon, boundary fences, apparent easements, roadways and visible encroachments, if any."

"This survey is made for the use of the present owners of the property, and also those who purchase, mortgage, or guarantee the title thereto within one year from date hereof."

Kenneth B. Abernathy Jr.
KENNETH B. ABERNATHY, JR.
WISCONSIN REGISTERED LAND SURVEYOR
S-1594

Date: 12/17/91 Job No. 711204

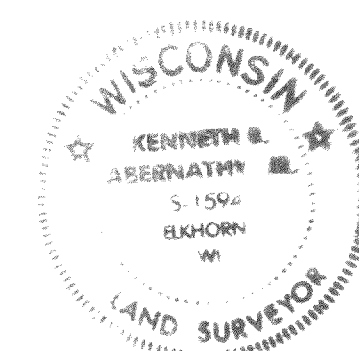

ABERNATHY and ASSOCIATES

Kenneth B. Abernathy Jr.

Wisconsin Registered Land Surveyor S-1594

Rt. 3, Box 273
Elkhorn, Wisconsin 53121
Phone: (414) 723-4260 (office)
(414) 723-4813 (residence)

PLAT OF SURVEY

LOT 3 OF CERTIFIED SURVEY MAP NO. 1059 AS RECORDED IN VOL. 5 OF CERTIFIED SURVEY MAPS ON PAGES 39, 40 AND 41 AS DOCUMENT NO. 60697, LOCATED IN THE SOUTHEAST 1/4 OF SECTION 22, TOWN 2 NORTH, RANGE 18 EAST, WALWORTH COUNTY, WISCONSIN.

LOT 2

LOT 1

ROAD 66' WIDE

PRIVATE

R = 60.00'

LOT 1 C. S. M. 1058

LOT 3
2.05 ACRES

LOT 4

PROPOSED DRIVEWAY

ORDERED BY: SCHAUDER BUILDERS
RT. 2 BOX 28A
LAKE GENEVA, WI. 53147


OWNERS: MIKE AND SUSAN REKENTHALER
3140 BARRY
LAKE GENEVA, WI. 53147

EXISTING FOUNDATION

SCALE 1" = 40 FEET

Legend

- FOUND IRON PIPE
- FOUND IRON ROD
- FOUND BRASS CAPPED MONUMENT
- FOUND CONCRETE MONUMENT
- CHISEL CUT IN CONCRETE
- SET IRON ROD, 24" LONG, WEIGHING 1.5 LBS./LINEAL FT., 3/8" DIA.
- SET IRON ROD, 30" LONG, WEIGHING 4.5 LBS./LINEAL FT., 1-11/16" DIA.
- (xx) RECORDED AS DIMENSION
- EXISTING FENCE

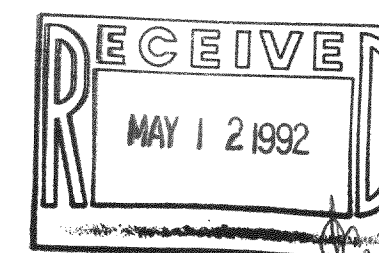

SCALE: 1" = 40 FEET

"I hereby certify that I have surveyed the above described property and that the above map is a true representation thereof and shows the size and location of the property, its exterior boundaries, the location of all visible structures and dimensions of all principal buildings thereon, boundary fences, apparent easements, roadways and visible encroachments, if any."

"This survey is made for the use of the present owners of the property, and also those who purchase, mortgage, or guarantee the title thereto within one year from date hereof."

Kenneth B. Abernathy Jr.

KENNETH B. ABERNATHY, JR.
WISCONSIN REGISTERED LAND SURVEYOR
S-1594

Date: 12/17/91 Job No. 91.1204
REVISED 2/4/92 AS DIRECT

