


PROJECT 3545 DATED: SEPT 25TH 1991
 FILENAME: C64/PLOT3545 SCALE 1" INCH = 20 FEET
 PLOT COORDINATE WINDOW 500 - 900 N & 180 - 440 E

PROJECT NO 3545 DATED SEPT 25TH 1991
 BUILDING SHAPE STAKED 09/24/91

PROJECT 3545 DATED: SEPT 25TH 1991
 FILENAME: C64/PLOT3545 SCALE 1" INCH = 10 FEET
 PLOT COORDINATE WINDOW 500 - 450 N & 265 - 395 E

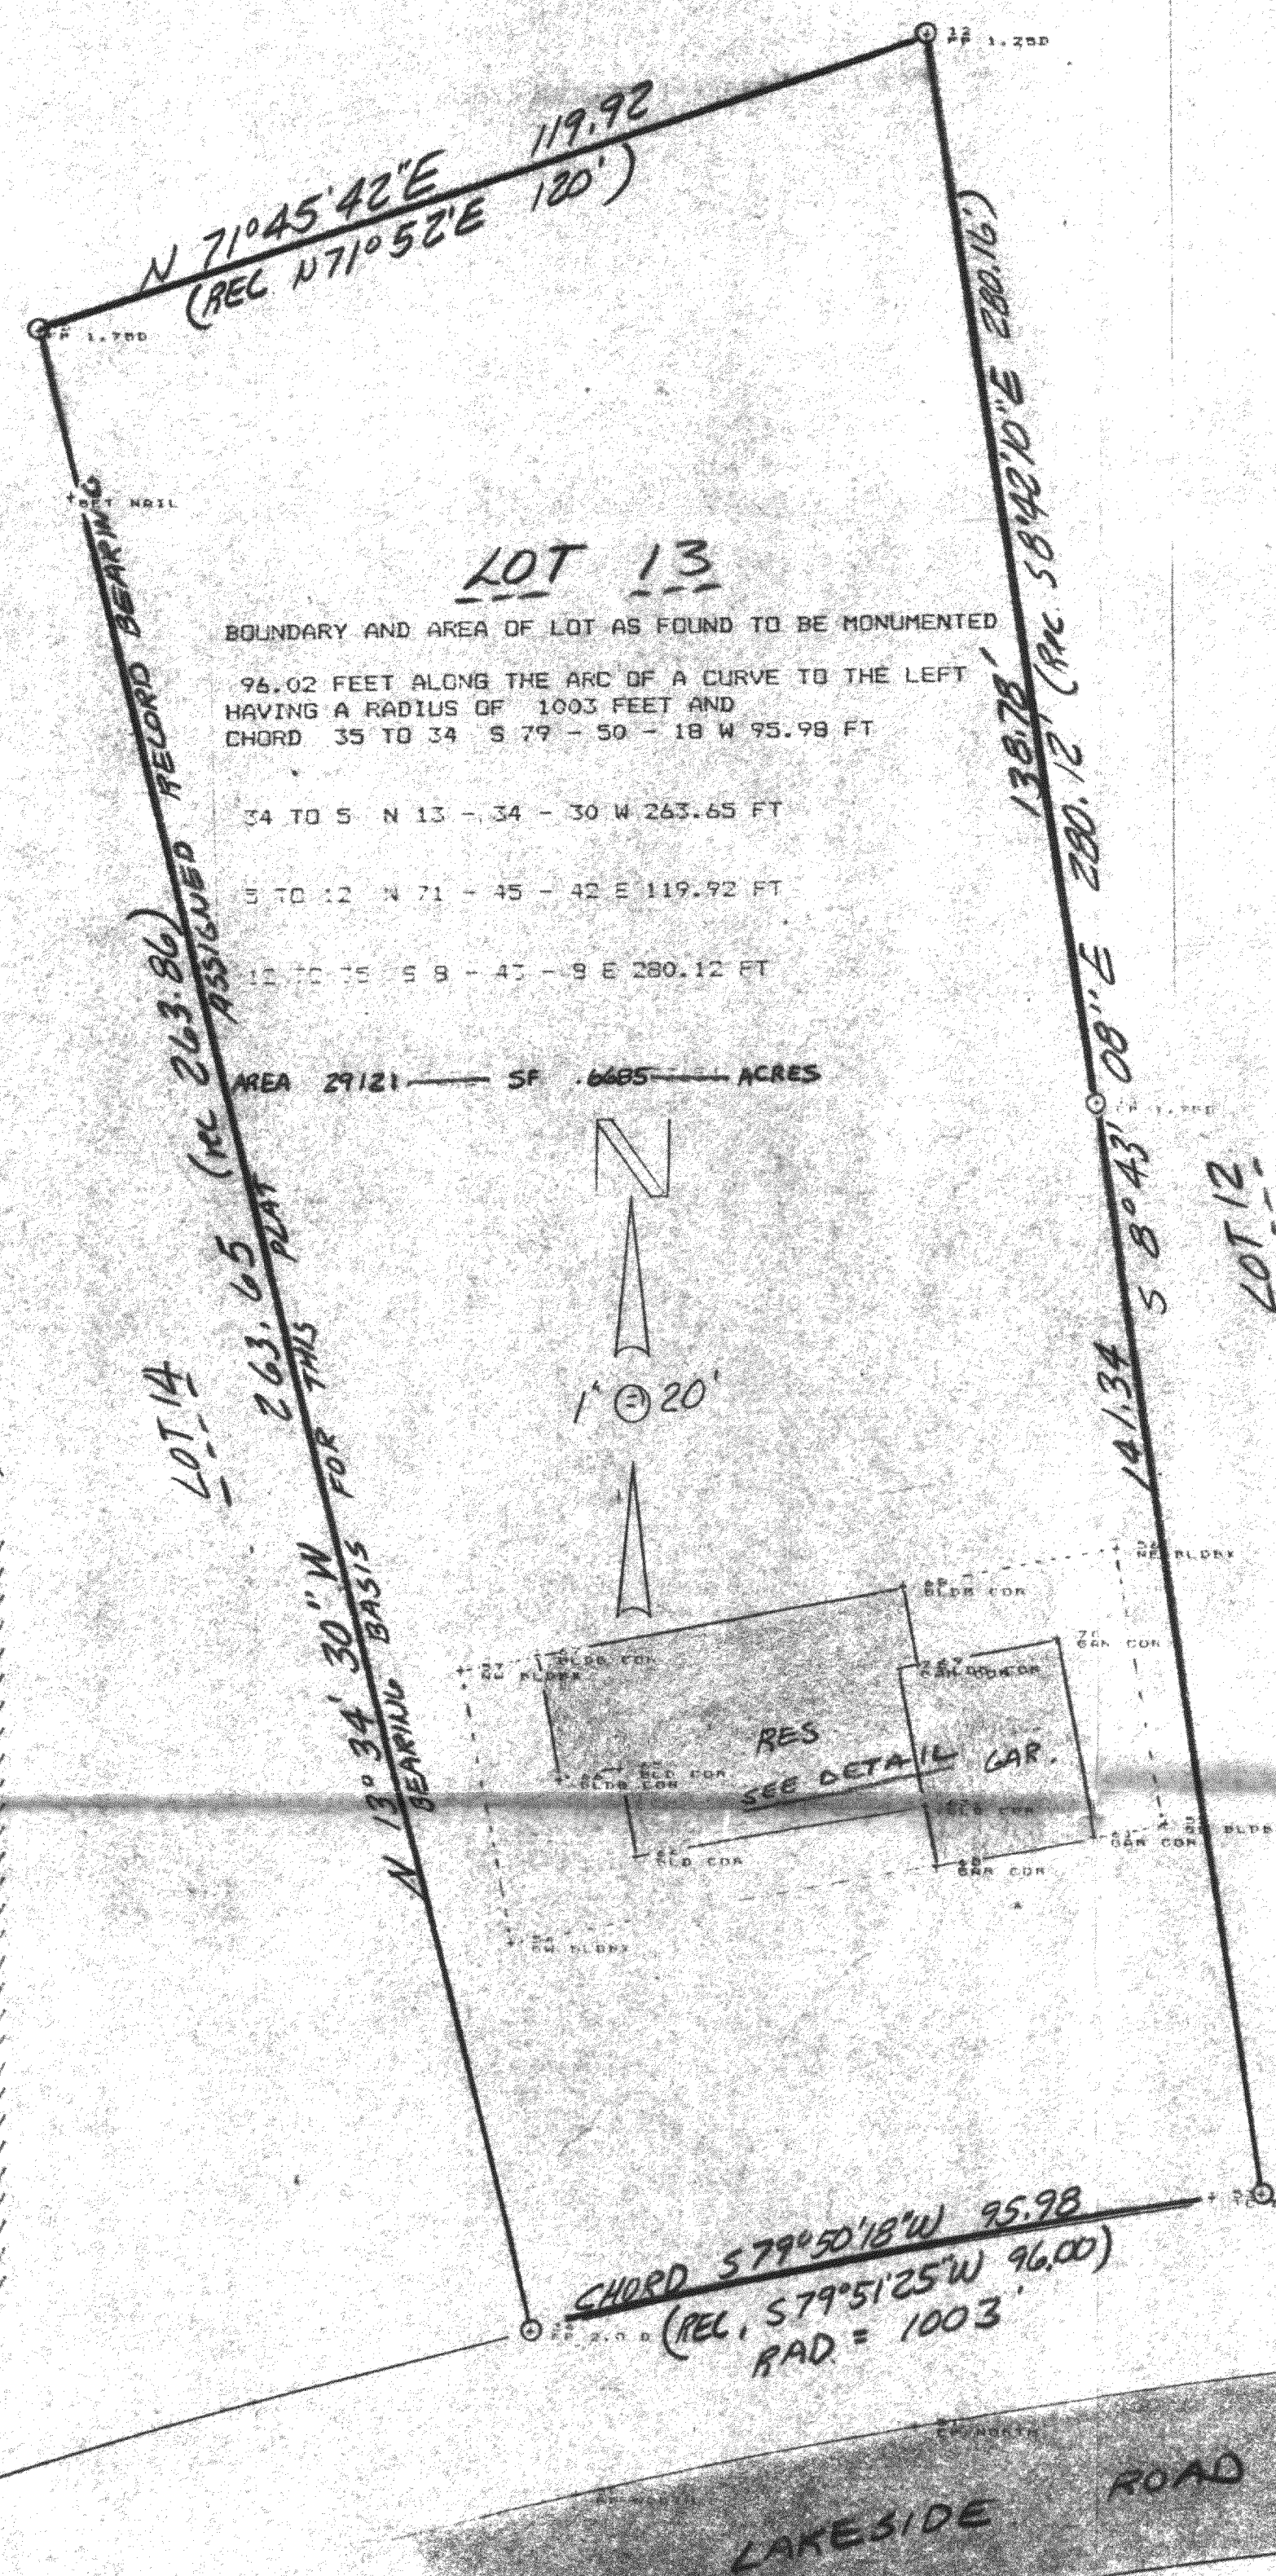


- 61 TO 62 S 79° - 50' - 21 W 20.33 FT
- 62 TO 63 N 10° - 9' - 55 W 8 FT
- 63 TO 64 S 79° - 50' - 15 W 37.67 FT
- 64 TO 65 N 10° - 9' - 39 W 12 FT
- 65 TO 66 S 79° - 50' - 26 W 8 FT
- 66 TO 67 N 10° - 9' - 44 W 16 FT
- 67 TO 68 N 79° - 50' - 20 E 48 FT
- 68 TO 69 S 10° - 9' - 37 E 10 FT
- 69 TO 70 N 79° - 50' - 15 E 18 FT
- 70 TO 61 S 10° - 9' - 40 E 26 FT

AREA 1734 SF .0398 ACRES

REF STAKES SET 09/24/91

- 51 TO 55 N 79° - 50' - 3 E 10 FT
- 52 TO 54 S 79° - 50' - 19 W 55.67 FT
- 57 TO 57 S 79° - 50' - 3 W 10 FT
- 68 TO 56 N 79° - 50' - 18 E 28 FT
- 56 TO 55 S 10° - 9' - 40 E 36 FT
- 54 TO 57 N 10° - 9' - 40 W 36 FT

XXXX = MEASUREMENTS
 TO AS BUILT
 FOUNDATION

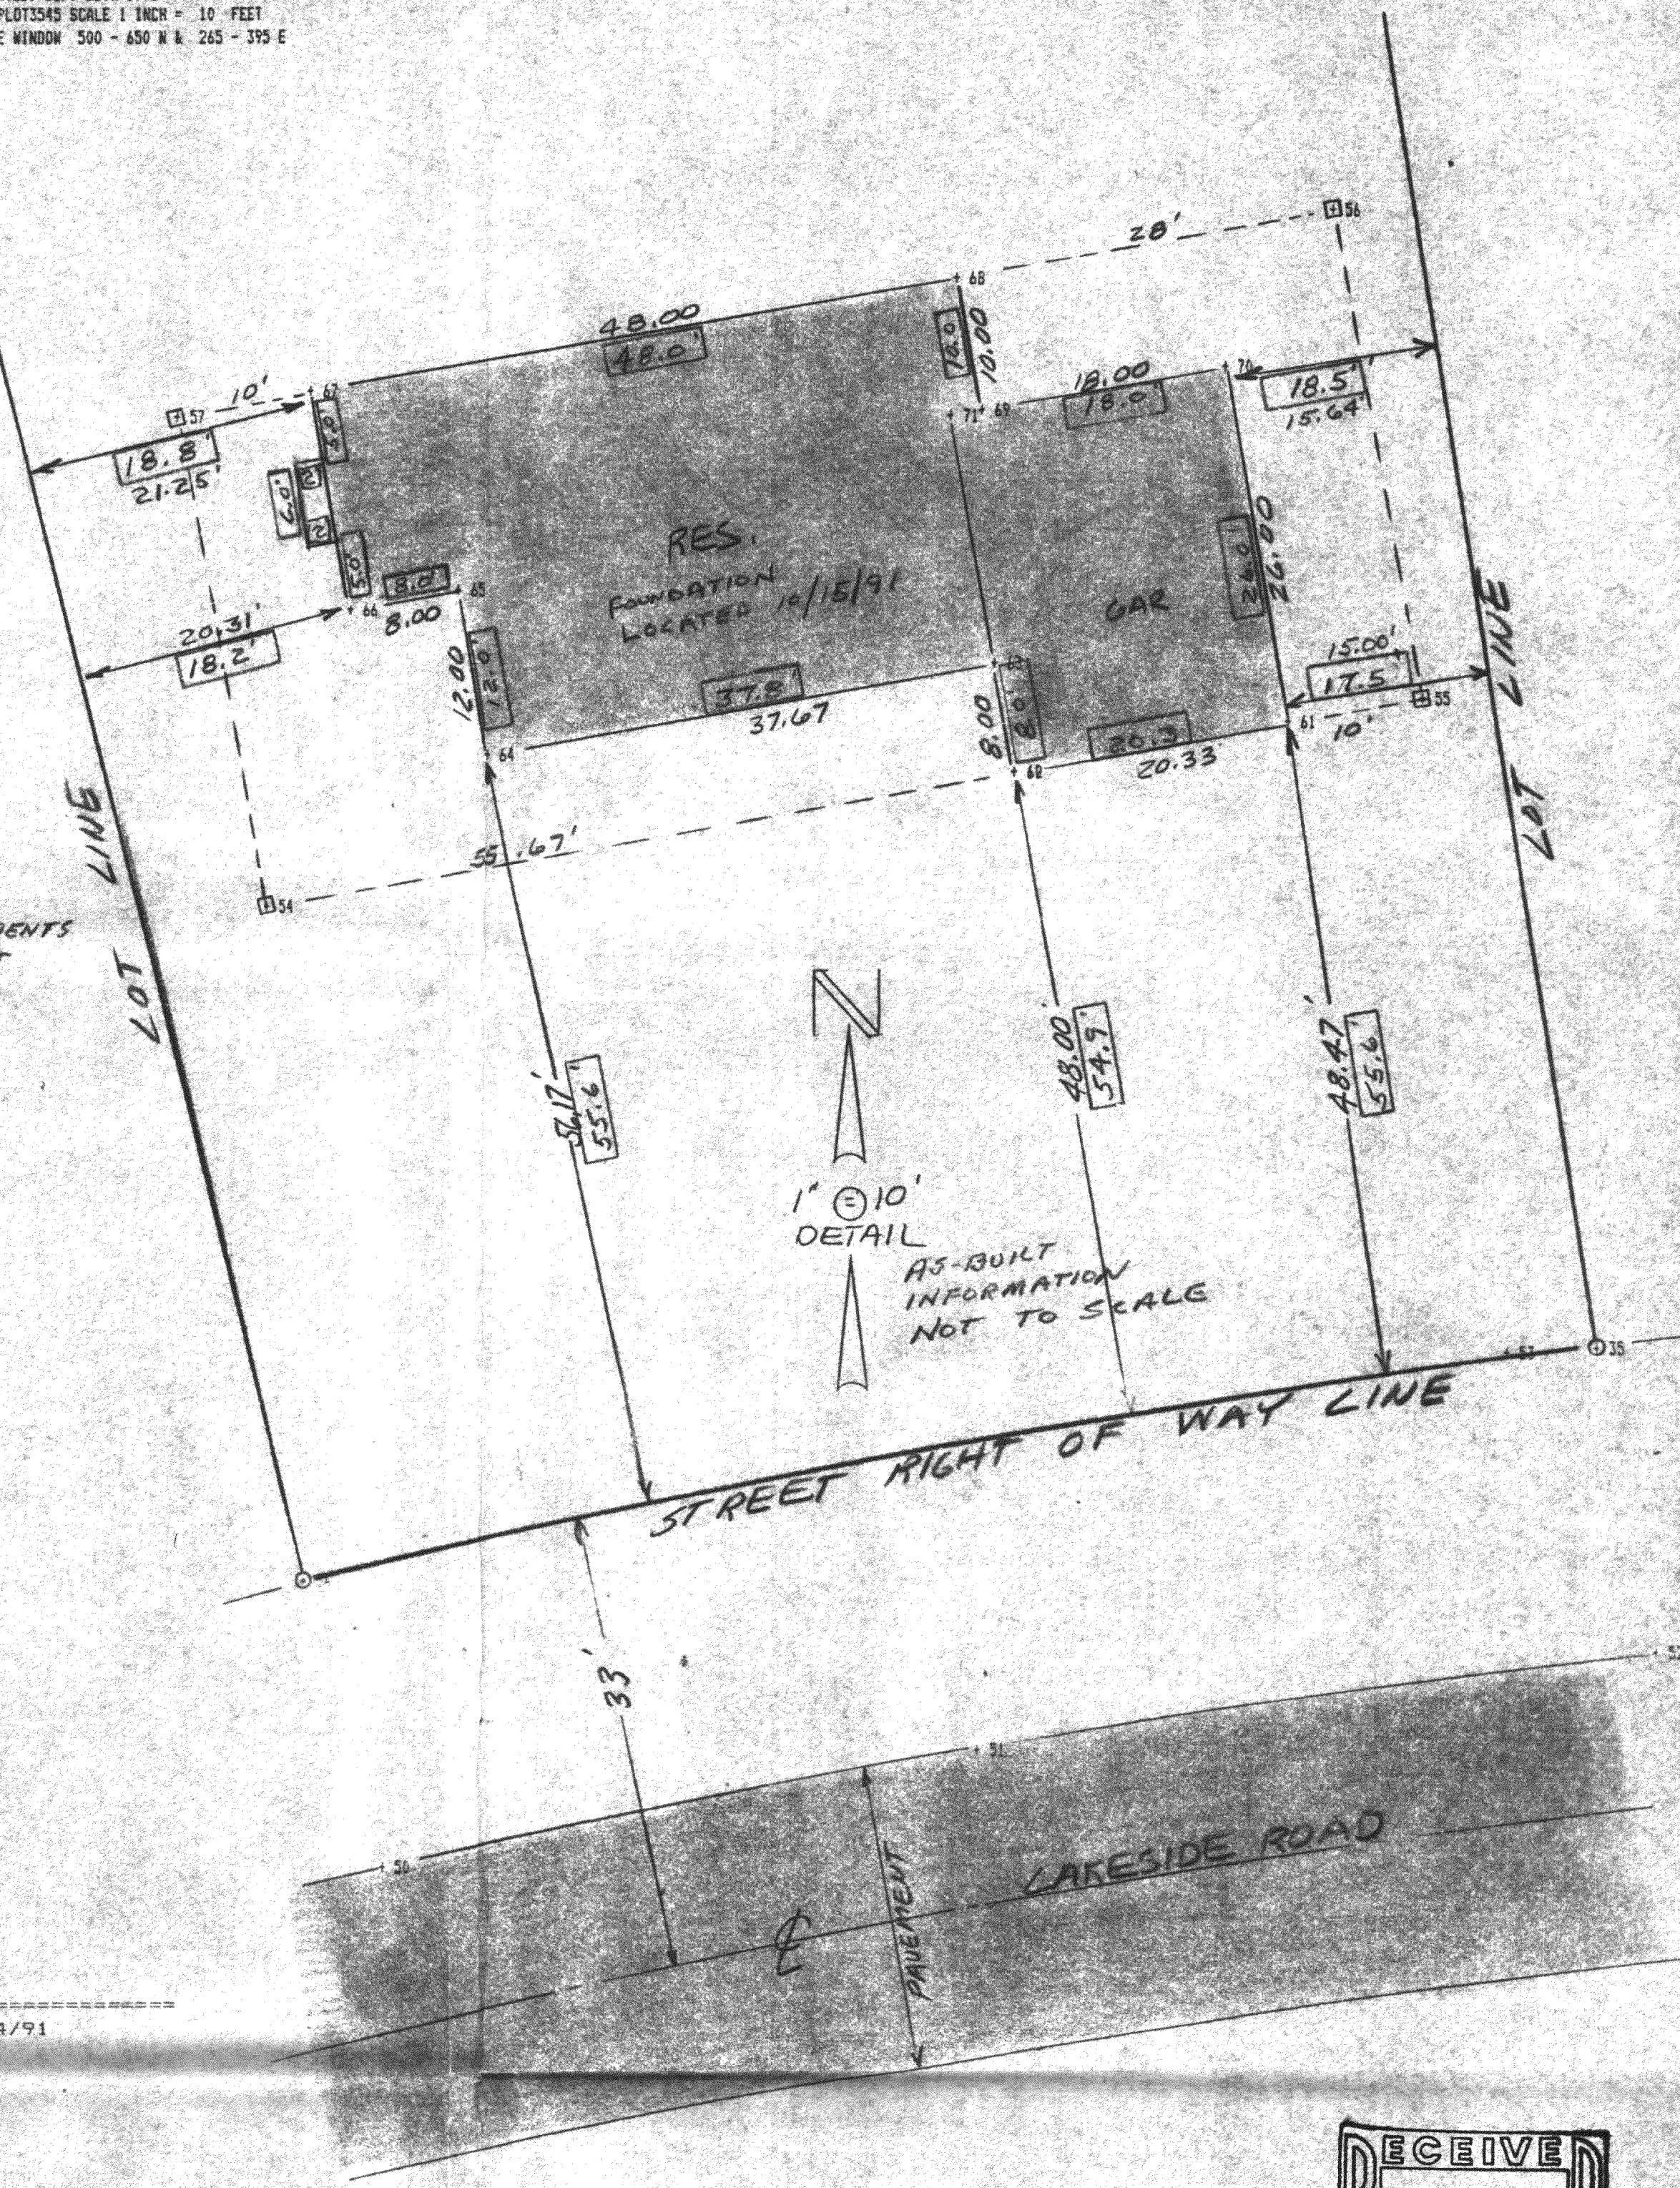

FINAL COORDINATE LIST 3545092591F1N

POINT DESCRIBED	NORTH	EAST
51	797.211	232.743
7	760.921	121.566
8	775.701	236.869
9	760.055	119.479
10	600.123	246.393
11	697.576	367.743
12	834.742	346.639
33	515.070	202.308
34	540.926	294.626
35	557.859	389.100
50	520.262	300.235
51	528.037	343.905
52	533.949	393.441
53	557.595	482.606
54	590.591	592.095
55	605.474	676.747
56	640.909	770.296
57	625.736	835.745
61	607.709	765.704
62	610.122	816.200
63	607.997	845.479
64	601.351	808.402
65	613.163	806.285
66	611.752	898.411
67	627.501	995.589
68	635.969	1042.835
69	626.126	1144.599
70	629.302	1262.317
71	625.714	1342.303

PROJECT NO 3545 DATED SEPT 25TH 1991
 OFFSETS FROM WEST PROPERTY LINE TO BUILDING STAKED 9/24/91

- 34 TO 5 346 - 25 - 30 263.65 FT FP 1.75D
- 54 STA 0 + 48.59 OFF 9.13 RT SW BLDBX
- 64 STA 0 + 55.5 OFF 27.59 RT BLD COR
- 56 STA 0 + 57.96 OFF 20.31 RT BLDG COR
- 67 STA 0 + 83.93 OFF 21.25 RT BLDG COR
- 57 STA 0 + 84.53 OFF 11.28 RT NW BLDBX
- OFFSETS FROM EAST PROPERTY LINE TO BUILDING STAKED 09/24/91
- 55 TO 12 551 - 16 - 53 280.12 FT FP 1.25D
- 61 STA 0 + 48.68 OFF 14.99 LT GAR COR
- 55 STA 0 + 48.94 OFF 5 LT SE BLDBX
- 70 STA 0 + 74.68 OFF 15.64 LT GAR COR
- 56 STA 0 + 84.93 OFF 5.9 LT NE BLDBX


- DISTANCE FROM CENTER OF STREET CURVE TO BUILDING STAKED 09/24/91
- 579 TO 61 351 - 42 - 43 1051.466 FT GAR COR 484.7
- 399 TO 62 350 - 36 - 14 1050.998 FT GAR COR 748.00
- 399 TO 64 348 - 33 - 37 1059.168 FT BLD COR 56.17

FLAT OF SURVEY OF LOT 13 OF GENEVA TERRITORY
 FIRST ADDITION LOCATED IN THE SOUTHEAST 1/4 OF
 SECTION 29, TOWN 2 NORTH, RANGE 18 EAST,
 WALWORTH COUNTY, WISCONSIN


WORK ORDERED BY: THELEN TOTAL CONSTRUCTION

NOTE: COPIES OF THIS MAP TO WHICH THE FOLLOWING CERTIFICATE WILL APPLY ARE BLUE LINE PRINTS SHOWING SURVEYOR'S
 ORIGINAL SEAL AND SIGNATURE IN BLACK INK. COPIES BY ANY OTHER MEANS MAY HAVE ALTERATIONS WHICH DO NOT
 REPRESENT THE SURVEYOR'S WORK PRODUCT.

I HEREBY CERTIFY THAT THE ABOVE DESCRIBED PROPERTY HAS BEEN SURVEYED UNDER MY DIRECTION AND THAT THE ABOVE MAP IS A
 TRUE REPRESENTATION THEREOF AND SHOWS THE SIZE AND LOCATION OF THE PROPERTY AND ITS EXTERIOR BOUNDARIES. THIS SURVEY
 IS MADE FOR THE USE OF THE PRESENT OWNERS OF THE PROPERTY, AND ALSO THOSE WHO PURCHASE, MORTGAGE, OR GUARANTEE
 THE TITLE THERETO WITHIN ONE YEAR FROM THE DATE HEREOF.

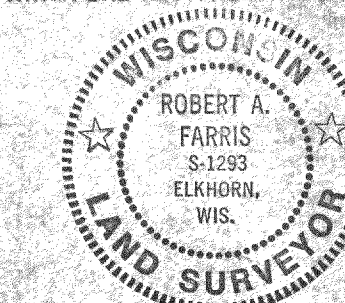

REVISOR 10-16-91 TO SHOW
 AS BUILT INFORMATION

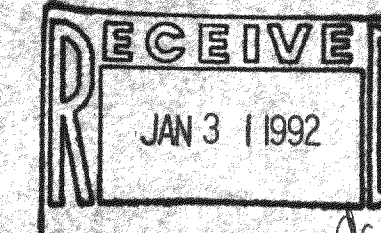

PLAT OF SURVEY OF LOT 13 OF GENEVA TERRITORY
 FIRST ADDITION LOCATED IN THE SOUTHEAST 1/4
 OF SECTION 29, TOWN 2 NORTH, RANGE 18 EAST,
 WALWORTH COUNTY, WISCONSIN

FARRIS, HANSEN & ASSOCIATES, INC.
 Engineering, Architecture, Surveying
 7 Ridgway Court P.O. Box 437
 ELKHORN, WISCONSIN 53121
 Office: (414) 723-2098
 Fax: (414) 723-5986

REVISIONS
 10-16-91
 SHOW AS BUILT
 MEASUREMENTS

PROJECT NO
 3545
 DATE
 9/25/91
 SHEET NO.
 1 of 1