

34

(N63°19'30"E 235.59')

235.52'

10' WIDE UTILITY EASEMENT

73°38'45"

(N10°38'15"W 145.00')

CH=144.78'

R=201.00'

33

96°24'15"

(S20°12'33"W 85.48')

85.53'

109°06'00"

201.13'

(N88°53'15"E 201.21')

32

35

DECK

RESIDENCE

GRAVEL DRIVEWAY

10.53'

R=1083.00'

CH=40.11'

(N9°26'40"E 40.11')


159°56'35"

DEERPETH ROAD

PLAT OF SURVEY OF

LOT 33 OF GENEVA TERRITORY FIRST ADDITION, LOCATED IN SECTIONS 28, 29, 32 AND 33, T 2 N, R 18 E, WALWORTH COUNTY, WISCONSIN.

ORDERED BY: REMAX LAKE GENEVA
P. O. BOX 955
WILLIAMS BAY, WISCONSIN
53191

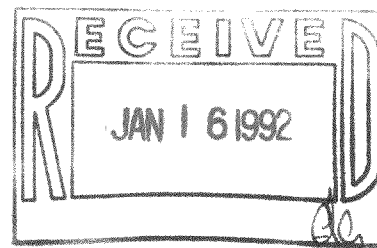

I HEREBY CERTIFY THAT I HAVE SURVEYED THE ABOVE DESCRIBED PROPERTY AND THAT THE ABOVE MAP IS A TRUE REPRESENTATION THEREOF AND SHOWS THE SIZE AND LOCATION OF THE PROPERTY, ITS EXTERIOR BOUNDARIES, THE LOCATION OF ALL VISIBLE STRUCTURES AND DIMENSIONS OF ALL PRINCIPAL BUILDINGS THEREON, BOUNDARY FENCES, APPARENT EASEMENTS, ROADWAYS AND VISIBLE ENCROACHMENTS, IF ANY, TO THE BEST OF MY KNOWLEDGE AND BELIEF.

THIS SURVEY IS MADE FOR THE USE OF THE PRESENT OWNERS OF THE PROPERTY AND ALSO THOSE WHO PURCHASE, MORTGAGE OR GUARANTEE THE TITLE THERETO WITHIN ONE (1) YEAR FROM DATE HEREOF.

HEREOF.

Robert M. Baerenwald

ROBERT M. BAERENWALD
WISCONSIN REGISTERED LAND SURVEYOR, S-1508

DATE April 30, 1991 JOB NO. 2890

NOTE: THIS IS NOT A CERTIFIED COPY UNLESS SEALED.

GRAPHIC SCALE



(IN FEET)
1 inch = 40 ft.

Ø-IRON PIPE FOUND
Ø-IRON ROD FOUND
●-CONCRETE MONUMENT FOUND
O-IRON PIPE PLACED
()-RECORDED AS

218-581

NDA 1-22