


KOLB LAND CONSULTING, INC.
LAND SURVEYING • SUBDIVIDING • LAND PLANNING

LAKE GENEVA, WISCONSIN 53147

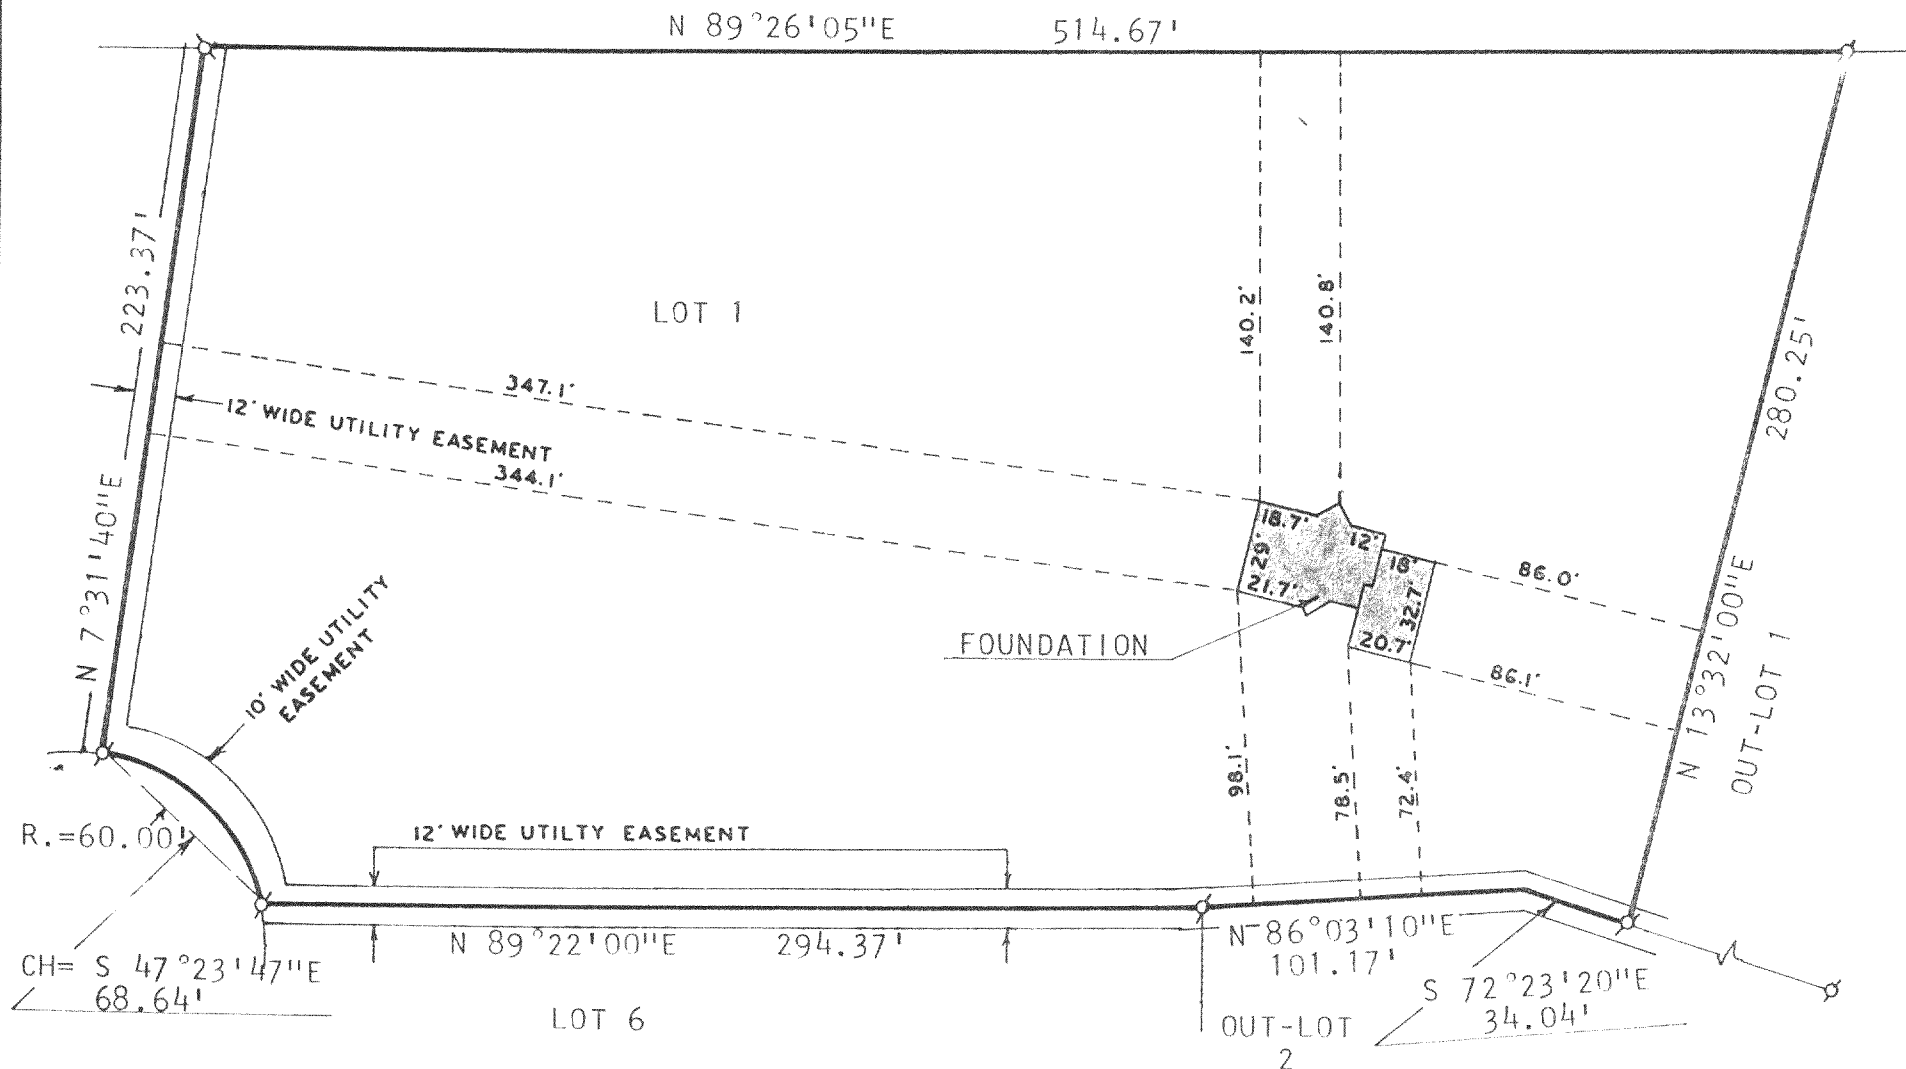


PLAT OF SURVEY OF
FOUNDATION LOCATION
ON

LOT 1 OF HEATHERIDGE SUBDIVISION LOCATED IN THE SOUTHWEST
1/4 OF SECTION 18, T2N, R18E, TOWN OF LYONS, WALWORTH
COUNTY, WISCONSIN.

ORDERED BY: NILES MCMASTER
3208 S. ALPINE ROAD
ROCKFORD, IL. 61109-2603


NOTE: BEARINGS ARE ASSUMED AS SHOWN ON
RECORDED SUBDIVISION PLAT.

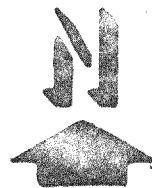

SCALE: 1"= 60'

LEGEND

x - IRON PIPE FOUND

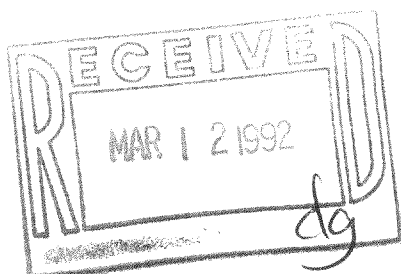

I, HAROLD H. KOLB, DO HEREBY CERTIFY
THAT I HAVE SURVEYED THE PROPERTY
HEREON DESCRIBED ACCORDING TO THE
OFFICIAL RECORDS AND THAT THE PLAT
HEREON IS A CORRECT REPRESENTATION
OF THE LOT LINES AND PRINCIPAL LINES
OF THE FOUNDATION TO THE BEST OF MY
KNOWLEDGE AND BELIEF.
SURVEY NOT VALID UNLESS SURVEYOR'S
SIGNATURE IS IN RED.

HAROLD H. KOLB
WISCONSIN REGISTERED LAND SURVEYOR, S-187
DATE JUNE 6, 1990