

WALWORTH COUNTY
SURVEYING & MAPPING
727 HENRY STREET
LAKE GENEVA, WISCONSIN
414-248-0505

LOT 10

(N89°55'45"E 733.15')
733.40'

90.00'

120.00'

200.00'

323.40'

LOT 11

100.00'

100.00'

100.00'

140.00'

294.94'

734.94'
(N89°53'30"E 734.80')

LOT 12

PLAT OF SURVEY OF

GRAPHIC SCALE




(IN FEET)

1 inch = 60 ft.

Ø-IRON PIPE FOUND
Ø-IRON ROD FOUND
■-CONCRETE MONUMENT FOUND
○-IRON PIPE PLACED
()-RECORDED AS

EXTRA MONUMENTATION PLACED ALONG THE NORTHERLY
AND SOUTHERLY LINES OF LOT 11 OF PARTRIDGE WOODS,
LOCATED IN SECTION 23, T 2 N, R 18 E, WALWORTH
COUNTY, WISCONSIN.

ORDERED BY: KAVANAUGH REALTY
RT. 5, BOX 453
LAKE GENEVA, WISCONSIN 53147

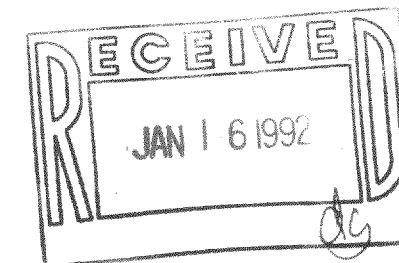

I HEREBY CERTIFY THAT I HAVE SURVEYED THE ABOVE
DESCRIBED PROPERTY AND THAT THIS PLAT IS A CORRECT
REPRESENTATION THEREOF TO THE BEST OF MY KNOWLEDGE
AND BELIEF.

Robert M. Baerenwald
ROBERT M. BAERENWALD
WISCONSIN REGISTERED LAND SURVEYOR, S-1508

March 22, 1991
DATE JOB NO. 2842