




KOLB LAND CONSULTING, INC.
LAND SURVEYING • SUBDIVIDING • LAND PLANNING

929 WILLIAMS STREET LAKE GENEVA, WISCONSIN 53147 414 248 3697

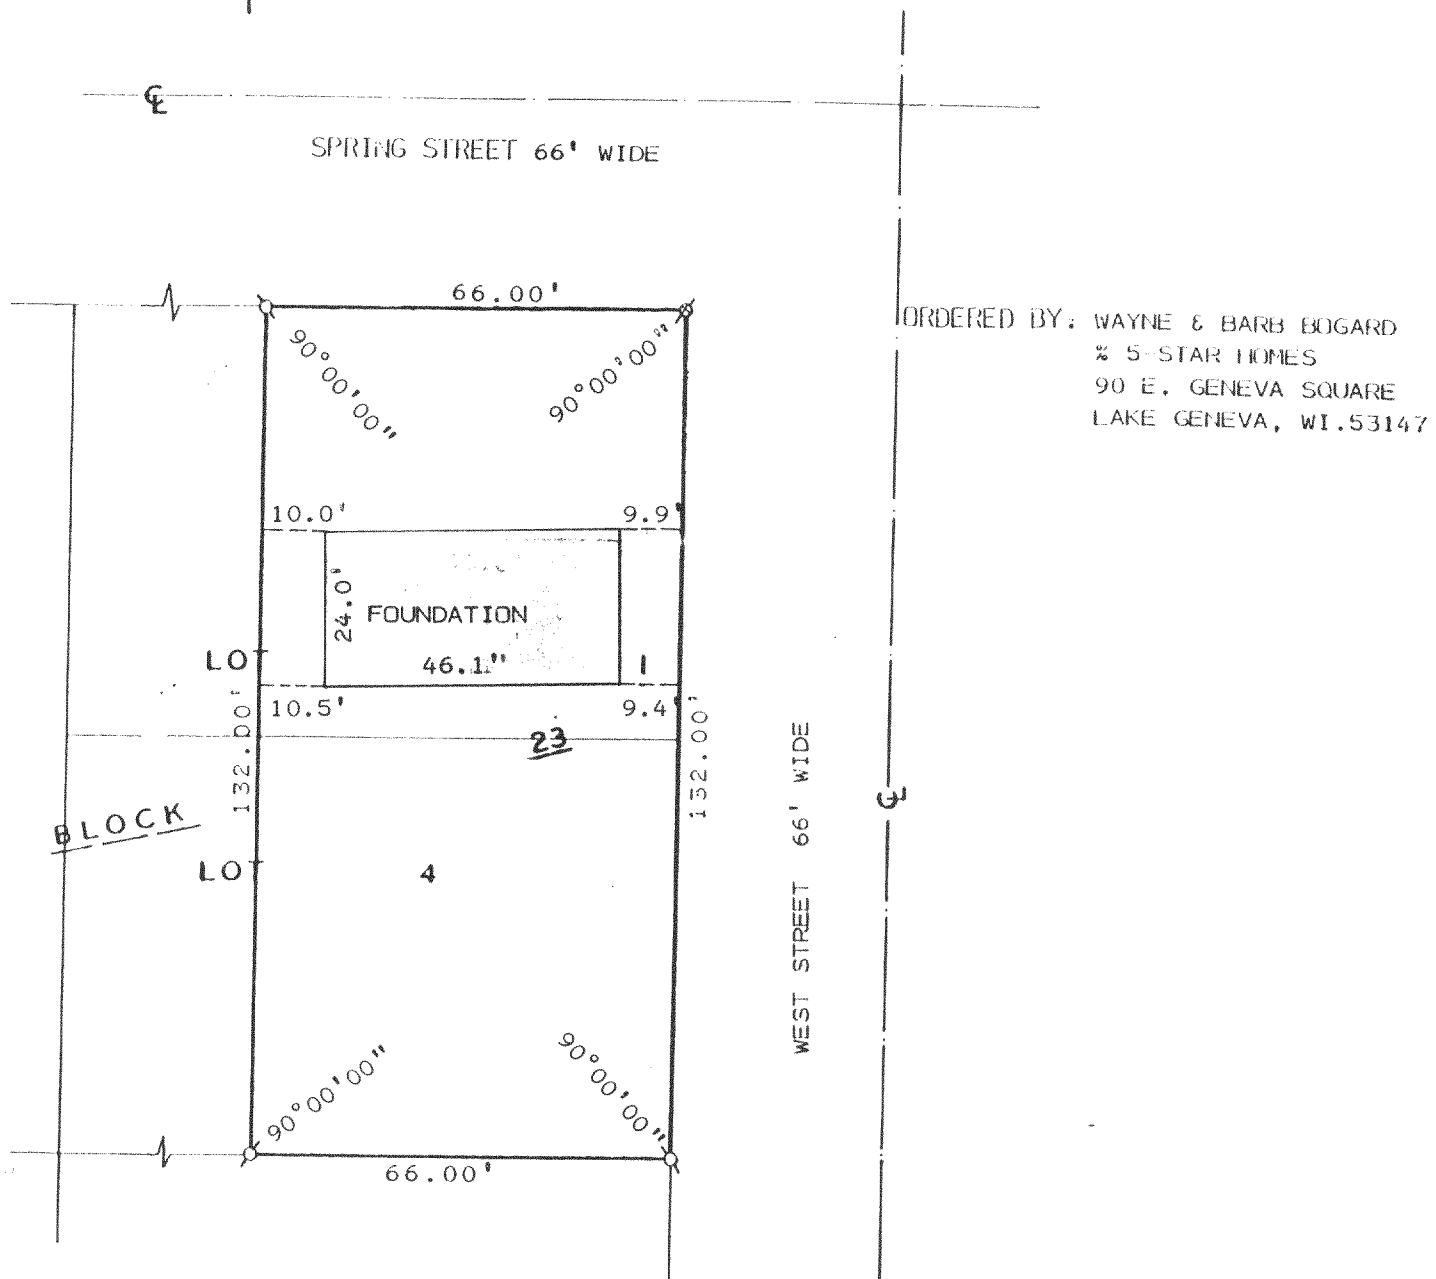

PLAT OF SURVEY OF

A FOUNDATION LOCATION ON THE EAST 1/2 OF LOTS 1 & 4,
BLOCK 23 OF THE MAP OF SPRINGFIELD, LOCATED IN SECTION
7, T2N, R18E, TOWN OF LYONS, WALWORTH COUNTY, WISCONSIN.

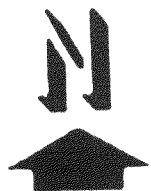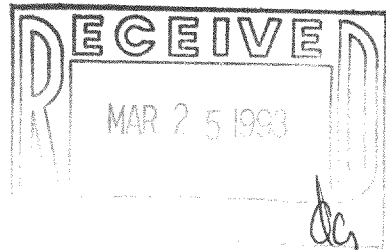

SCALE: 1" = 30'
LEGEND

Ø - IRON PIPE FOUND
Ø - FOUND SPIKE IN TREE

I, HAROLD H. KOLB, DO HEREBY CERTIFY THAT I
HAVE SURVEYED THE PROPERTY HEREON DESCRIBED
ACCORDING TO THE OFFICIAL RECORDS, AND THAT
THE PLAT HEREON IS A CORRECT REPRESENTATION
OF THE LOT LINES TO THE BEST OF MY KNOWLEDGE
AND BELIEF. THIS SURVEY IS NOT VALID UNLESS
THE SURVEYOR'S SIGNATURE IS IN RED.

HAROLD H. KOLB

WISCONSIN REGISTERED LAND SURVEYOR, S 187

DATE NOV. 5, 1992


REVISED DECEMBER 30, 1992

REVISED 218-647

NYS-58

KOLB LAND CONSULTING, INC.
LAND SURVEYING • SUBDIVIDING • LAND PLANNING



929 WILLIAMS STREET LAKE GENEVA, WISCONSIN 53147 414-248-3697

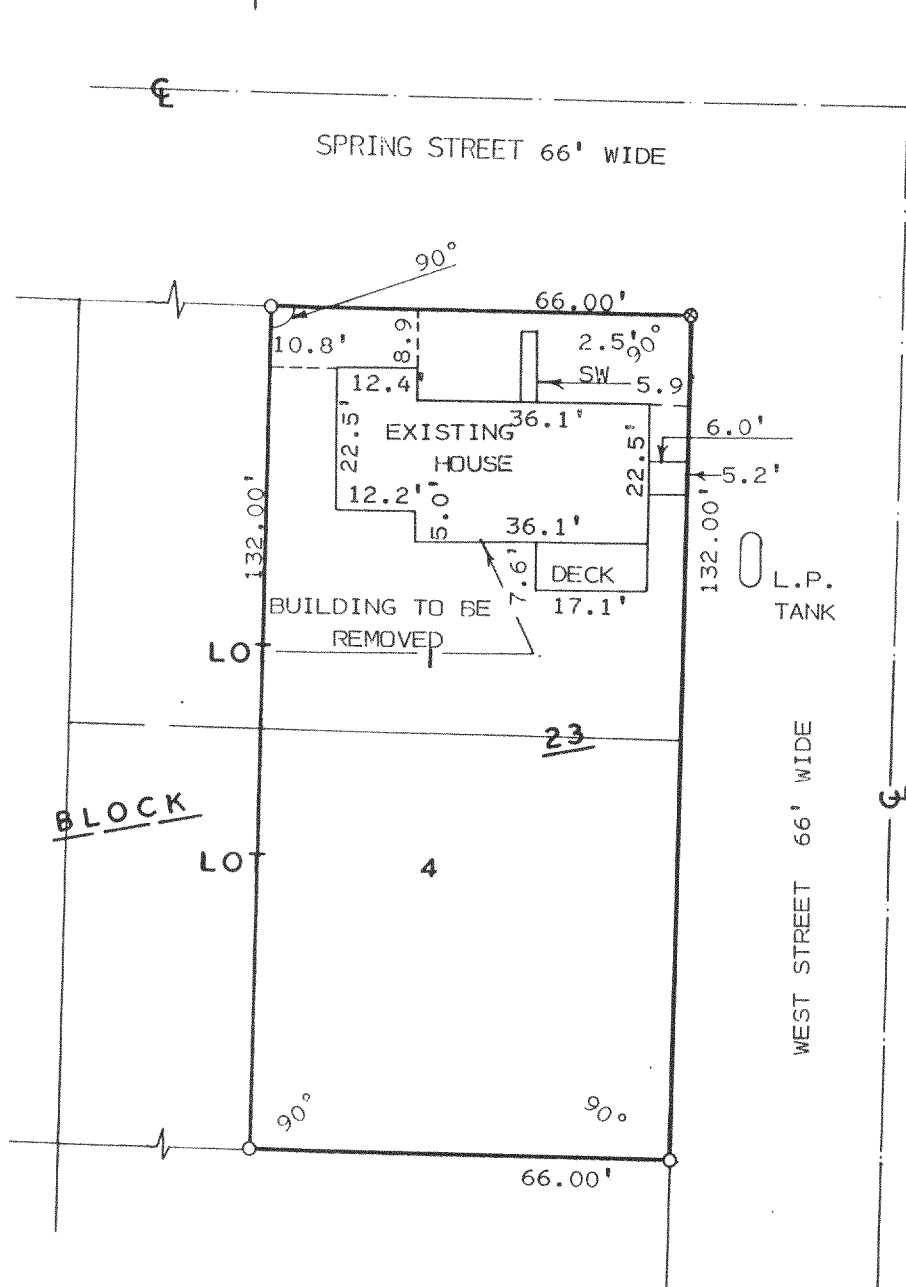

ORDERED BY: WAYNE & BARB BOGARD
% 5-STAR HOMES
90 E. GENEVA SQUARE
LAKE GENEVA, WI. 53147

PLAT OF SURVEY OF

THE EAST 1/2 OF LOTS 1 AND 4, BLOCK 23 OF
THE MAP OF SPRINGFIELD, LOCATED IN SECTION
7, T2N, R18E, TOWN OF LYONS, WALWORTH COUNTY,
WISCONSIN.

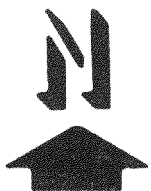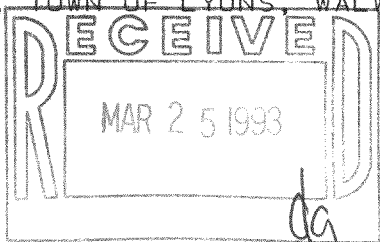

SCALE: 1" = 30'
LEGEND

- O - IRON PIPE SET
- SW - SIDEWALK
- ⊗ - SET SPIKE IN TREE

I, HAROLD H. KOLB, DO HEREBY CERTIFY THAT I
HAVE SURVEYED THE PROPERTY HEREON DESCRIBED
ACCORDING TO THE OFFICIAL RECORDS, AND THAT
THE PLAT HEREON IS A CORRECT REPRESENTATION
OF THE LOT LINES TO THE BEST OF MY KNOWLEDGE
AND BELIEF. THIS SURVEY IS NOT VALID UNLESS
THE SURVEYOR'S SIGNATURE IS IN RED.

HAROLD H. KOLB

WISCONSIN REGISTERED LAND SURVEYOR, S-187


DATE SEPTEMBER 22, 1992

REVISED

REVISED

KOLB LAND CONSULTING, INC.
LAND SURVEYING • SUBDIVIDING • LAND PLANNING



929 WILLIAMS STREET LAKE GENEVA, WISCONSIN 53147 414 248-3697

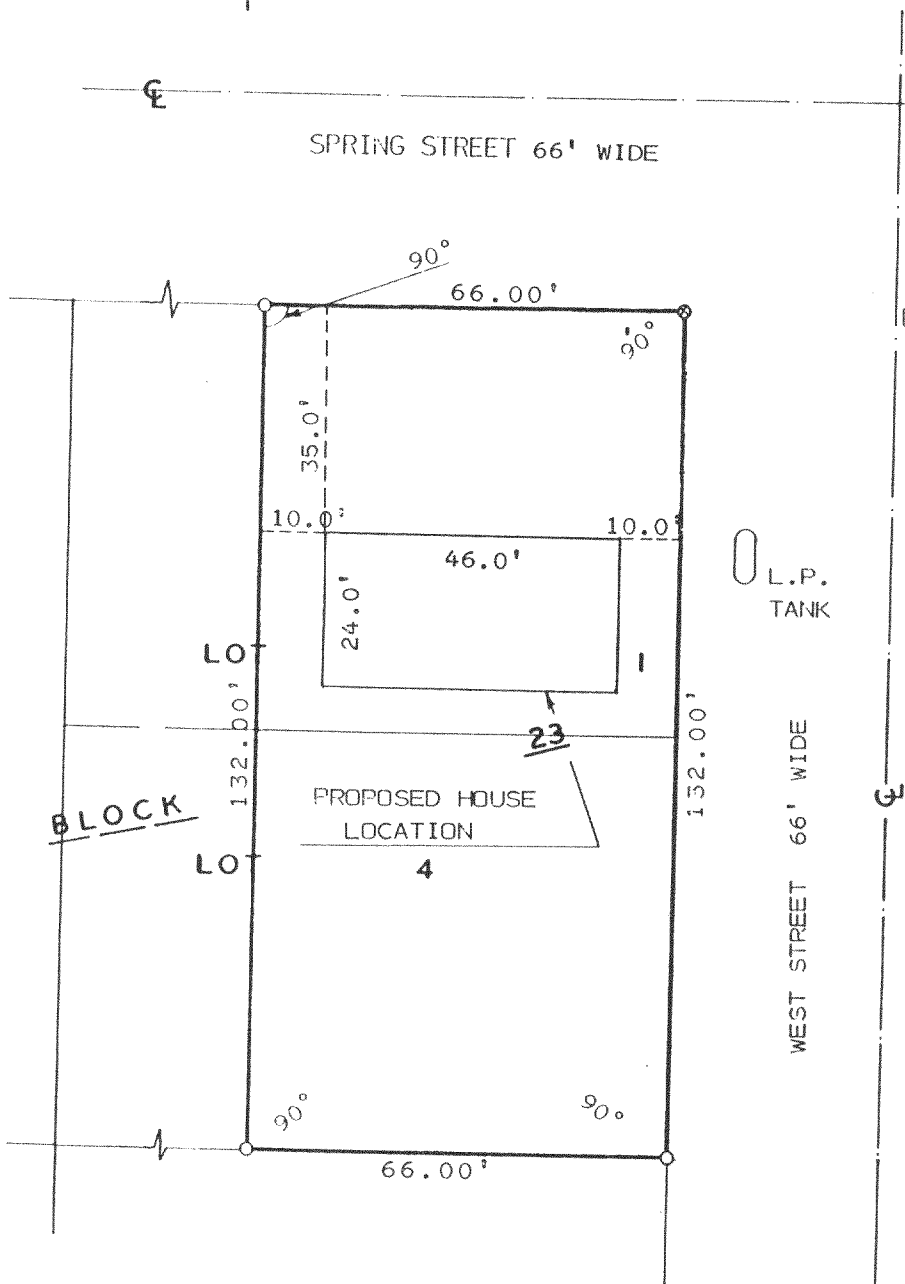

ORDERED BY: WAYNE & BARB BOGARD
% 5-STAR HOMES
90 E. GENEVA SQUARE
LAKE GENEVA, WI. 53147

PLAT OF SURVEY OF

A PROPOSED HOUSE LOCATION ON THE EAST 1/2 OF LOTS
1 AND 4, BLOCK 23 OF THE MAP OF SPRINGFIELD, LOCATED
IN SECTION 7, T2N, R18E, TOWN OF LYONS, WALWORTH
COUNTY, WISCONSIN.

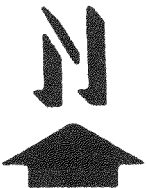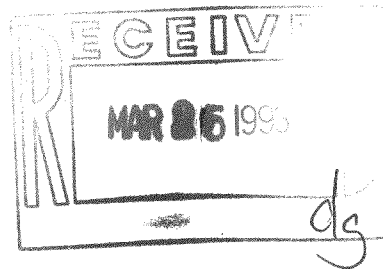

SCALE: 1" = 30'
LEGEND

- O - IRON PIPE SET
- SW - SIDEWALK
- ⊗ - SET SPIKE IN TREE

I, HAROLD H. KOLB, DO HEREBY CERTIFY THAT I
HAVE SURVEYED THE PROPERTY HEREON DESCRIBED
ACCORDING TO THE OFFICIAL RECORDS, AND THAT
THE PLAT HEREON IS A CORRECT REPRESENTATION
OF THE LOT LINES TO THE BEST OF MY KNOWLEDGE
AND BELIEF. THIS SURVEY IS NOT VALID UNLESS
THE SURVEYOR'S SIGNATURE IS IN RED.

HAROLD H. KOLB

WISCONSIN REGISTERED LAND SURVEYOR, S-187

DATE NOV. 5, 1992

REVISED

REVISED

218-647

NVS-58