

PLAT OF SURVEY
OF

LOT 5, OF ZACCARD'S SPRING VALLEY ESTATES, A SUBDIVISION LOCATED IN SECTIONS 11 & 14, T. 2 N., R. 18 E. OF THE 4TH P.M., TOWNSHIP OF LYONS,
WALWORTH COUNTY, WISCONSIN.

FOR: ZACCARD

SCALE 1" = 60'

o = IRON PIPE STAKE

BEARINGS REFER TO RECORDED PLAT DATUM

E 830.9 IS SOIL TEST ELEVATION
ON TOP OF LOT PIPE

DATE OF PLAT 5-24-93

DATE OF FIELD SURVEY 10-7-91

I have surveyed the above-described property,
and the map hereon is a true representation
thereof and shows the size and location of the
property, its exterior boundaries, the location
and dimensions of all visible structures thereon,
fences, apparent easements and roadways and
visible encroachments, if any.



This survey is made for the exclusive use of
the present owners of the property, and also
those who purchase, mortgage, or guarantee
the title thereto, within one year from date
hereof.

Dated at Burlington, this 24th day,
of May, 1993

John F. Degen

John F. Degen, Land Surveyor 9242
589 N. Pine St. Burlington, WI 53105

CORRECTION 5-28-93

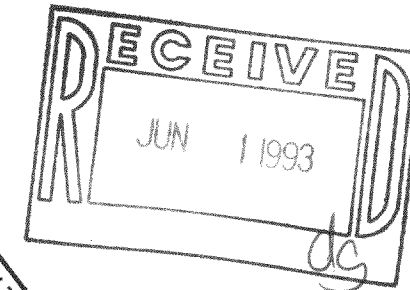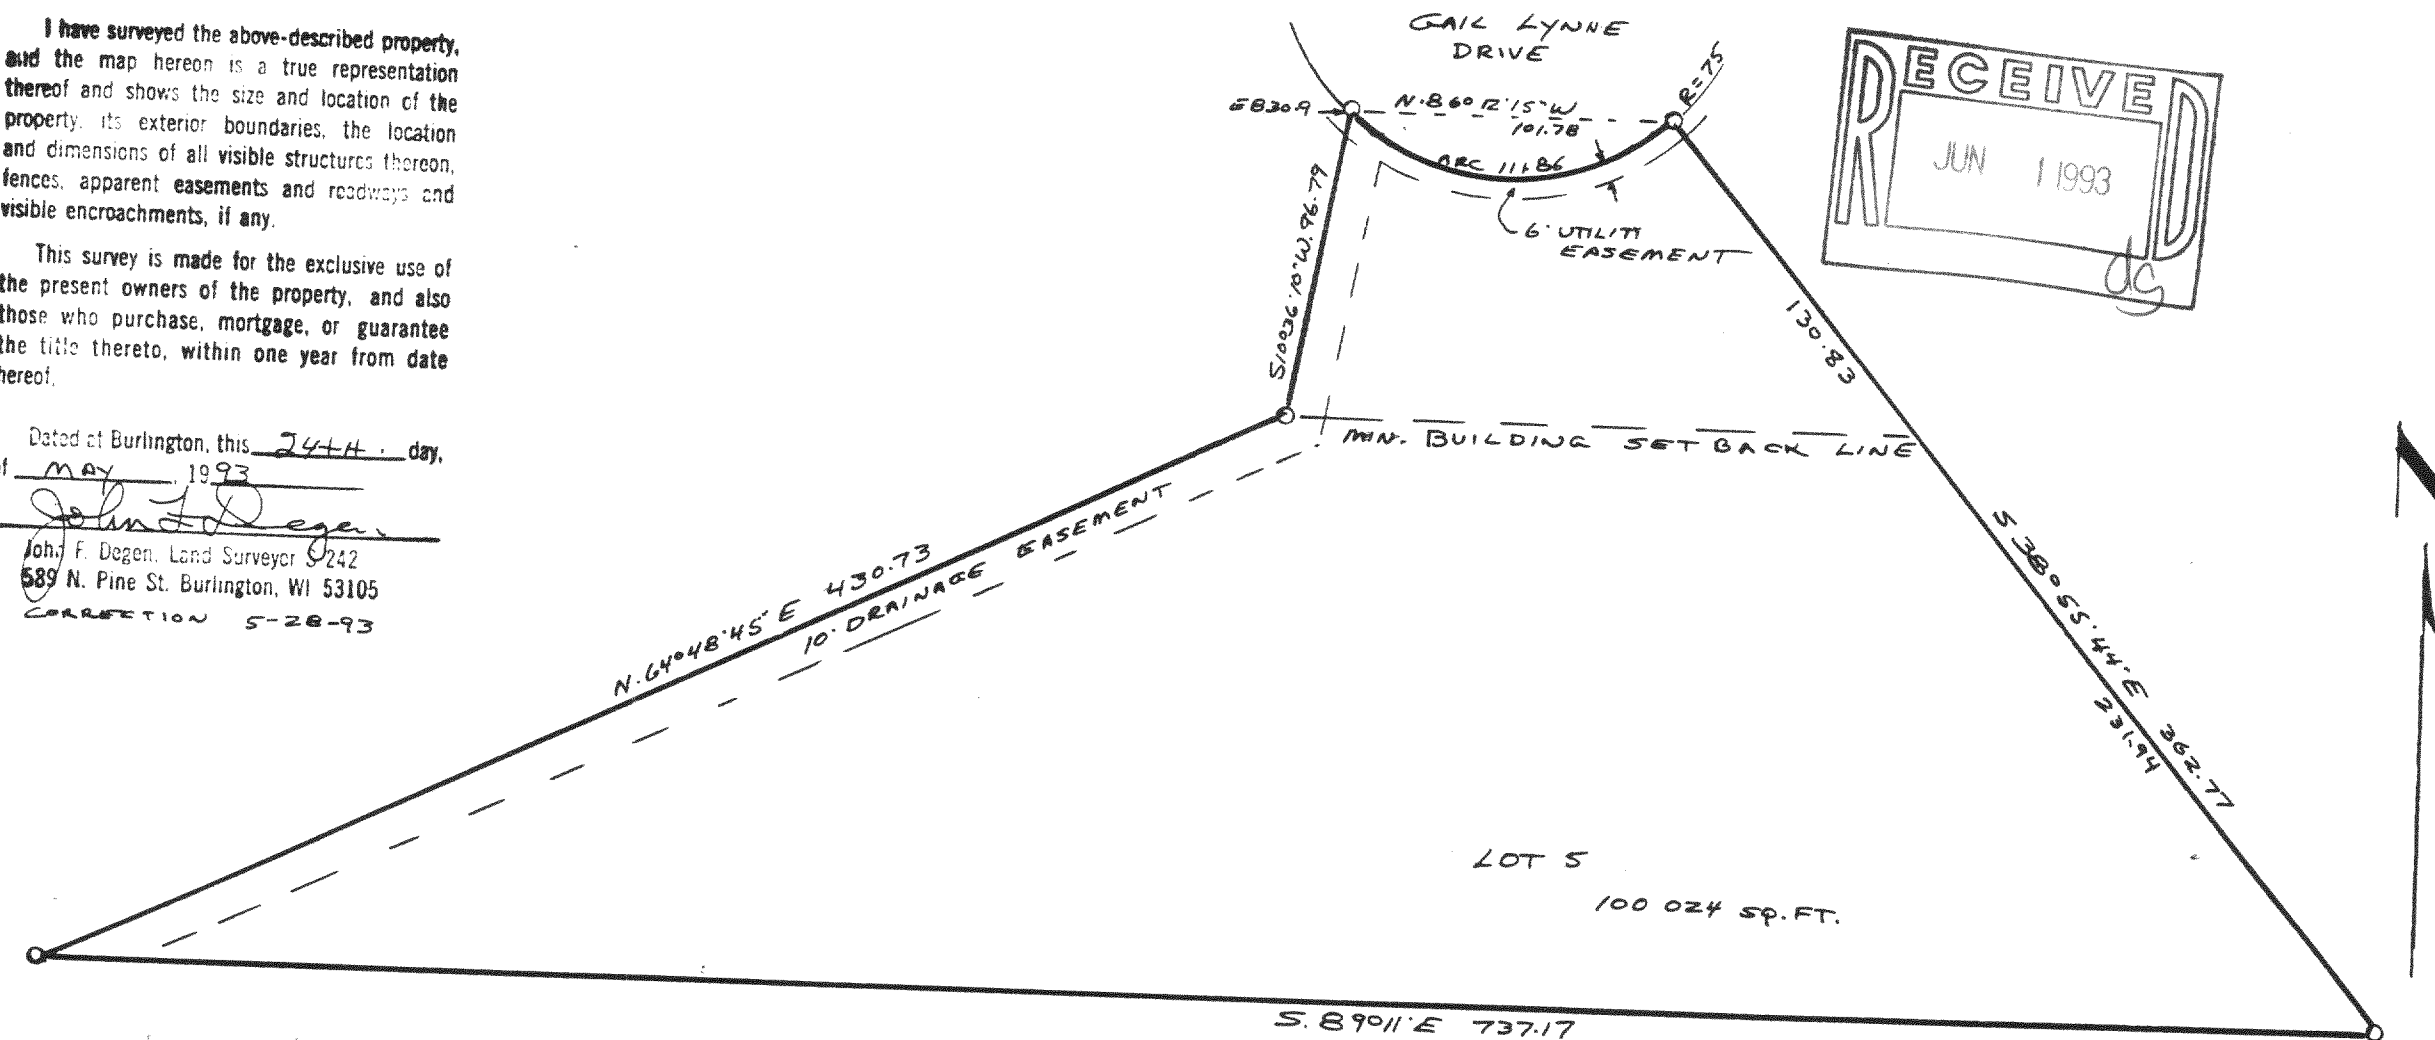

NZA-5

218-668 19-C #33