


PLAT OF SURVEY

LOT 9 IN PARTRIDGE WOODS
A SUBDIVISION LOCATED IN THE NE 1/4, SE 1/4, & SW 1/4
SECTION 23, TOWN 2 NORTH, RANGE 18 EAST
WALWORTH COUNTY, WISCONSIN

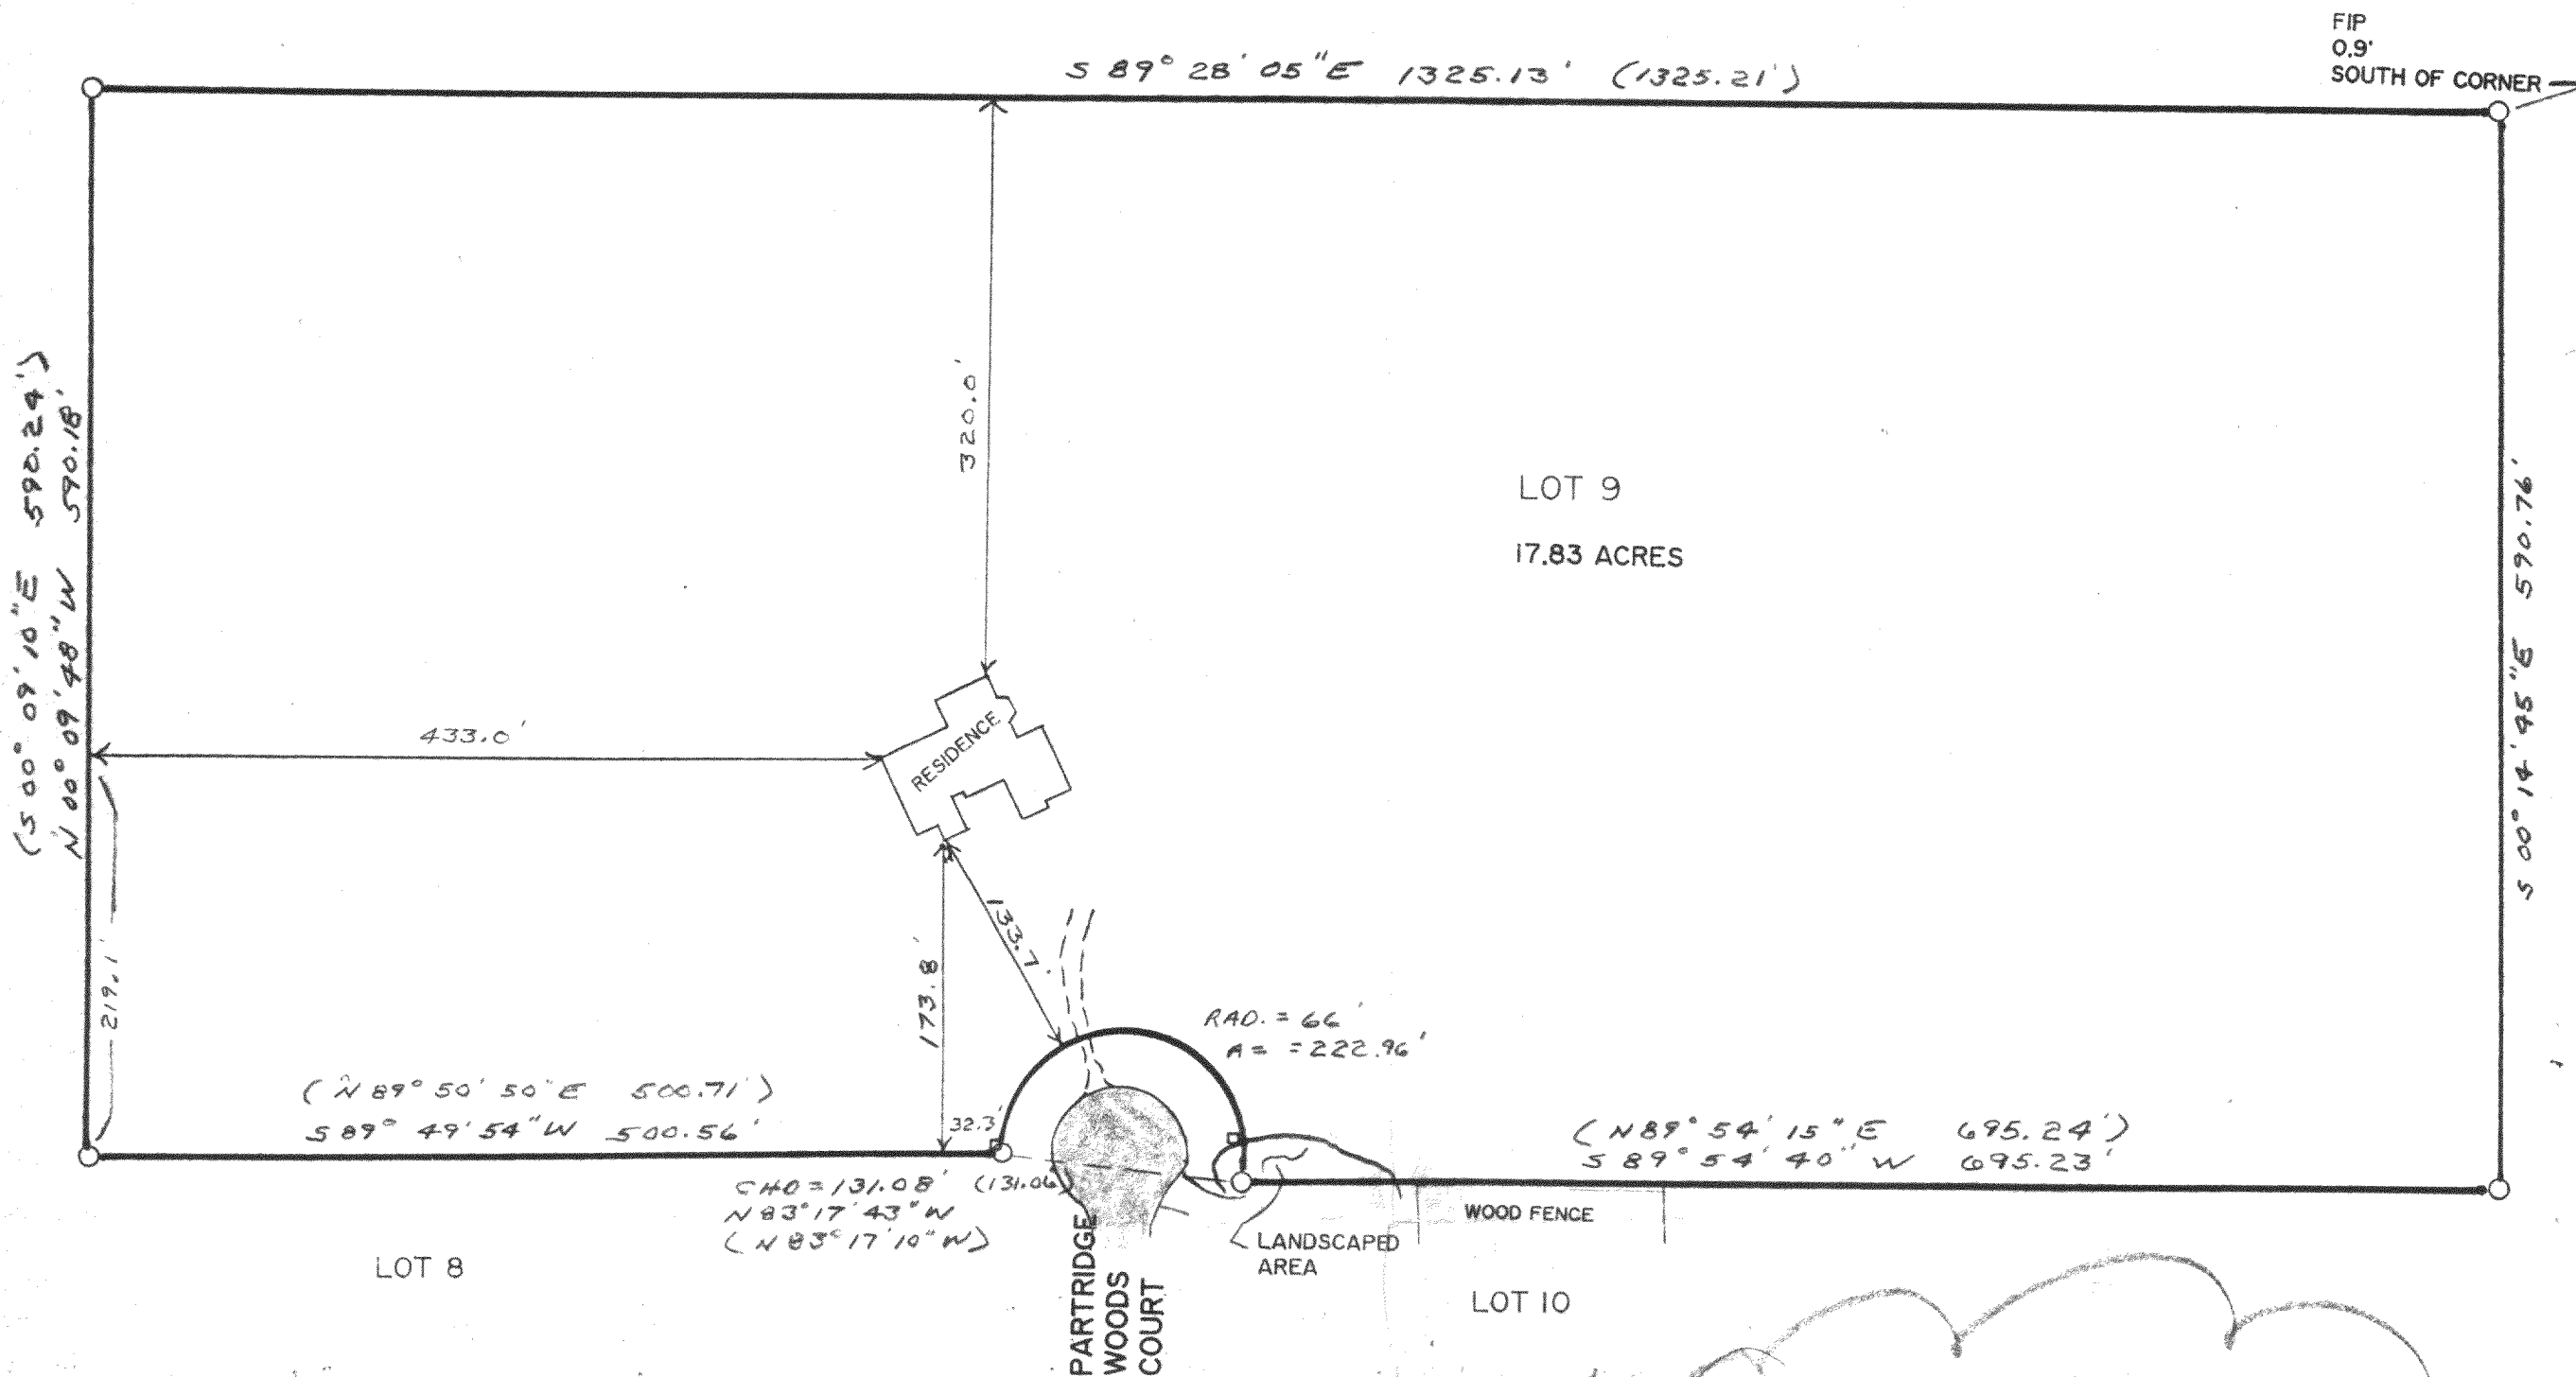

PLAT OF SURVEY
LOT 9 IN PARTRIDGE WOODS
A SUBDIVISION LOCATED IN THE NE 1/4, SE 1/4, & SW 1/4
SECTION 23, TOWN 2 NORTH, RANGE 18 EAST
WALWORTH COUNTY, WISCONSIN

FARRIS, HANSEN & ASSOCIATES, INC.
Engineering, Architecture, Surveying
7 Ridgway Court P.O. Box 437
ELKHORN, WISCONSIN 53121
Office: (414) 723-2098
Fax: (414) 723-5886

REVISIONS

WORK ORDERED BY: THELEN CONSTRUCTION

NPRW-9

218-677