

KOLB LAND CONSULTING, INC.
 LAND SURVEYING - SUBDIVIDING - LAND PLANNING

929 WILLIAMS STREET LAKE GENEVA, WISCONSIN 53147 414 248 3697

39

WEST
CIRCLE
DRIVE
66' WIDE


13

ORDERED BY: ARNIE MARKWALD
 220 LAURIE STREET
 LAKE GENEVA, WI. 53147

2ND AVENUE 66' WIDE

EAST 85.10' (85.00')

IRON ROD FOUND, RESET

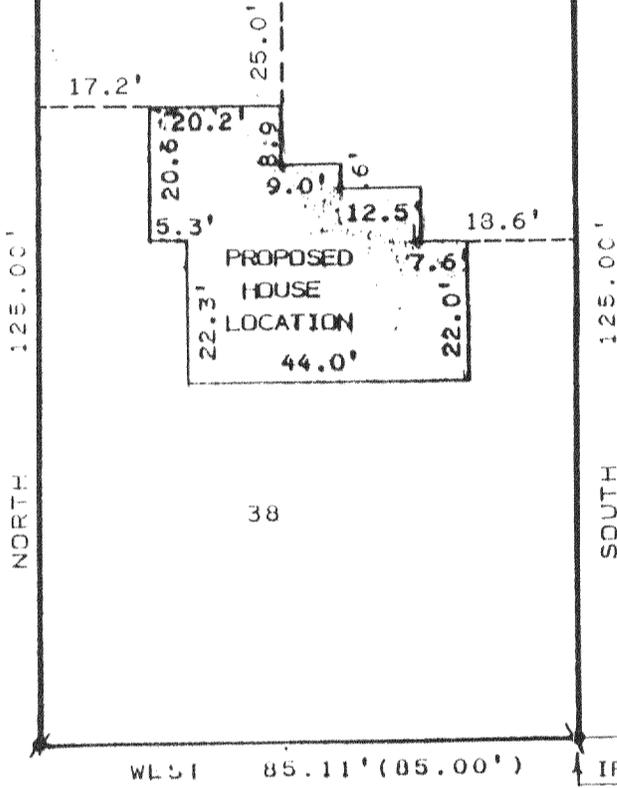

PLAT OF SURVEY OF

LOT 38 OF CLEAR VIEW ESTATES
 SUBDIVISION LOCATED IN THE
 NORTHEAST 1/4 OF SECTION 33,
 T2N, R18E, TOWN OF LYONS,
 WALWORTH COUNTY, WISCONSIN.

37

NOTE: BEARINGS ARE ASSUMED AS SHOWN
 ON THE RECORDED SUBDIVISION
 PLAT.

WEST 85.11' (85.00') IRON ROD FOUND, RESET



SCALE: 1" = 30'

LEGEND

- ⊕ - IRON PIPE FOUND
- - IRON PIPE SET
- ⚓ - IRON ROD FOUND

I, HAROLD H. KOLB, DO HEREBY CERTIFY
 THAT I HAVE SURVEYED THE PROPERTY
 HEREON DESCRIBED ACCORDING TO THE
 OFFICIAL RECORDS AND THAT THE PLAT
 HEREON IS A CORRECT REPRESENTATION
 OF THE LOT LINES TO THE BEST OF MY
 KNOWLEDGE AND BELIEF.
 SURVEY NOT VALID UNLESS SURVEYOR'S SIGNATURE
 IS IN RED.

HAROLD H. KOLB
 WISCONSIN REGISTERED LAND SURVEYOR, S-187
 DATE JUNE 25, 1993
 REVISED JULY 8, 1993
 REVISED _____

KOLB LAND CONSULTING, INC.
 LAND SURVEYING · SUBDIVIDING · LAND PLANNING

929 WILLIAMS STREET LAKE GENEVA, WISCONSIN 53147 414 248 3697

39.

WEST
CIRCLE
DRIVE
66' WIDE


13

ORDERED BY: ARNIE MARKWALD
 220 LAURIE STREET
 LAKE GENEVA, WI. 53147

2ND AVENUE 66' WIDE

EAST 85.10' (85.00')

IRON ROD FOUND, RESET

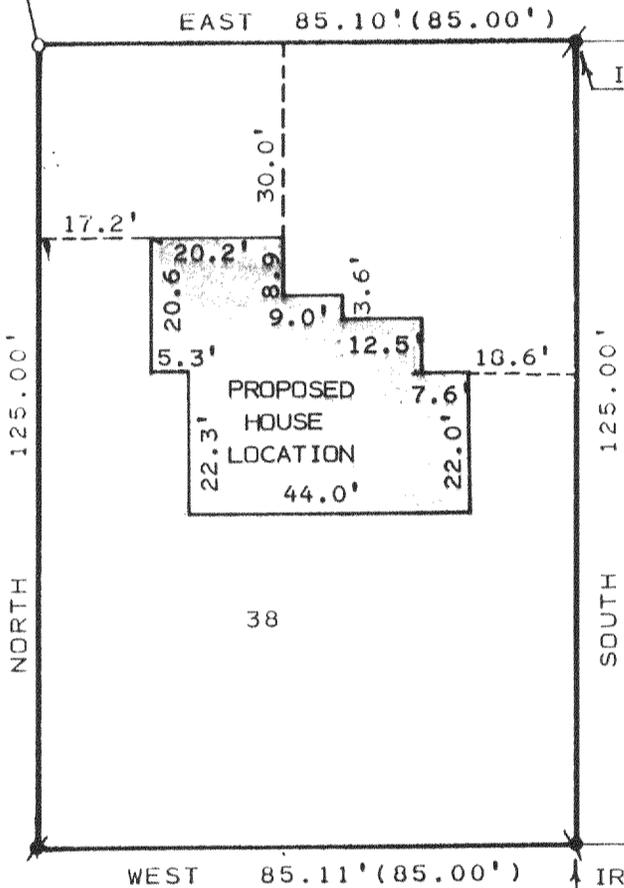

PLAT OF SURVEY OF


LOT 38 OF CLEAR VIEW ESTATES
 SUBDIVISION LOCATED IN THE
 NORTHEAST 1/4 OF SECTION 33,
 T2N, R18E, TOWN OF LYONS,
 WALWORTH COUNTY, WISCONSIN.

37

NOTE: BEARINGS ARE ASSUMED AS SHOWN
 ON THE RECORDED SUBDIVISION
 PLAT.

WEST 85.11' (85.00')

IRON ROD FOUND, RESET

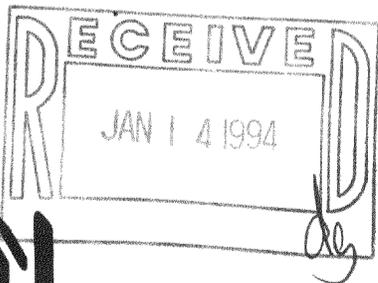

SCALE: 1" = 30'

LEGEND

- ⊕ - IRON PIPE FOUND
- - IRON PIPE SET
- ⦿ - IRON ROD FOUND

I, HAROLD H. KOLB, DO HEREBY CERTIFY
 THAT I HAVE SURVEYED THE PROPERTY
 HEREON DESCRIBED ACCORDING TO THE
 OFFICIAL RECORDS AND THAT THE PLAT
 HEREON IS A CORRECT REPRESENTATION
 OF THE LOT LINES TO THE BEST OF MY
 KNOWLEDGE AND BELIEF.
 SURVEY NOT VALID UNLESS SURVEYOR'S SIGNATURE
 IS IN RED.

HAROLD H. KOLB

WISCONSIN REGISTERED LAND SURVEYOR, S- 187

DATE JUNE 25, 1993


REVISED _____

REVISED _____

NCL-38


KOLB LAND CONSULTING, INC.
 LAND SURVEYING • SUBDIVIDING • LAND PLANNING

929 WILLIAMS STREET LAKE GENEVA, WISCONSIN 53147 414 248-3697

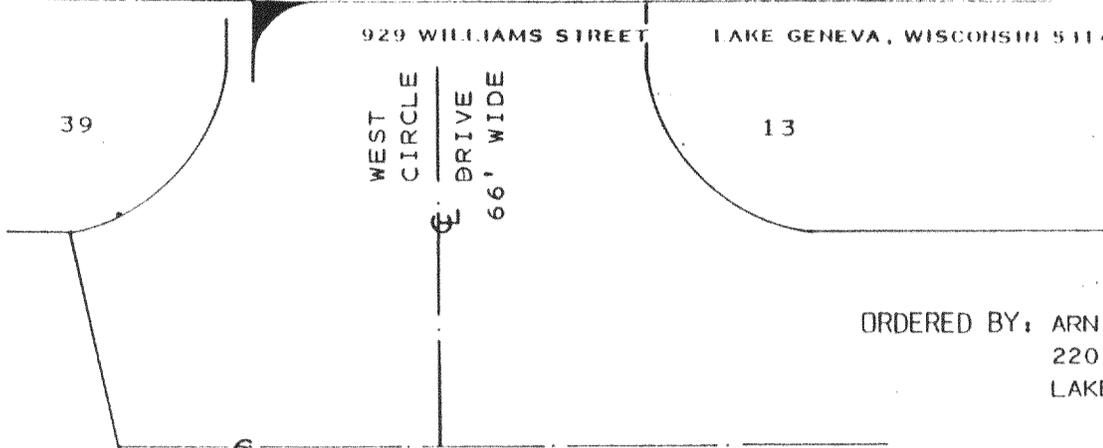

ORDERED BY: ARNIE MARKWALD
 220 LAURIE STREET
 LAKE GENEVA, WI. 53147

2ND AVENUE 66' WIDE

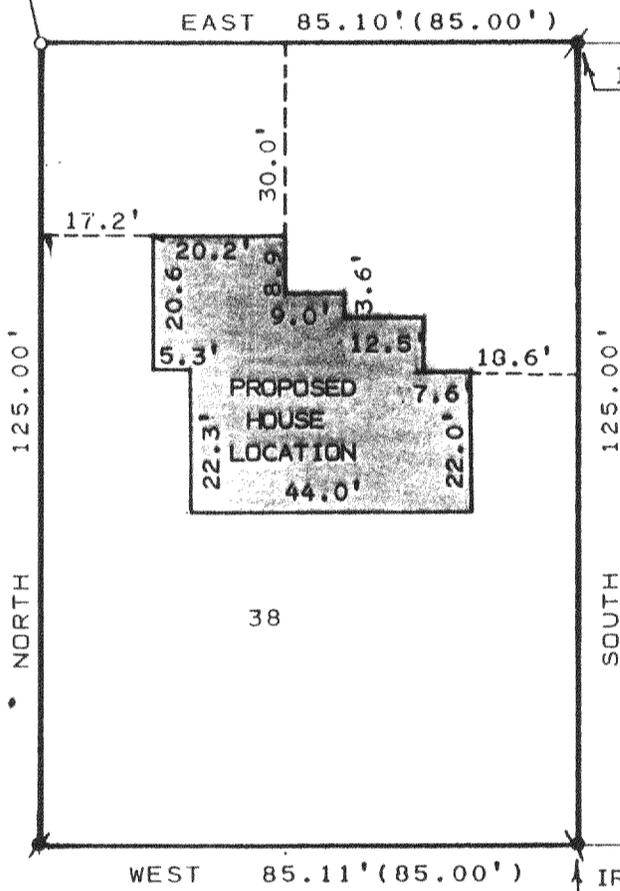


PLAT OF SURVEY OF

LOT 38 OF CLEAR VIEW ESTATES
 SUBDIVISION LOCATED IN THE
 NORTHEAST 1/4 OF SECTION 33,
 T2N, R18E, TOWN OF LYONS,
 WALWORTH COUNTY, WISCONSIN.

37

NOTE: BEARINGS ARE ASSUMED AS SHOWN
 ON THE RECORDED SUBDIVISION
 PLAT.

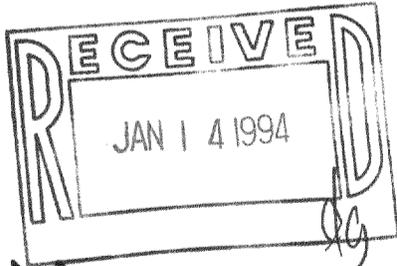

SCALE: 1" = 30'
 LEGEND

- ⊕ - IRON PIPE FOUND
- - IRON PIPE SET
- ⦿ - IRON ROD FOUND

I, HAROLD H. KOLB, DO HEREBY CERTIFY
 THAT I HAVE SURVEYED THE PROPERTY
 HEREON DESCRIBED ACCORDING TO THE
 OFFICIAL RECORDS AND THAT THE PLAT
 HEREON IS A CORRECT REPRESENTATION
 OF THE LOT LINES TO THE BEST OF MY
 KNOWLEDGE AND BELIEF.
 SURVEY NOT VALID UNLESS SURVEYOR'S SIGNATURE
 IS IN RED.

HAROLD H. KOLB

WISCONSIN REGISTERED LAND SURVEYOR, S- 187

DATE JUNE 25, 1993

REVISED _____

REVISED _____