


KOLB LAND CONSULTING, INC.

LAND SURVEYING • SUBDIVIDING • LAND PLANNING

929 WILLIAMS STREET LAKE GENEVA, WISCONSIN 53147 414 248 3697

NOTE: BEARINGS BASED ON
WISCONSIN COOR-
DINATE SYSTEM,
SOUTH ZONE.


ORDERED BY: JOELLE VOLBRECHT
173 W. JEFFERSON STREET
BURLINGTON, WI. 53105

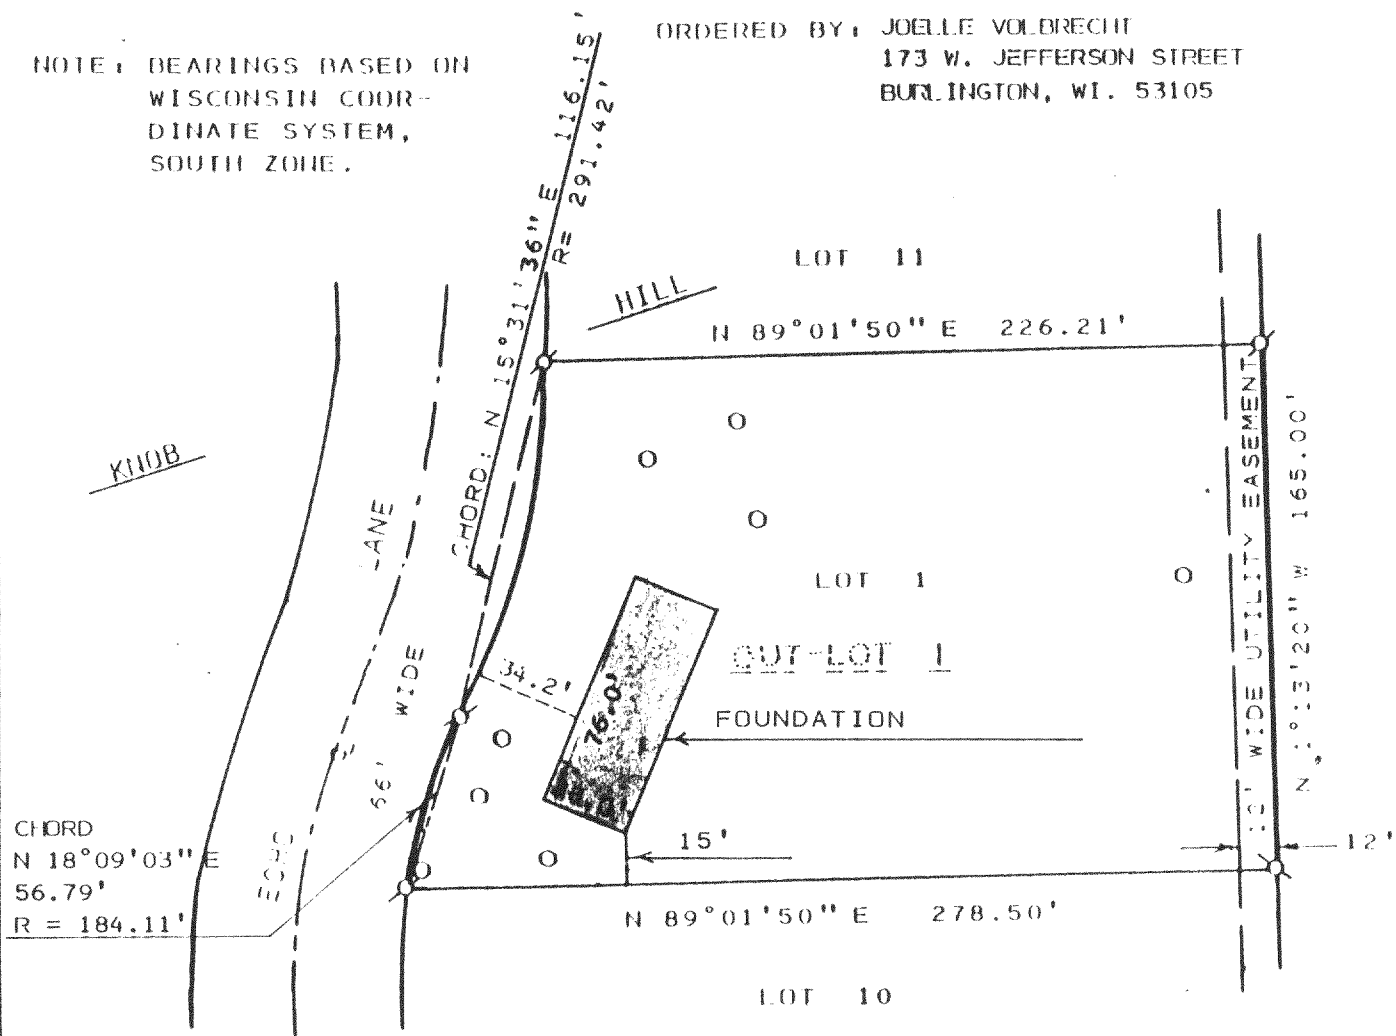

SUBDIVISION

PLAT OF SURVEY OF

LOT 1, CERTIFIED SURVEY MAP NO. 1003,
LOCATED IN SECTION 27, T2N, R18E,
TOWN OF LYONS, WALWORTH COUNTY,
WISCONSIN.

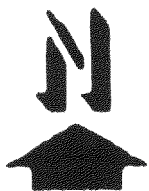


SCALE 1" = 60'

LEGEND

- O - IRON PIPE SET
- Q - BORING HOLES
- Ø - IRON PIPE FOUND

I HEREBY CERTIFY THAT I HAVE SURVEYED THE
ABOVE DESCRIBED PROPERTY AND THAT THE ABOVE
MAP IS A TRUE REPRESENTATION THEREOF AND
SHOWS THE SIZE AND LOCATION OF THE PROPERTY,
ITS EXTERIOR BOUNDARIES, THE LOCATION OF ALL
VISIBLE STRUCTURES AND DIMENSIONS OF ALL
PRINCIPAL BUILDINGS THEREON, BOUNDARY FENCES,
APPARENT EASEMENTS, ROADWAYS AND VISIBLE
ENCROACHMENTS, IF ANY TO THE BEST OF MY
KNOWLEDGE AND BELIEF.

THIS SURVEY IS MADE FOR THE USE OF THE
PRESENT OWNERS OF THE PROPERTY, AND ALSO
THOSE WHO PURCHASE, MORTGAGE, OR GUARANTEE
THE TITLE THERETO WITHIN (1) YEAR FROM
DATE HEREOF. SURVEY NOT VALID UNLESS SUR-
VEYOR'S SIGNATURE IS IN RED.

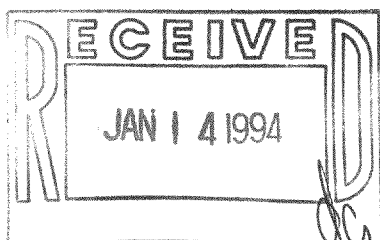

HAROLD H. KOLB

WISCONSIN REGISTERED LAND SURVEYOR, S 107

DATE APRIL 13, 1993

REVISED APRIL 15, 1993

REVISED JUNE 28, 1993

NA-1003-1

2-18-112



218-730

KOLB LAND CONSULTING, INC.
LAND SURVEYING • SUBDIVIDING • LAND PLANNING

929 WILLIAMS STREET LAKE GENEVA, WISCONSIN 53147 414 248 3697

NOTE: BEARINGS BASED ON
WISCONSIN COOR-
DINATE SYSTEM,
SOUTH ZONE.


ORDERED BY: JOELLE VOLBRECHT
173 W. JEFFERSON STREET
BURLINGTON, WI. 53105

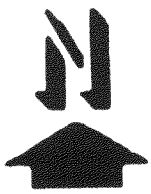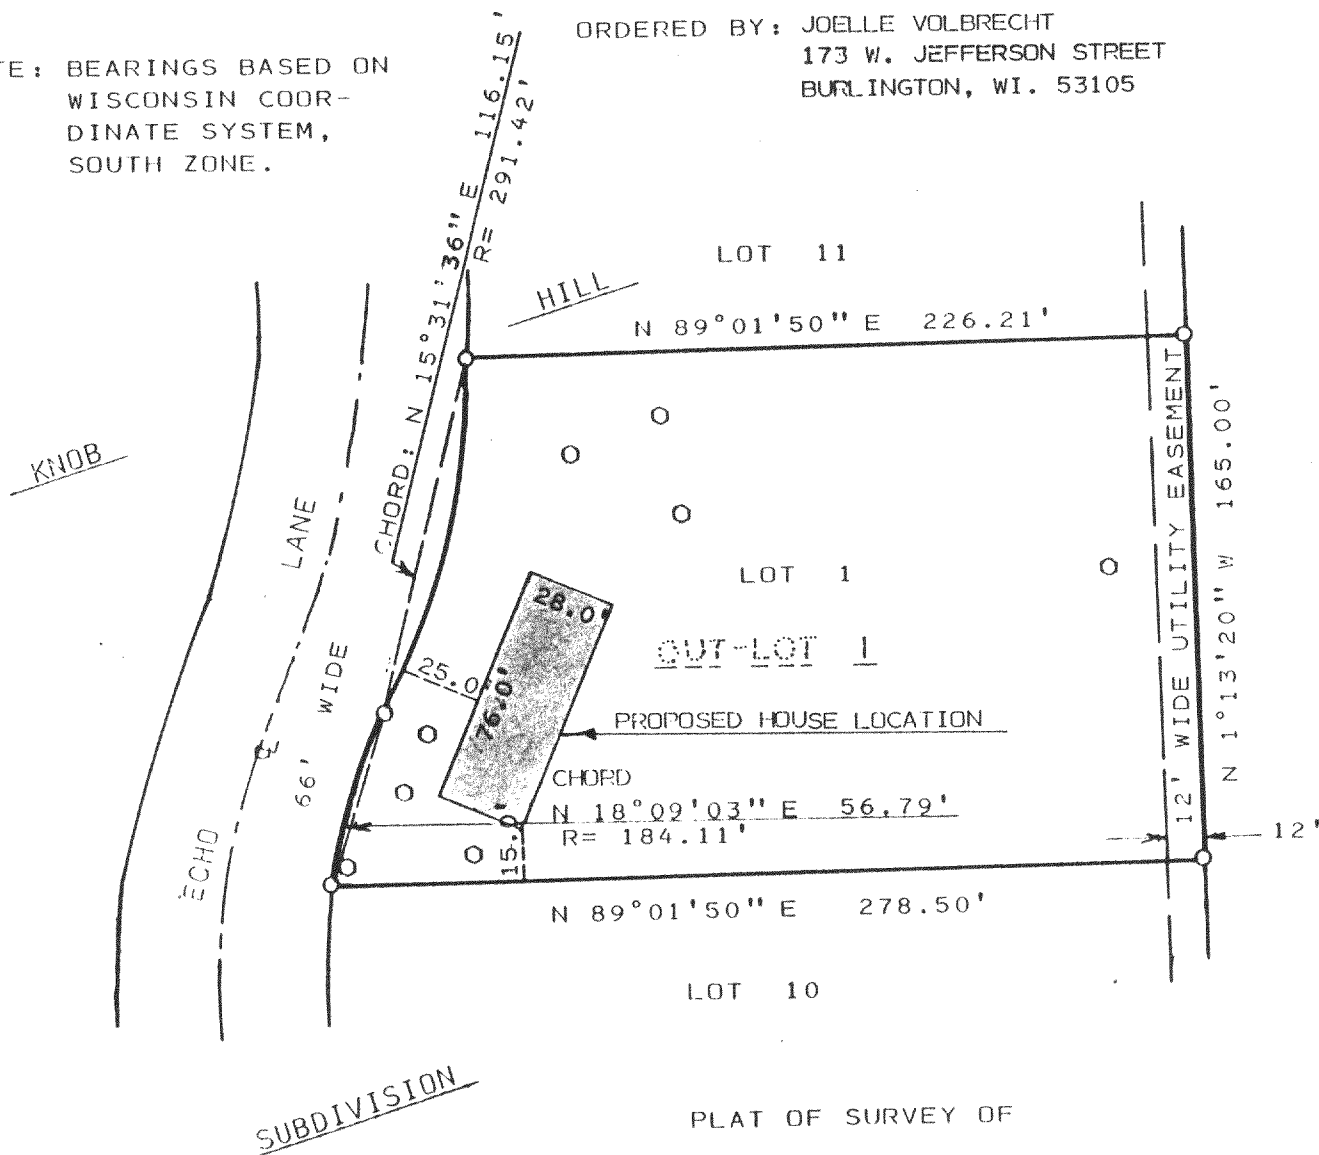

SCALE 1" = 60'

LEGEND

O - IRON PIPE SET
O - BORING HOLES

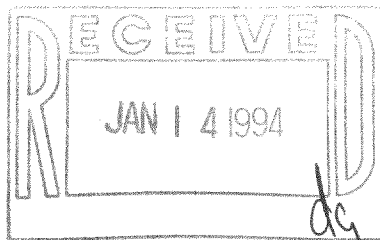

PLAT OF SURVEY OF

LOT 1, CERTIFIED SURVEY MAP NO. 1003,
LOCATED IN SECTION 27, T2N, R18E,
TOWN OF LYONS, WALWORTH COUNTY,
WISCONSIN.

I HEREBY CERTIFY THAT I HAVE SURVEYED THE
ABOVE DESCRIBED PROPERTY AND THAT THE ABOVE
MAP IS A TRUE REPRESENTATION THEREOF AND
SHOWS THE SIZE AND LOCATION OF THE PROPERTY,
ITS EXTERIOR BOUNDARIES, THE LOCATION OF ALL
VISIBLE STRUCTURES AND DIMENSIONS OF ALL
PRINCIPAL BUILDINGS THEREON, BOUNDARY FENCES
APPARENT EASEMENTS, ROADWAYS AND VISIBLE
ENCROACHMENTS, IF ANY TO THE BEST OF MY
KNOWLEDGE AND BELIEF.

THIS SURVEY IS MADE FOR THE USE OF THE
PRESENT OWNERS OF THE PROPERTY, AND ALSO
THOSE WHO PURCHASE, MORTGAGE, OR GUARANTEE
THE TITLE THERETO WITHIN (1) YEAR FROM
DATE HEREOF. SURVEY NOT VALID UNLESS SUR-
VEYOR'S SIGNATURE IS IN RED.

HAROLD H. KOLB

WISCONSIN REGISTERED LAND SURVEYOR, S-187

DATE APRIL 13, 1993

REVISED

REVISED