


W A L W O R T H

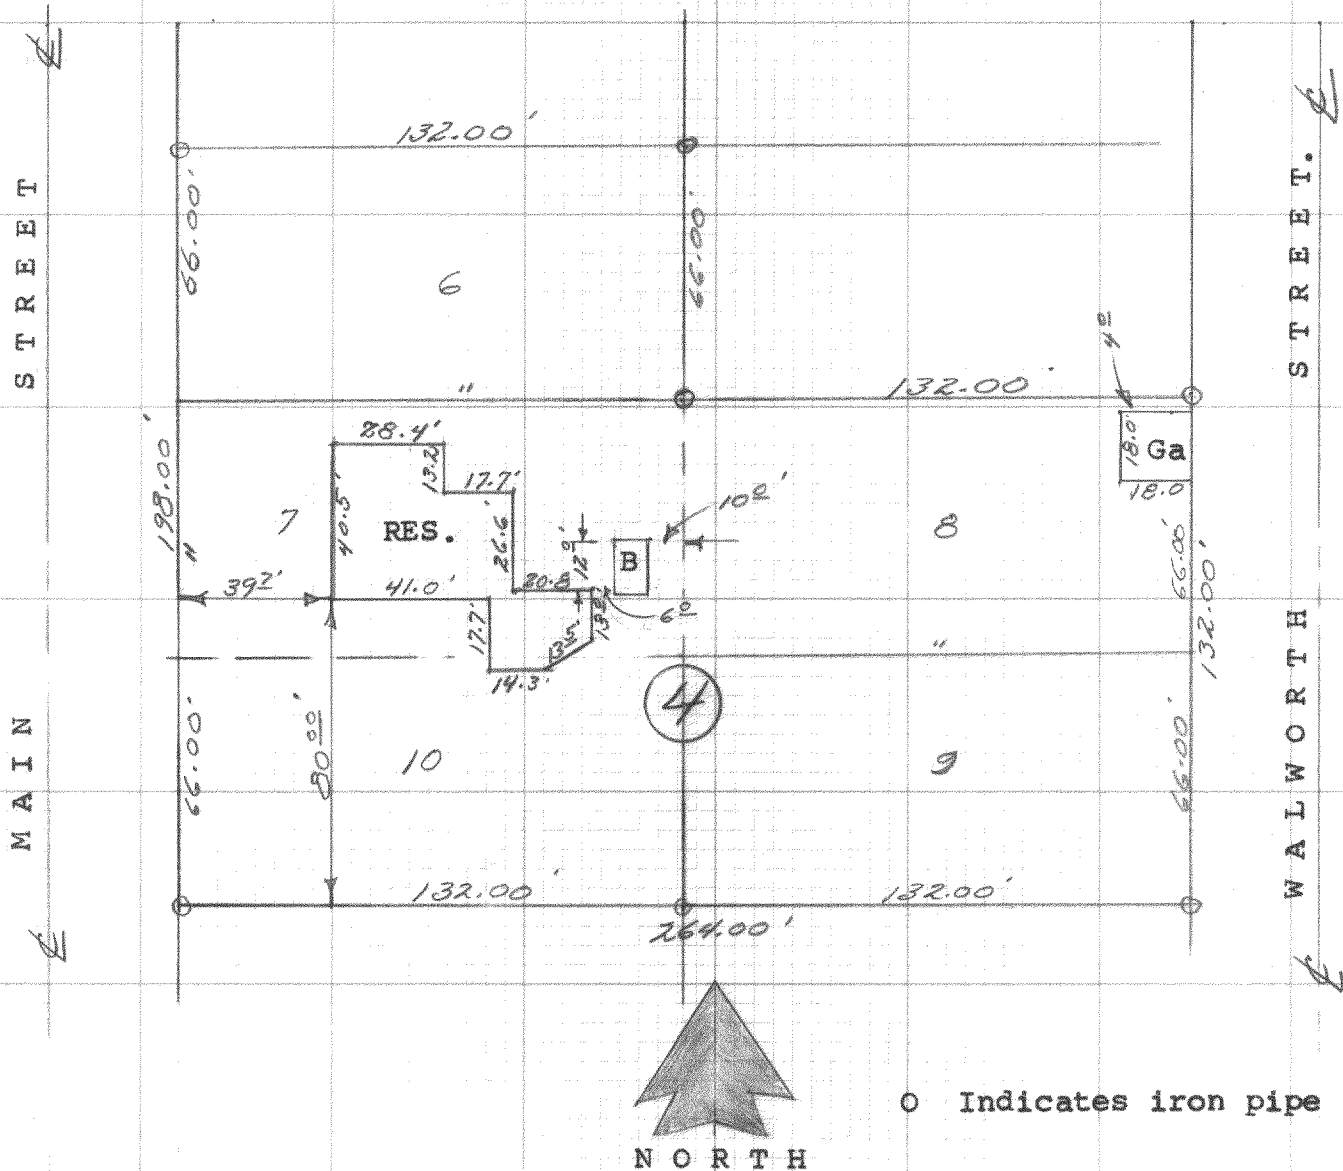


DESCRIPTION:

Lots 6,7,8,9,and 10 Block 4; Original Plat of Springfield
Lyons Township, Walworth County, Wisconsin.

CERTIFICATE: I, hereby certify that I have surveyed the above mentioned property and that the hereon portrayed is an accurate survey and a true representation thereof and correctly shows the exterior boundary lines and the location of the buildings and the other improvements thereof.

Dated: May 16th 1967.

James F. Biagi RLS 272
Elkhorn, Wisconsin.

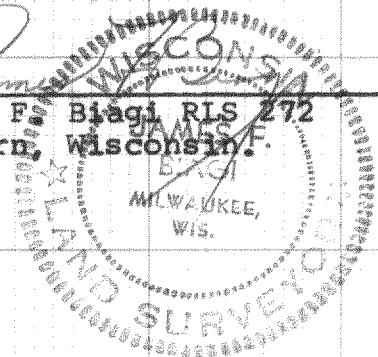

218-74 B