


PLAT OF SURVEY

of
Lot 2 of Certified Survey Map No. 2219, located in the Southeast 1/4 of
Section 21, Town 2 North, Range 18 East, Town of Lyons, Walworth County, Wisconsin.

Surveyed for: **Karen Radcliffe**
4202 John Street
Solon Mills, Illinois. 60080

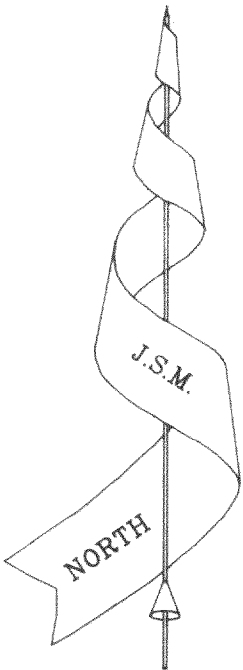

Bearings referenced to C.S.M. 2219.
Elevations referenced to Benchmark 1
as shown on previous survey of record.


JENSEN SURVEYING & MAPPING S.C.

45 South Wisconsin Street P.O. Box 322
Elkhorn, Wisconsin. 53121
Telephone & Facsimile (414) 723-3434



Mapping date: March 23, 1994.
Revisions: May 2, 1994.

Legend

- Found Iron Pipe
- Found Iron Rod
- Set Wood Stake
- Telephone Pedestal
- Electric Box
- Spot Elevation

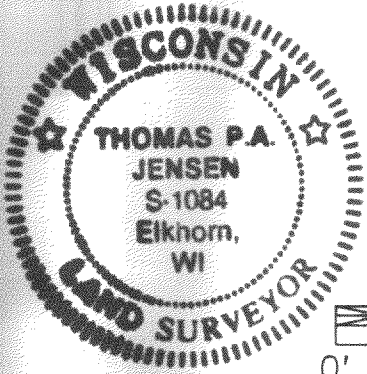

Scale in Feet
1" = 20'

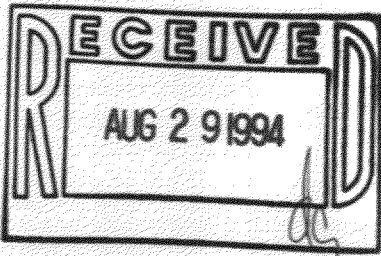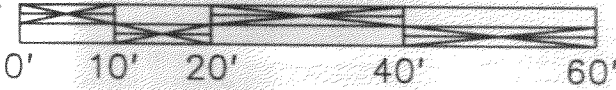


Copyright © 1994 by Jensen Surveying & Mapping S.C.
All rights reserved. No part of this survey plat may be reproduced or transmitted in any form by any means — graphic, electronic, or mechanical, including photocopying, tracing, or information storage and retrieval systems — without permission in writing from Thomas P.A. Jensen, Jensen Surveying & Mapping S.C..

I, Thomas P.A. Jensen, Wisconsin Registered Land Surveyor, do hereby certify that this survey was performed by me, or under my direction in full compliance with the owner's / agent's instructions and Chapter A-E 7 of the Wisconsin Administrative Code "Minimum Standards for Property Surveys", and that this map is as accurate representation thereof to the best of my knowledge and belief.

Note: This survey plat is not certified unless signed and sealed in red ink.


Thomas P.A. Jensen R.L.S. 1084

Location Sketch
1"=100'

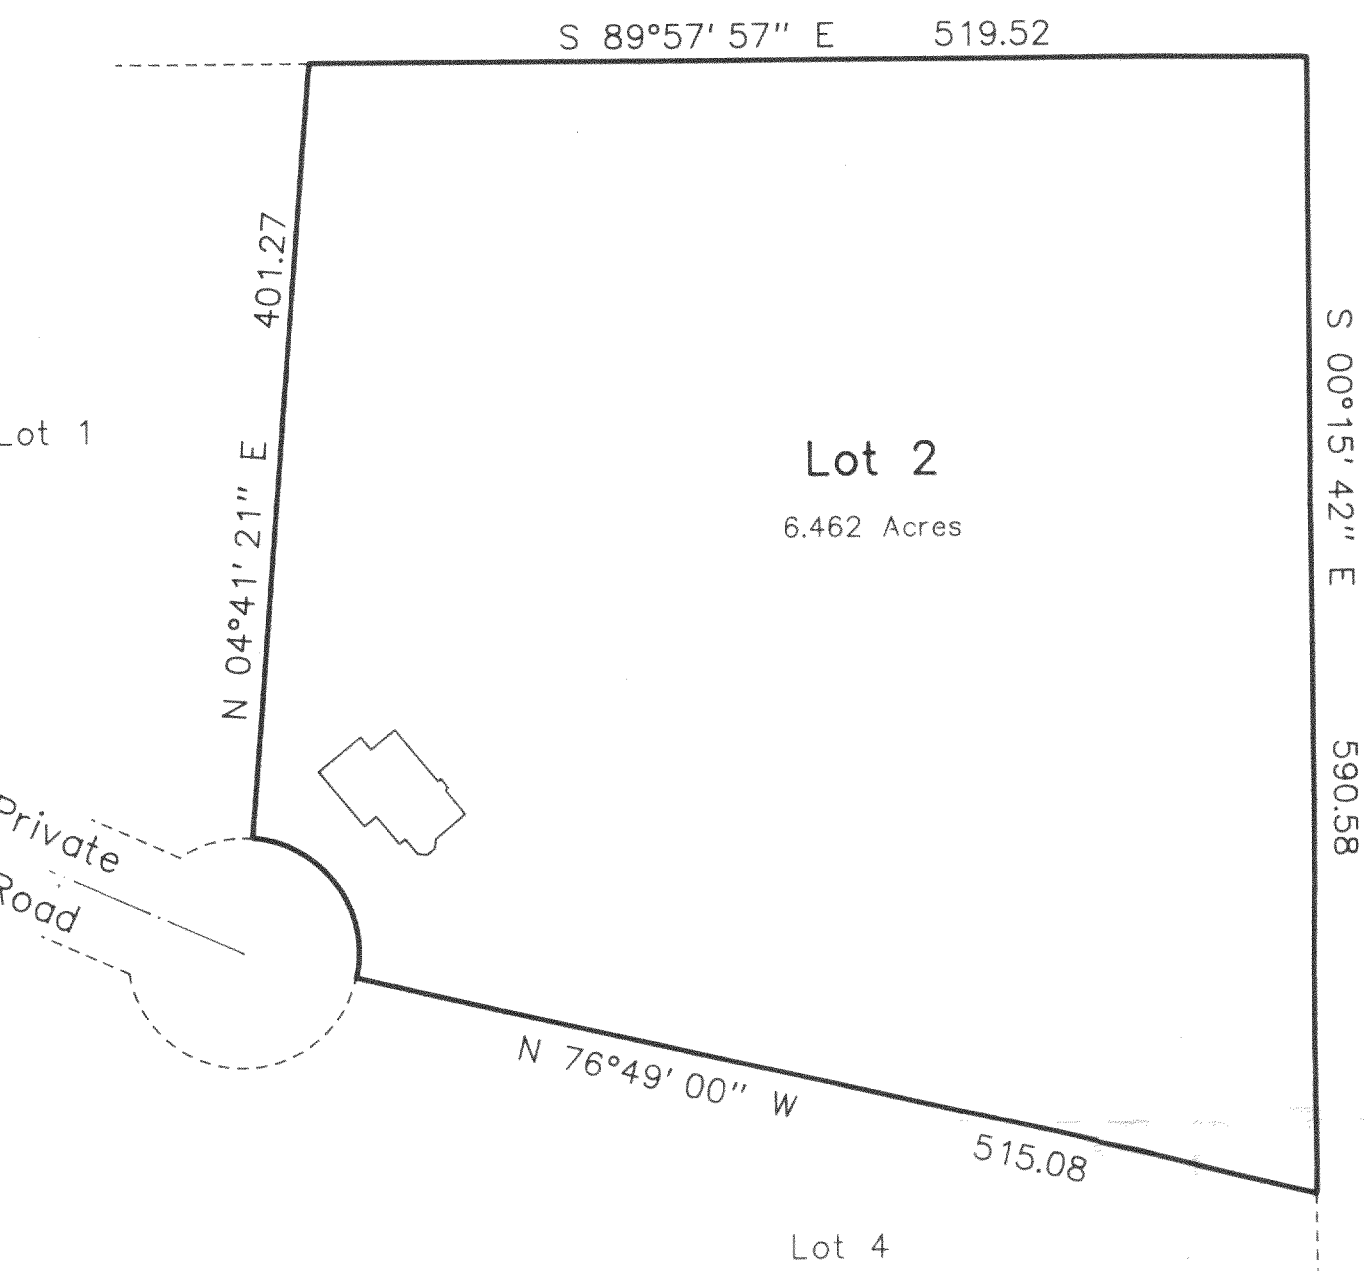

Lot 2

Benchmark 2
RR. Spike in Tree
Elev. = 110.28

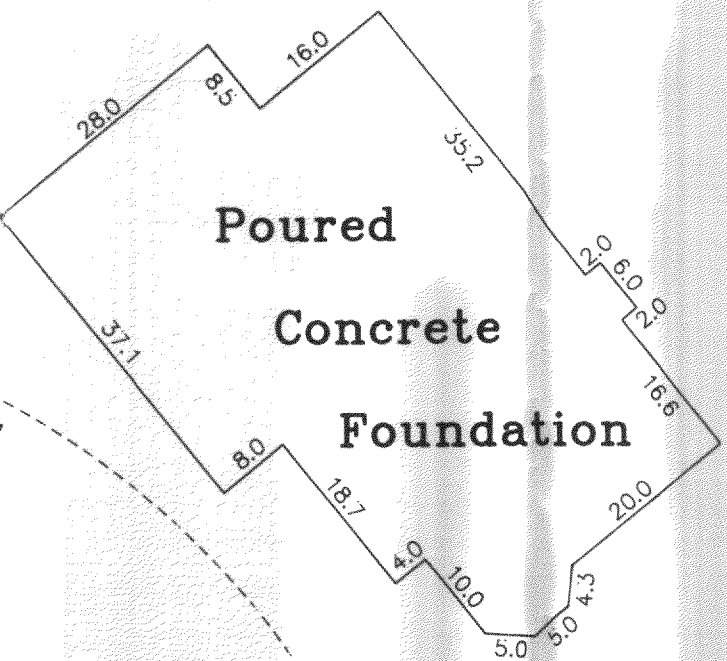

Private Road


Benchmark 1
RR. Spike in Tree
Elev. = 103.00

N 76°49'00" W

PLAT OF SURVEY

of
Lot 2 of Certified Survey Map No. 2219, located in the Southeast 1/4 of
Section 21, Town 2 North, Range 18 East, Town of Lyons, Walworth County, Wisconsin.

Surveyed for: **Karen Radcliffe**
4202 John Street
Solon Mills, Illinois. 60080

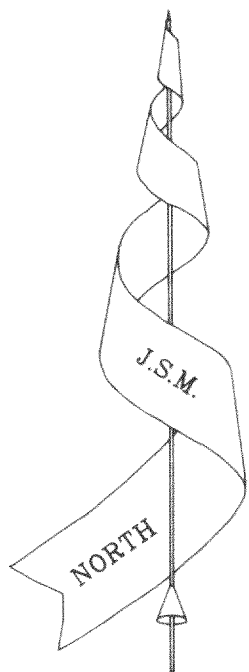

Bearings referenced to C.S.M. 2219.
Elevations referenced to Benchmark 1
as shown on previous survey of record.

JENSEN SURVEYING & MAPPING S.C.


45 South Wisconsin Street P.O. Box 322
Elkhorn, Wisconsin. 53121
Telephone & Facsimile (414) 723-3434

Mapping date: March 23, 1994.

Revisions:



Legend

- Found Iron Pipe
- Found Iron Rod
- Set Wood Stake
- Telephone Pedestal
- Electric Box
- Spot Elevation

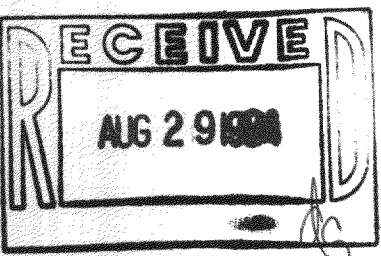

Scale in Feet

1" = 20'

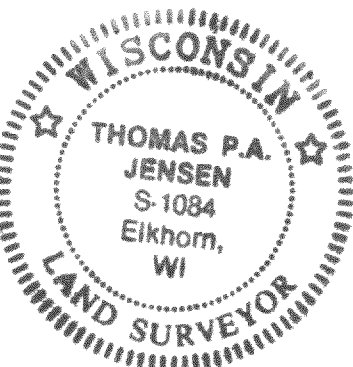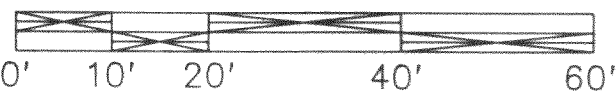

Copyright © 1994 by Jensen Surveying & Mapping S.C.

All rights reserved. No part of this survey plat may be reproduced or transmitted in any form by any means — graphic, electronic, or mechanical, including photocopying, tracing, or information storage and retrieval systems — without permission in writing from Thomas P.A. Jensen, Jensen Surveying & Mapping S.C..

I, Thomas P.A. Jensen, Wisconsin Registered Land Surveyor, do hereby certify that this survey was performed by me, or under my direction in full compliance with the owner's / agent's instructions and Chapter A-E 7 of the Wisconsin Administrative Code "Minimum Standards for Property Surveys"; and that this map is as accurate representation thereof to the best of my knowledge and belief.


Thomas P.A. Jensen
Thomas P.A. Jensen R.L.S. 1084

Sheet no. 1 of 1 Sheets

Job Reference Number: 1994.019

Location Sketch

1" = 100'

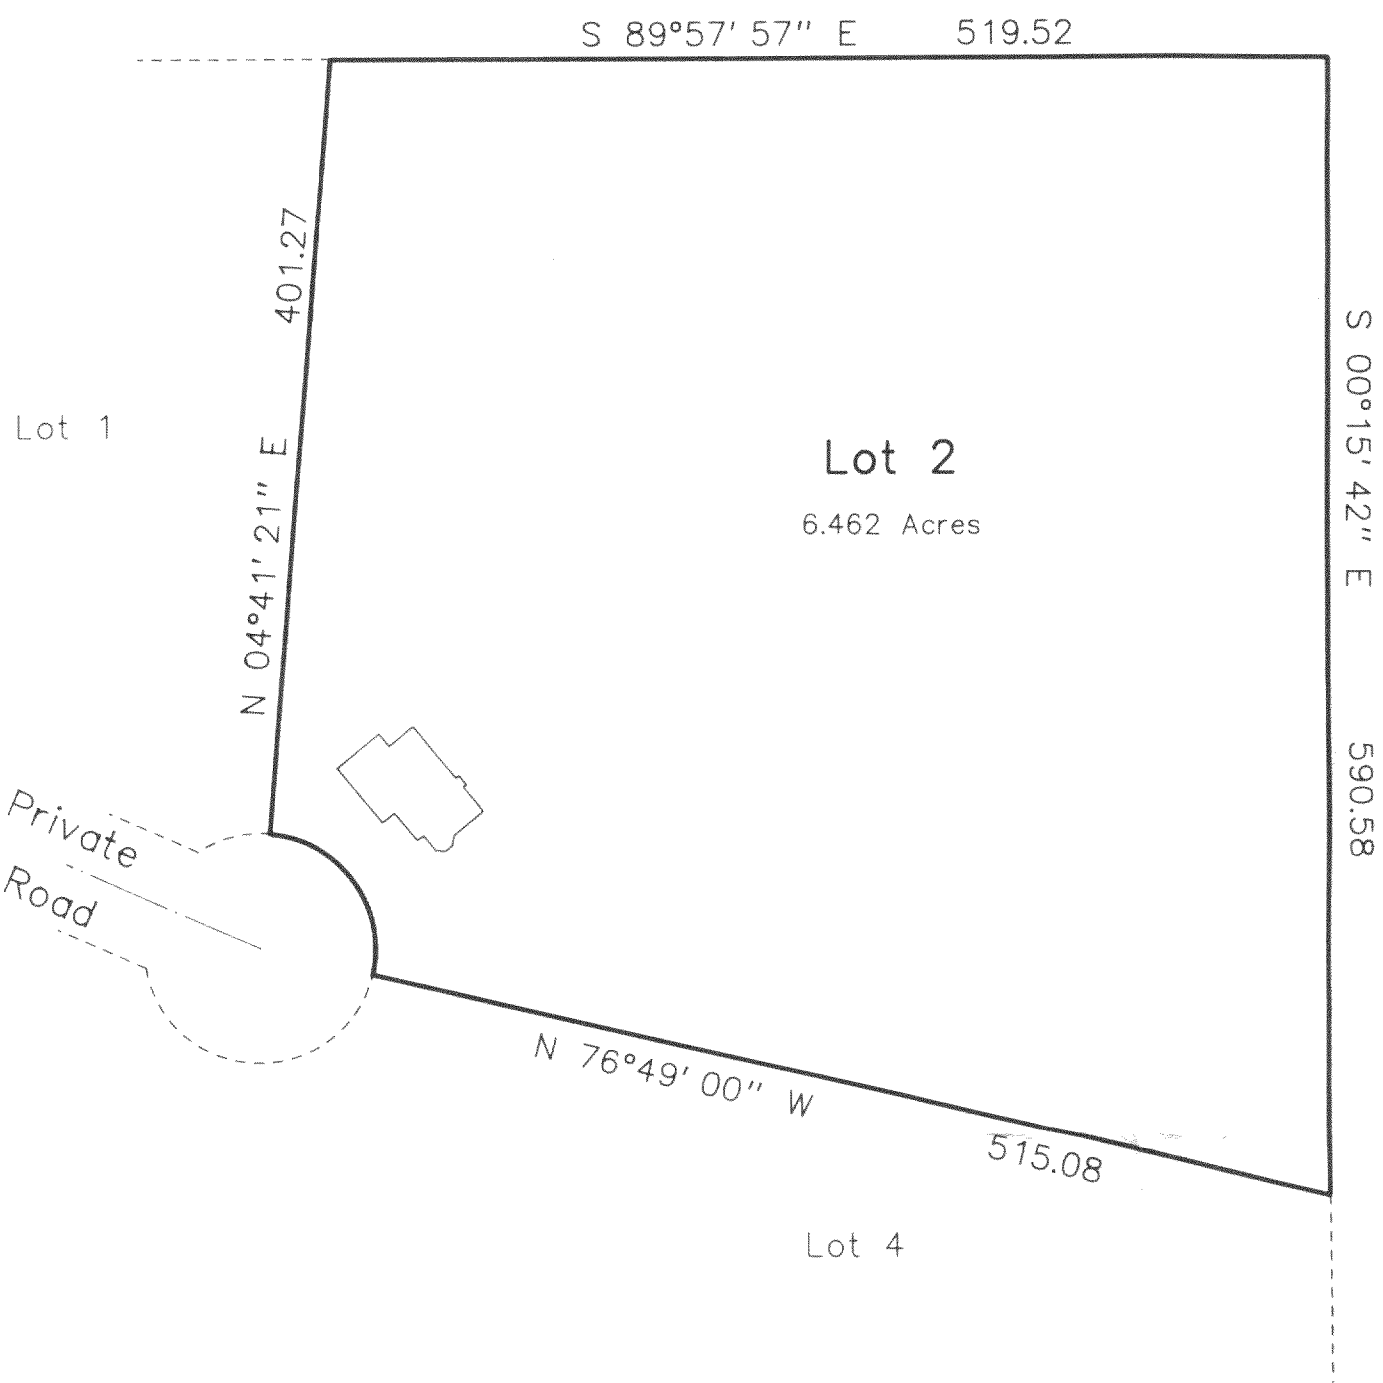

Private
Road

Benchmark 2
RR. Spike in Tree
Elev. = 110.28

Benchmark 1
RR. Spike in Tree
Elev. = 103.00

Proposed
House

Building

Setback

N 76°49'00" W

Lot 2