


ABERNATHY and ASSOCIATES

Kenneth B. Abernathy Jr.

Wisconsin Registered Land Surveyor S-1594

Rt. 3, Box 273
Elkhorn, Wisconsin 53121
Phone: (414) 723-4260 (office)
(414) 723-4813 (residence)

PLAT OF SURVEY

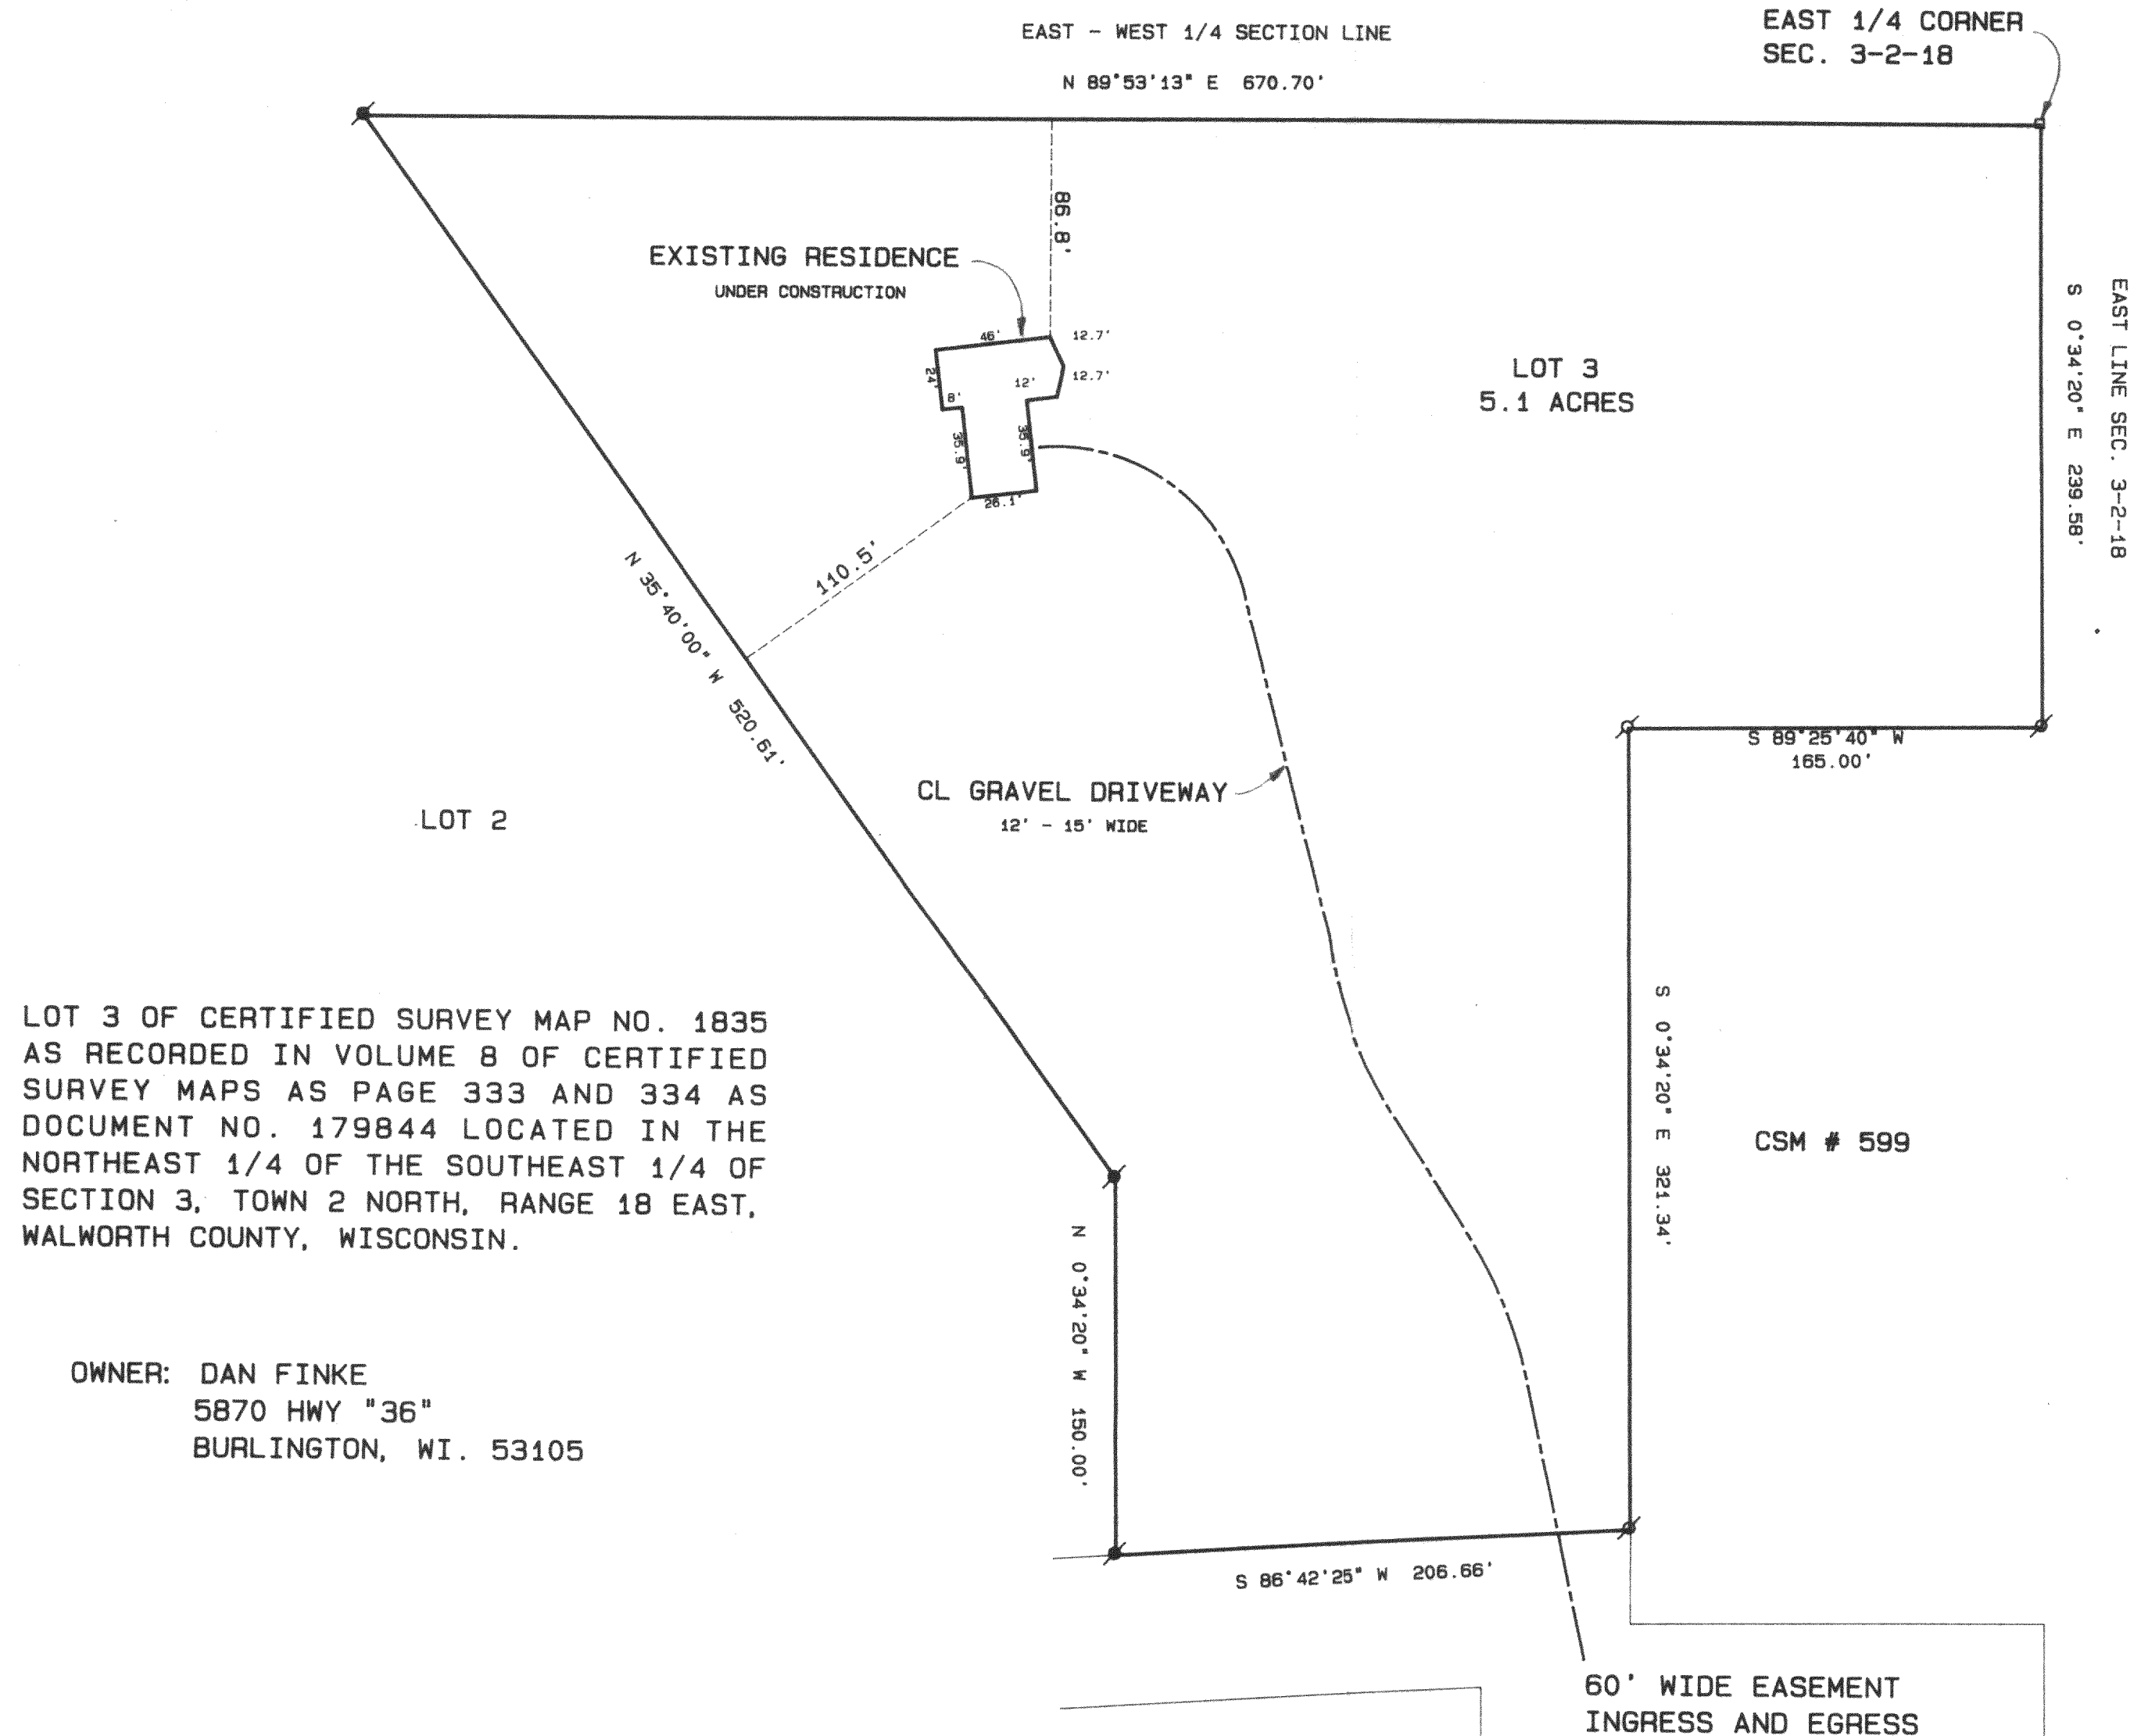

LOT 3 OF CERTIFIED SURVEY MAP NO. 1835
AS RECORDED IN VOLUME 8 OF CERTIFIED
SURVEY MAPS AS PAGE 333 AND 334 AS
DOCUMENT NO. 179844 LOCATED IN THE
NORTHEAST 1/4 OF THE SOUTHEAST 1/4 OF
SECTION 3, TOWN 2 NORTH, RANGE 18 EAST,
WALWORTH COUNTY, WISCONSIN.

OWNER: DAN FINKE
5870 HWY "36"
BURLINGTON, WI. 53105



SCALE 1" = 60 FEET

Legend

- FOUND IRON PIPE
- FOUND IRON ROD
- FOUND BRASS CAPPED MONUMENT
- FOUND CONCRETE MONUMENT
- CHISEL CUT IN CONCRETE
- SET IRON ROD, 24" LONG, WEIGHING 1.5 LBS./LINEAL FT., 3/4" DIA.
- SET IRON ROD, 30" LONG, WEIGHING 4.5 LBS./LINEAL FT., 1-11/16" DIA.
- (XX) RECORDED AS DIMENSION
- EXISTING FENCE

SCALE: 1"= 60 FEET

"I hereby certify that I have surveyed the above described property and that the above map is a true representation thereof and shows the size and location of the property, its exterior boundaries, the location of all visible structures and dimensions of all principal buildings thereon, boundary fences, apparent easements, roadways and visible encroachments, if any."

"This survey is made for the use of the present owners of the property, and also those who purchase, mortgage, guarantee the title thereto within one year from date hereof."

Kenneth B. Abernathy Jr.

KENNETH B. ABERNATHY, JR.
WISCONSIN REGISTERED LAND SURVEYOR,
S-1594

Date: 6-3-94 Job No. 94.512

