

ABERNATHY and ASSOCIATES


Kenneth B. Abernathy Jr.

Wisconsin Registered Land Surveyor S-1594

W4056 Bray Road
Ekhorn, Wisconsin 53121
Phone: (414) 723-4260 (office)
(414) 723-4813 (residence)

PLAT OF SURVEY


Lot 5 of Block 3 of the First Addition to
Knoll Brook Subdivision, located in part of
the Southwest 1/4 of Section 10, Town 2 North,
Range 18 East, Town of Lyons, County of
Walworth, State of Wisconsin.

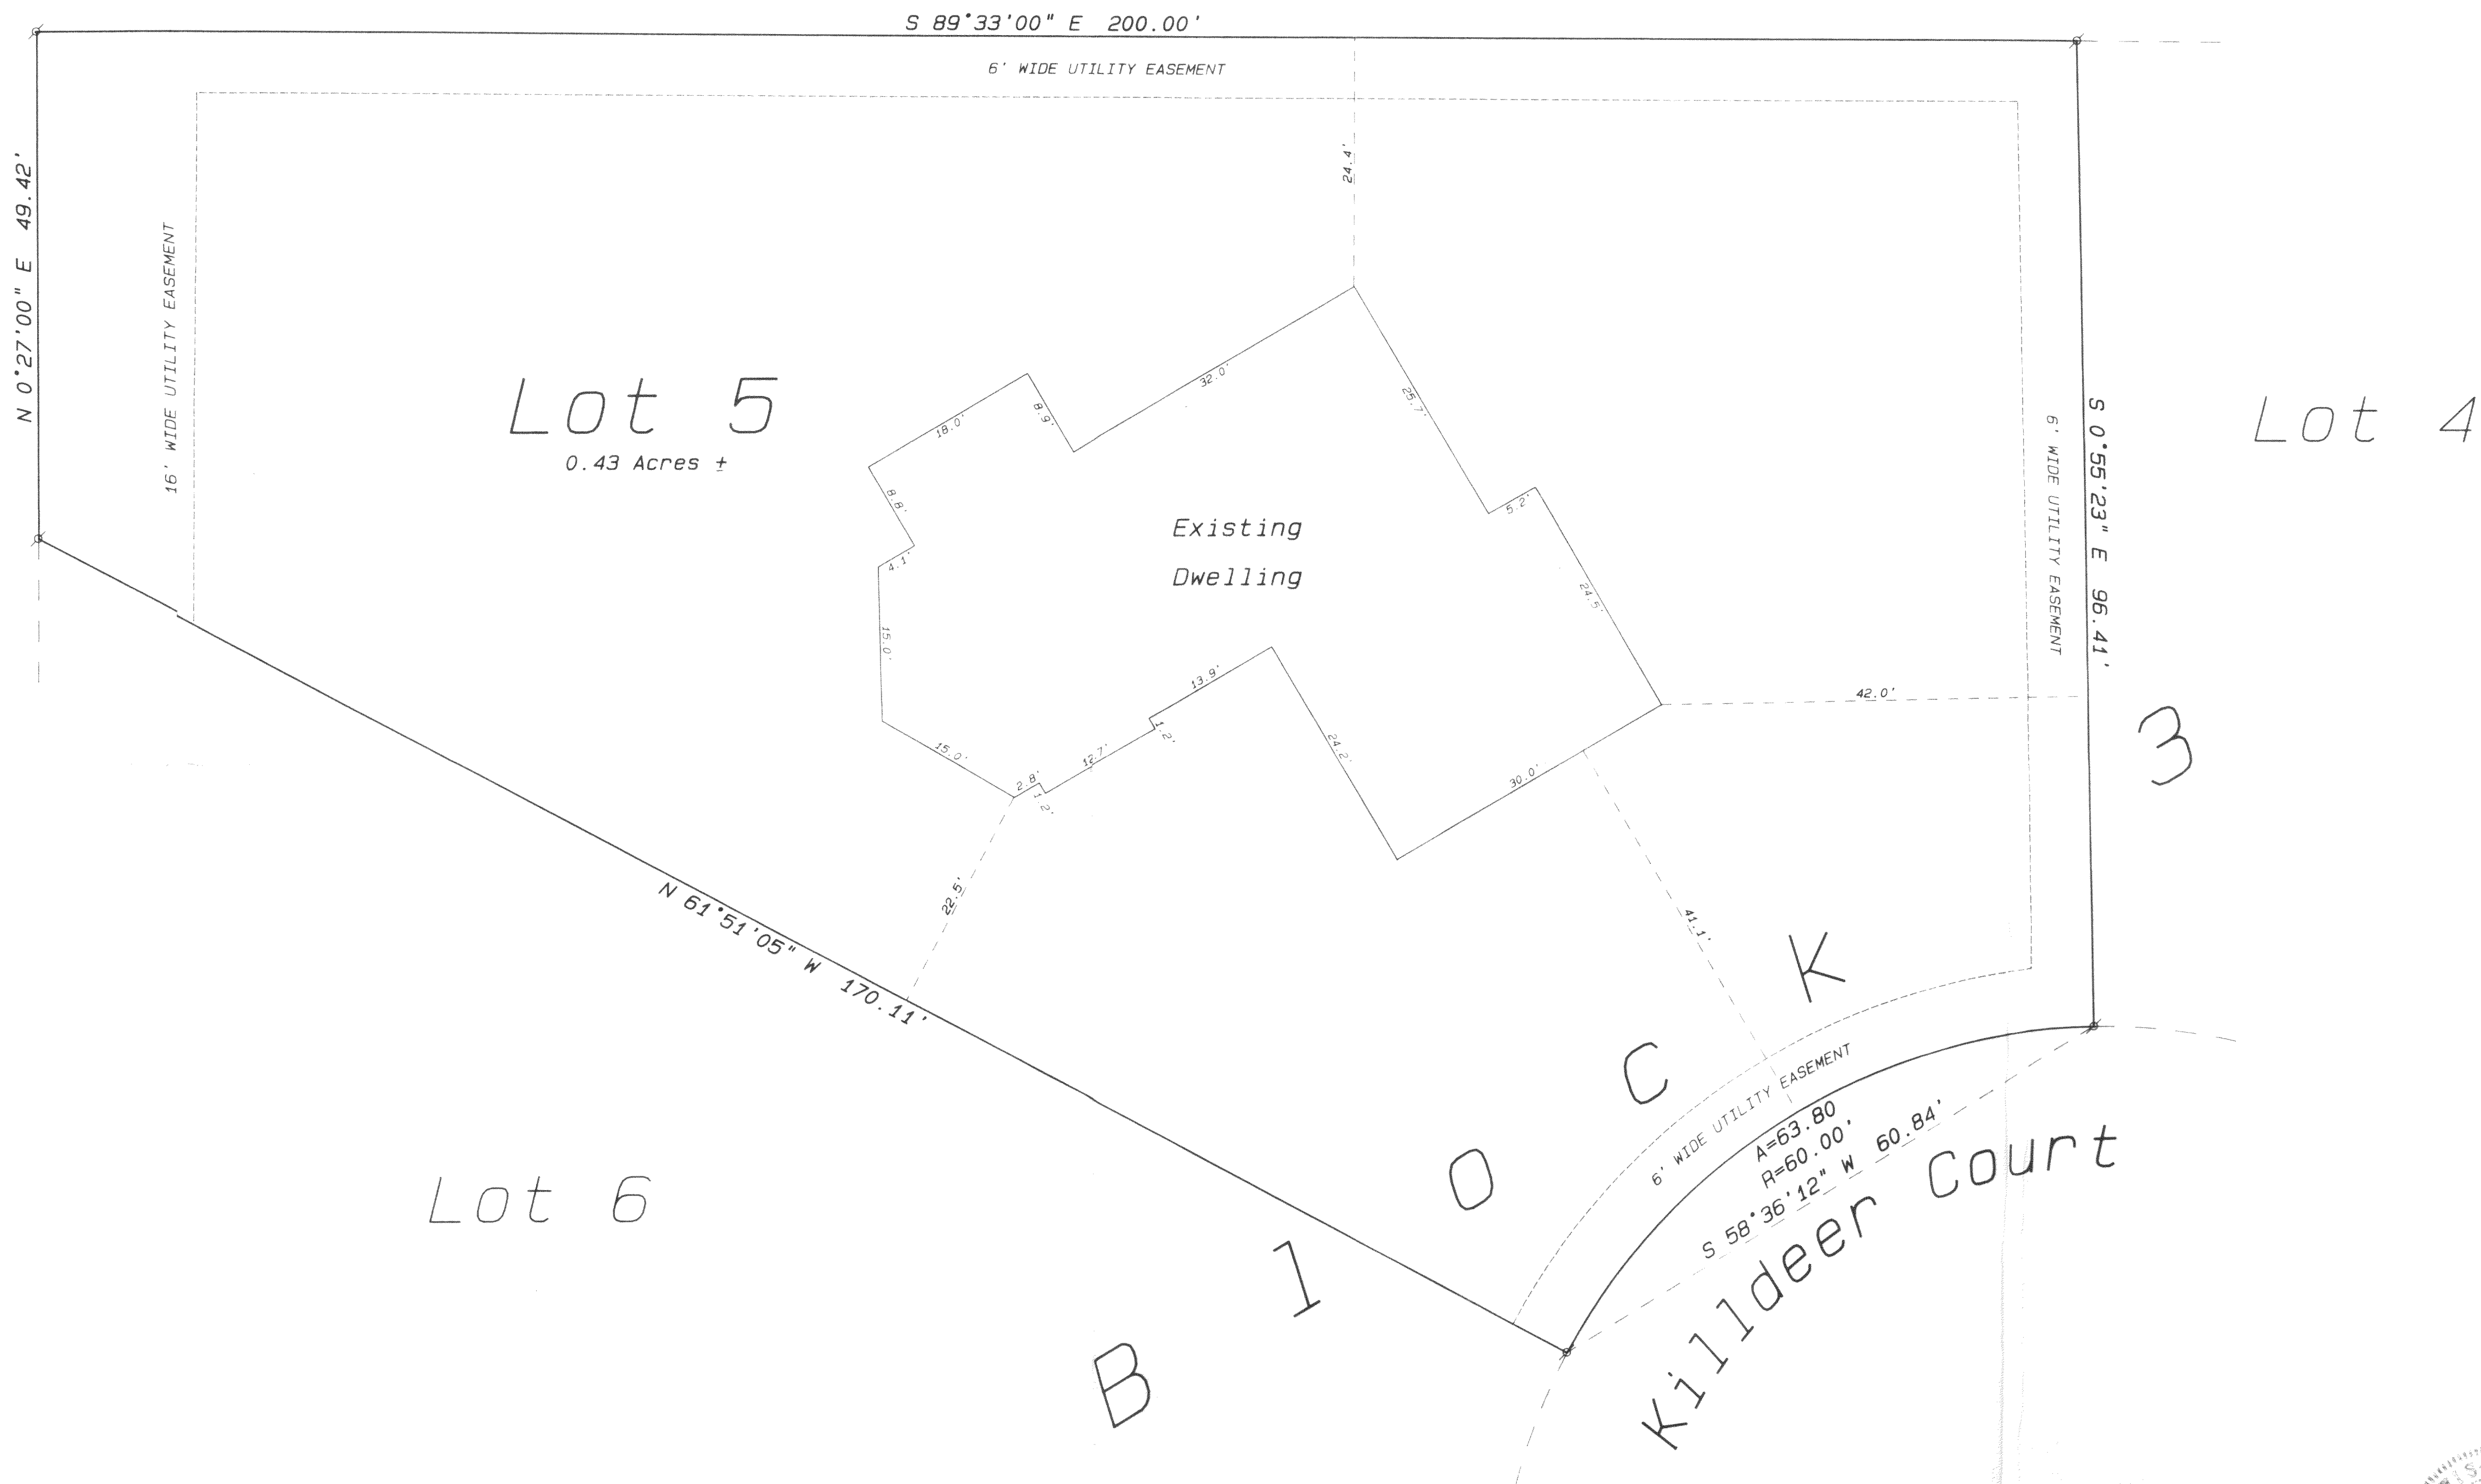

Ordered by: Dan Finke Construction
5870 Highway 36
Burlington, Wisconsin 53105

Legend

- FOUND IRON PIPE
- FOUND IRON ROD
- FOUND BRASS CAPPED MONUMENT
- FOUND CONCRETE MONUMENT
- CHISEL CUT IN CONCRETE
- SET IRON ROD: 24\"/>

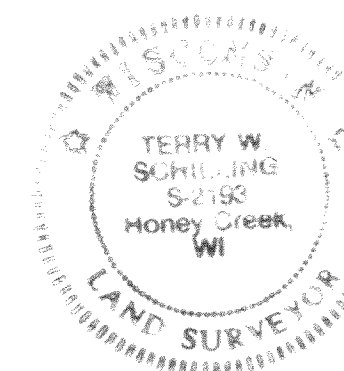

SCALE: 1\"/>

I hereby certify that the above described property has been surveyed
by me or under my direction and that the above map is a true
representation thereof and shows the size and location of the property,
its exterior boundaries, the location of all visible structures and
dimensions of all principal buildings thereon, boundary fences, apparent
easements, roadways and visible encroachments, if any.
This survey is made for the use of the present owners of the property
and also those who purchase mortgage or guarantee the title thereto
within one year from date hereof.

Terry W. Schilling
TERRY W. SCHILLING, WISCONSIN
REGISTERED LAND SURVEYOR S-2193

Date: September 12, 1994 Job No. 1994-801AB

