


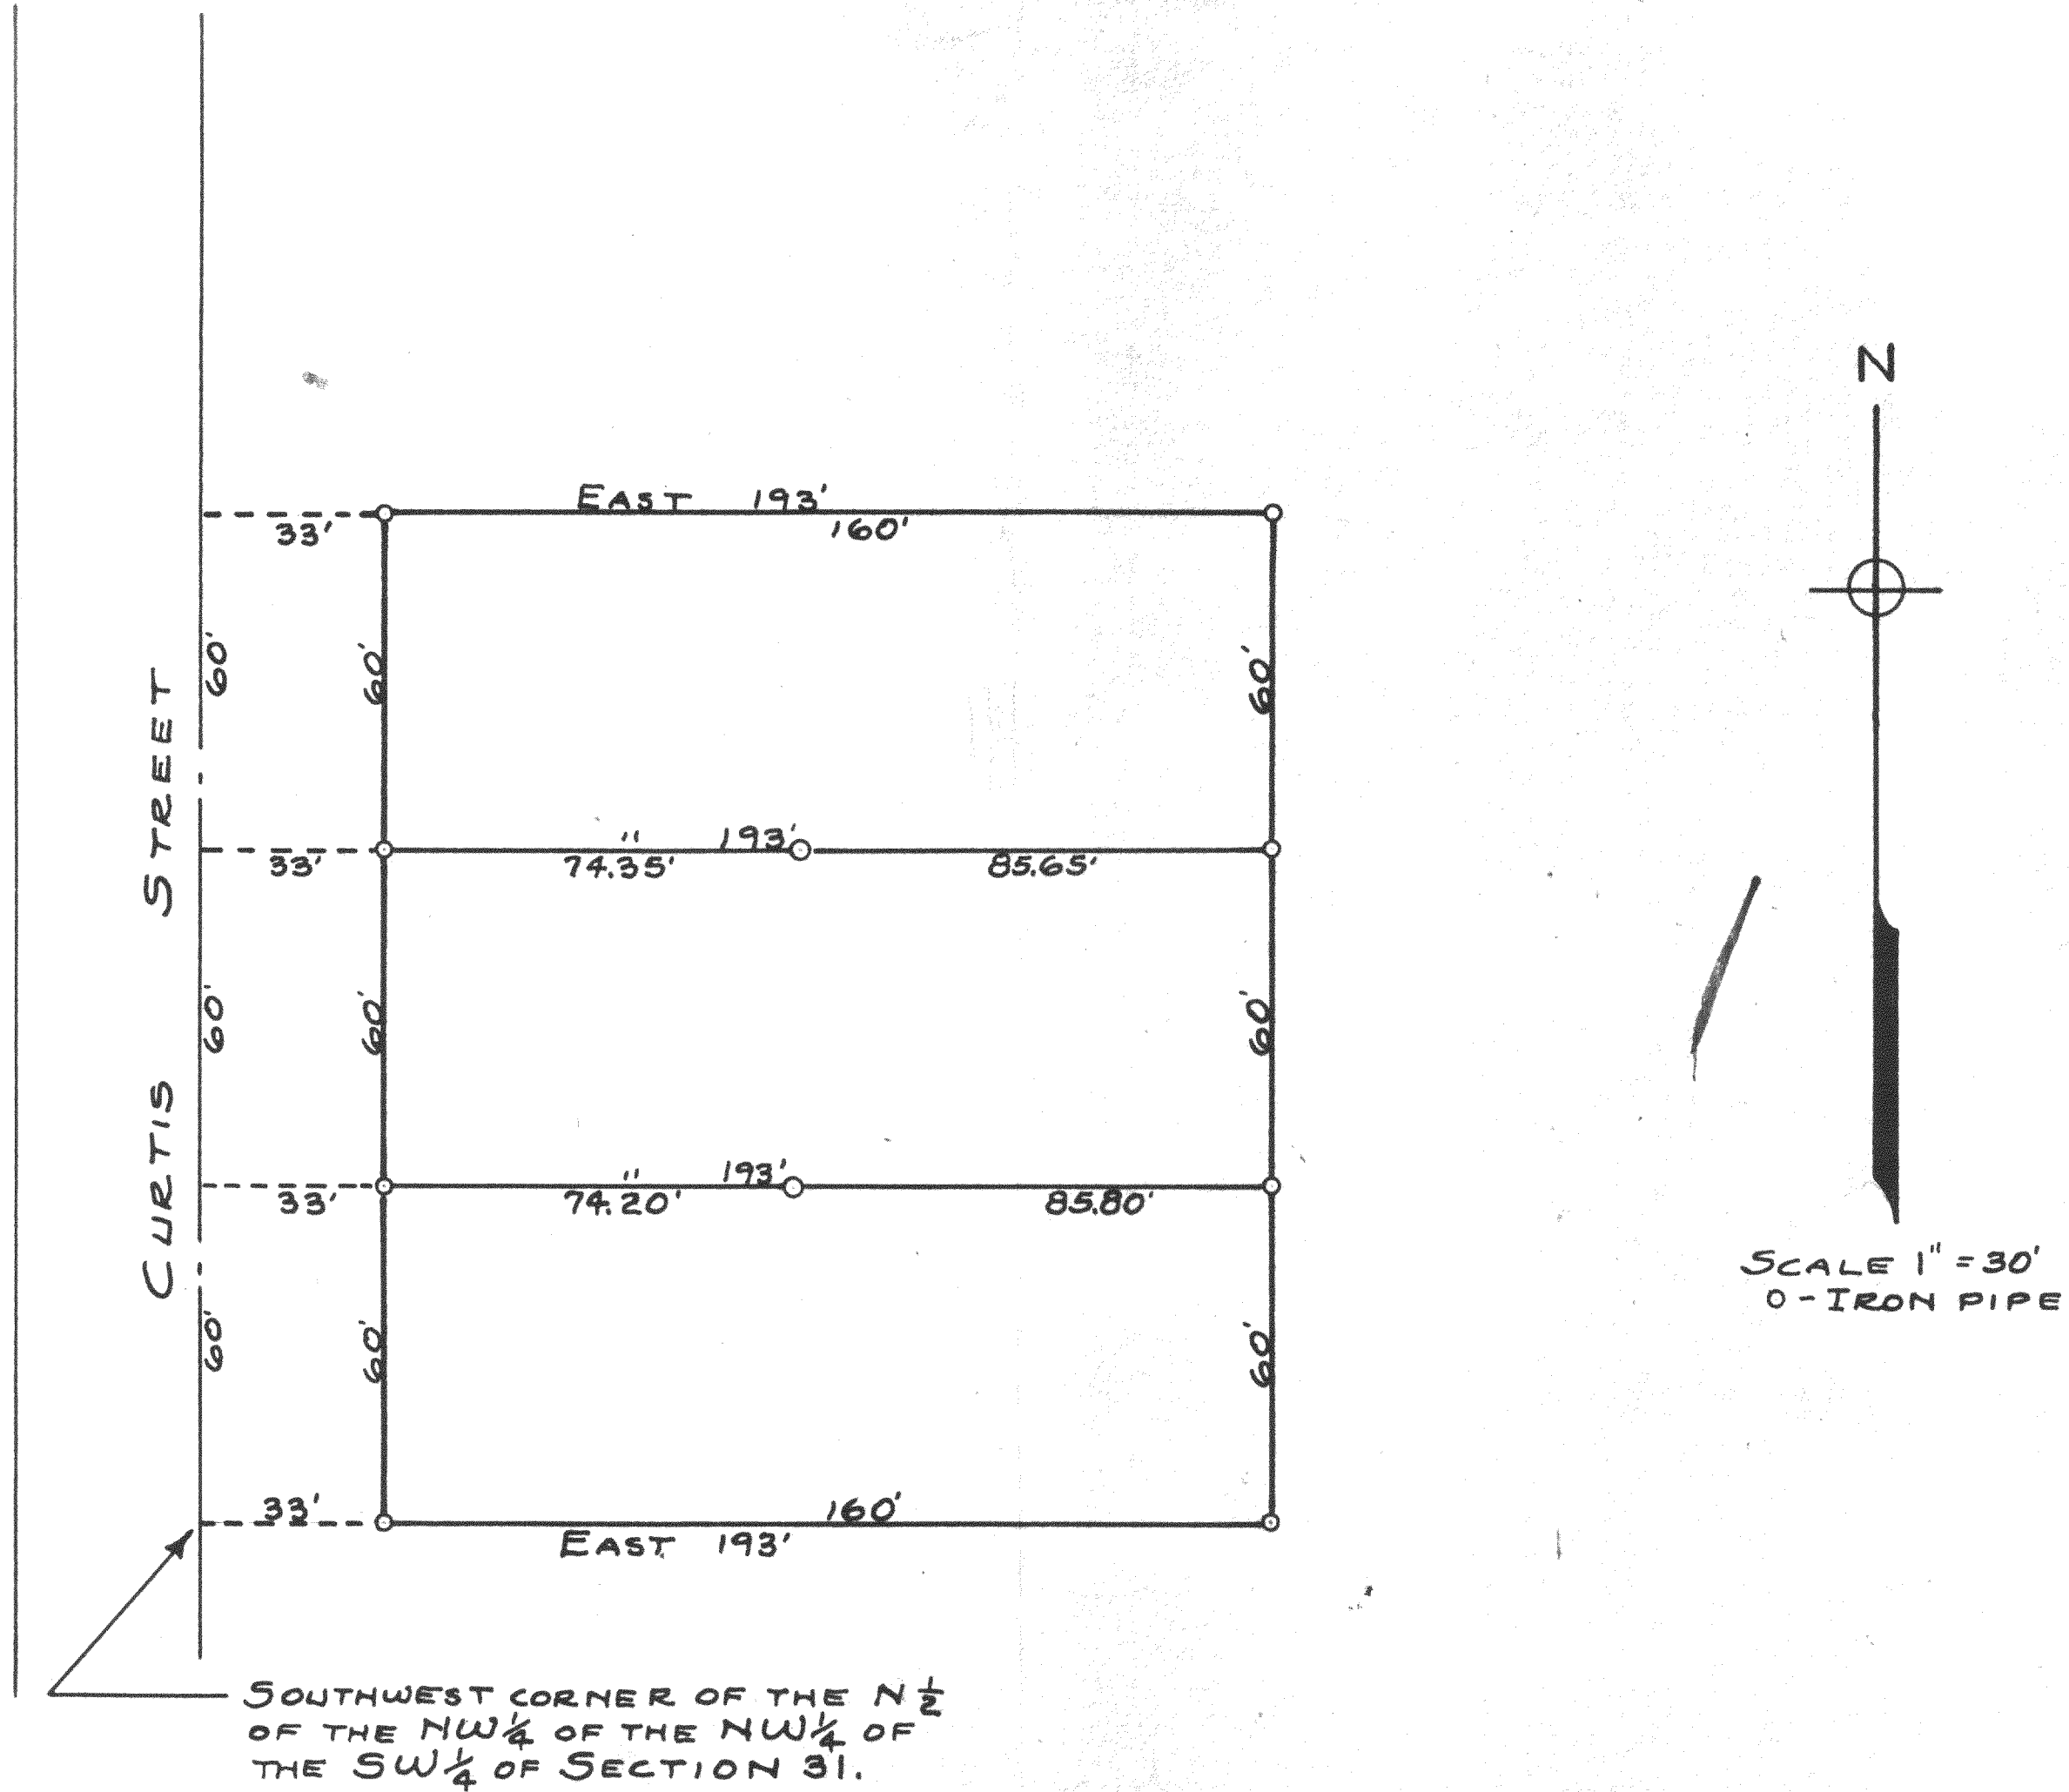

PLAT OF SURVEY OF LAND LOCATED IN
THE NORTH $\frac{1}{2}$ OF THE NORTHWEST $\frac{1}{4}$ OF
THE NORTHWEST $\frac{1}{4}$ OF THE SOUTHWEST
 $\frac{1}{4}$ OF SECTION 31, T2N R18E OF WALWORTH
COUNTY, WISCONSIN.

DEC. 1952

Lloyd L. Jensen
WALWORTH COUNTY SURVEYOR

218-8J

NLY 31-7A & P+ 214P 112
14-31-9 + part