


KOLB LAND CONSULTING, INC.
LAND SURVEYING • SUBDIVIDING • LAND PLANNING


929 WILLIAMS STREET

LAKE GENEVA, WISCONSIN 53147

414 248 3697

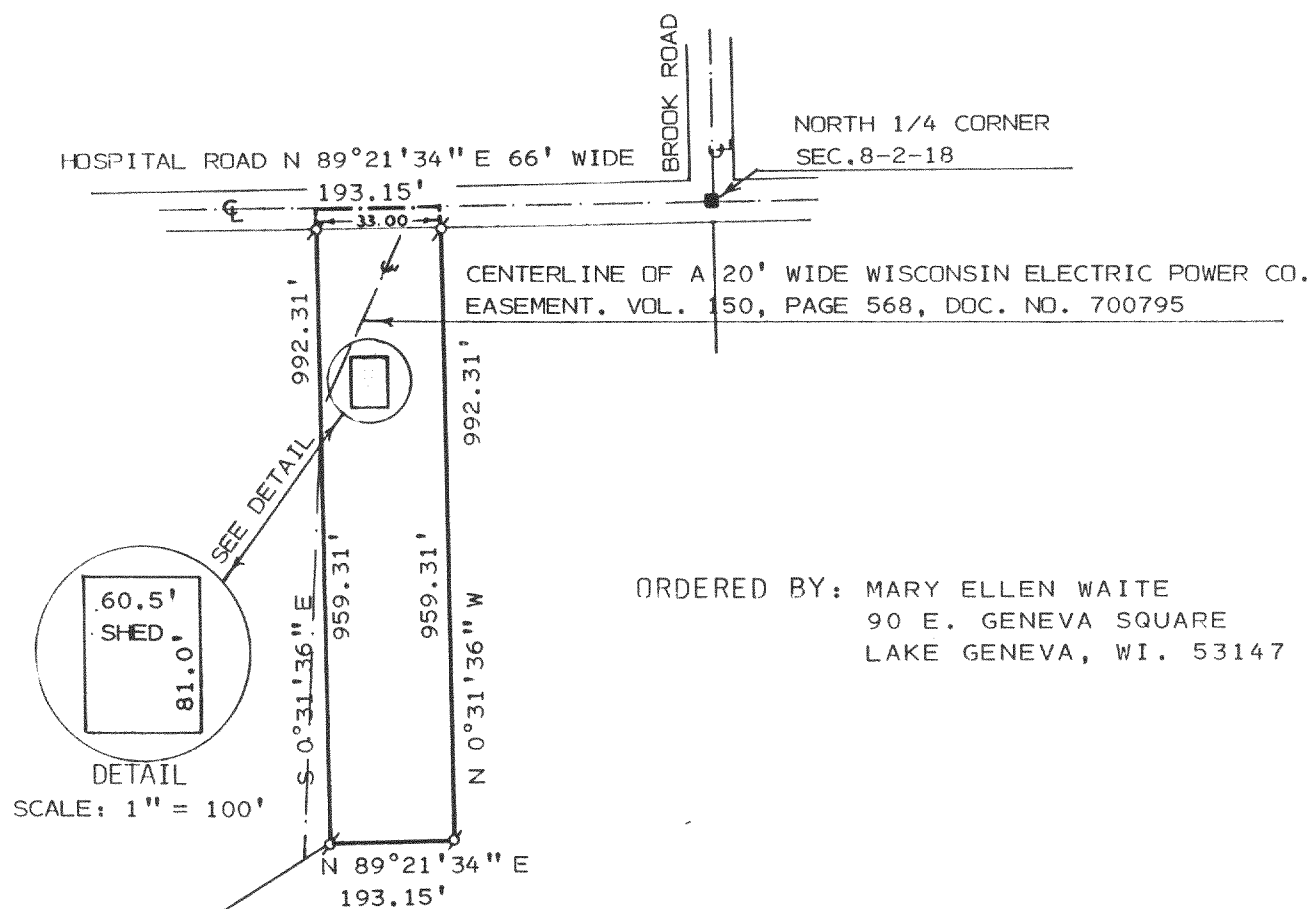

PLAT OF SURVEY OF

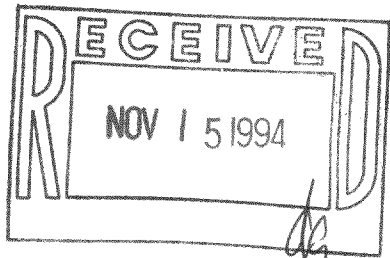


A PARCEL OF LAND LOCATED IN THE NORTHWEST
1/4 OF SECTION 8, T2N, R18E, TOWN OF LYONS,
WALWORTH COUNTY, WISCONSIN.

NOTE: BEARINGS ARE ASSUMED AS SHOWN ON
PREVIOUS SURVEY RECORDS.

LEGEND

- ⌀ - IRON PIPE FOUND
■ - CONC. MONUMENT FOUND

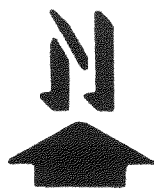

SCALE: 1" = 300'

I, HAROLD H. KOLB, DO HEREBY CERTIFY
THAT I HAVE SURVEYED THE PROPERTY
HEREON DESCRIBED ACCORDING TO THE
OFFICIAL RECORDS AND THAT THE PLAT
HEREON IS A CORRECT REPRESENTATION
OF THE LOT LINES TO THE BEST OF MY
KNOWLEDGE AND BELIEF.
SURVEY NOT VALID UNLESS SURVEYOR'S SIGNATURE
IS IN RED.

HAROLD H. KOLB

WISCONSIN REGISTERED LAND SURVEYOR, S 137

DATE JANUARY 6, 1993

REVISED

REVISED

2-18-LY-8-283 788

NA-2525-1

218-806