



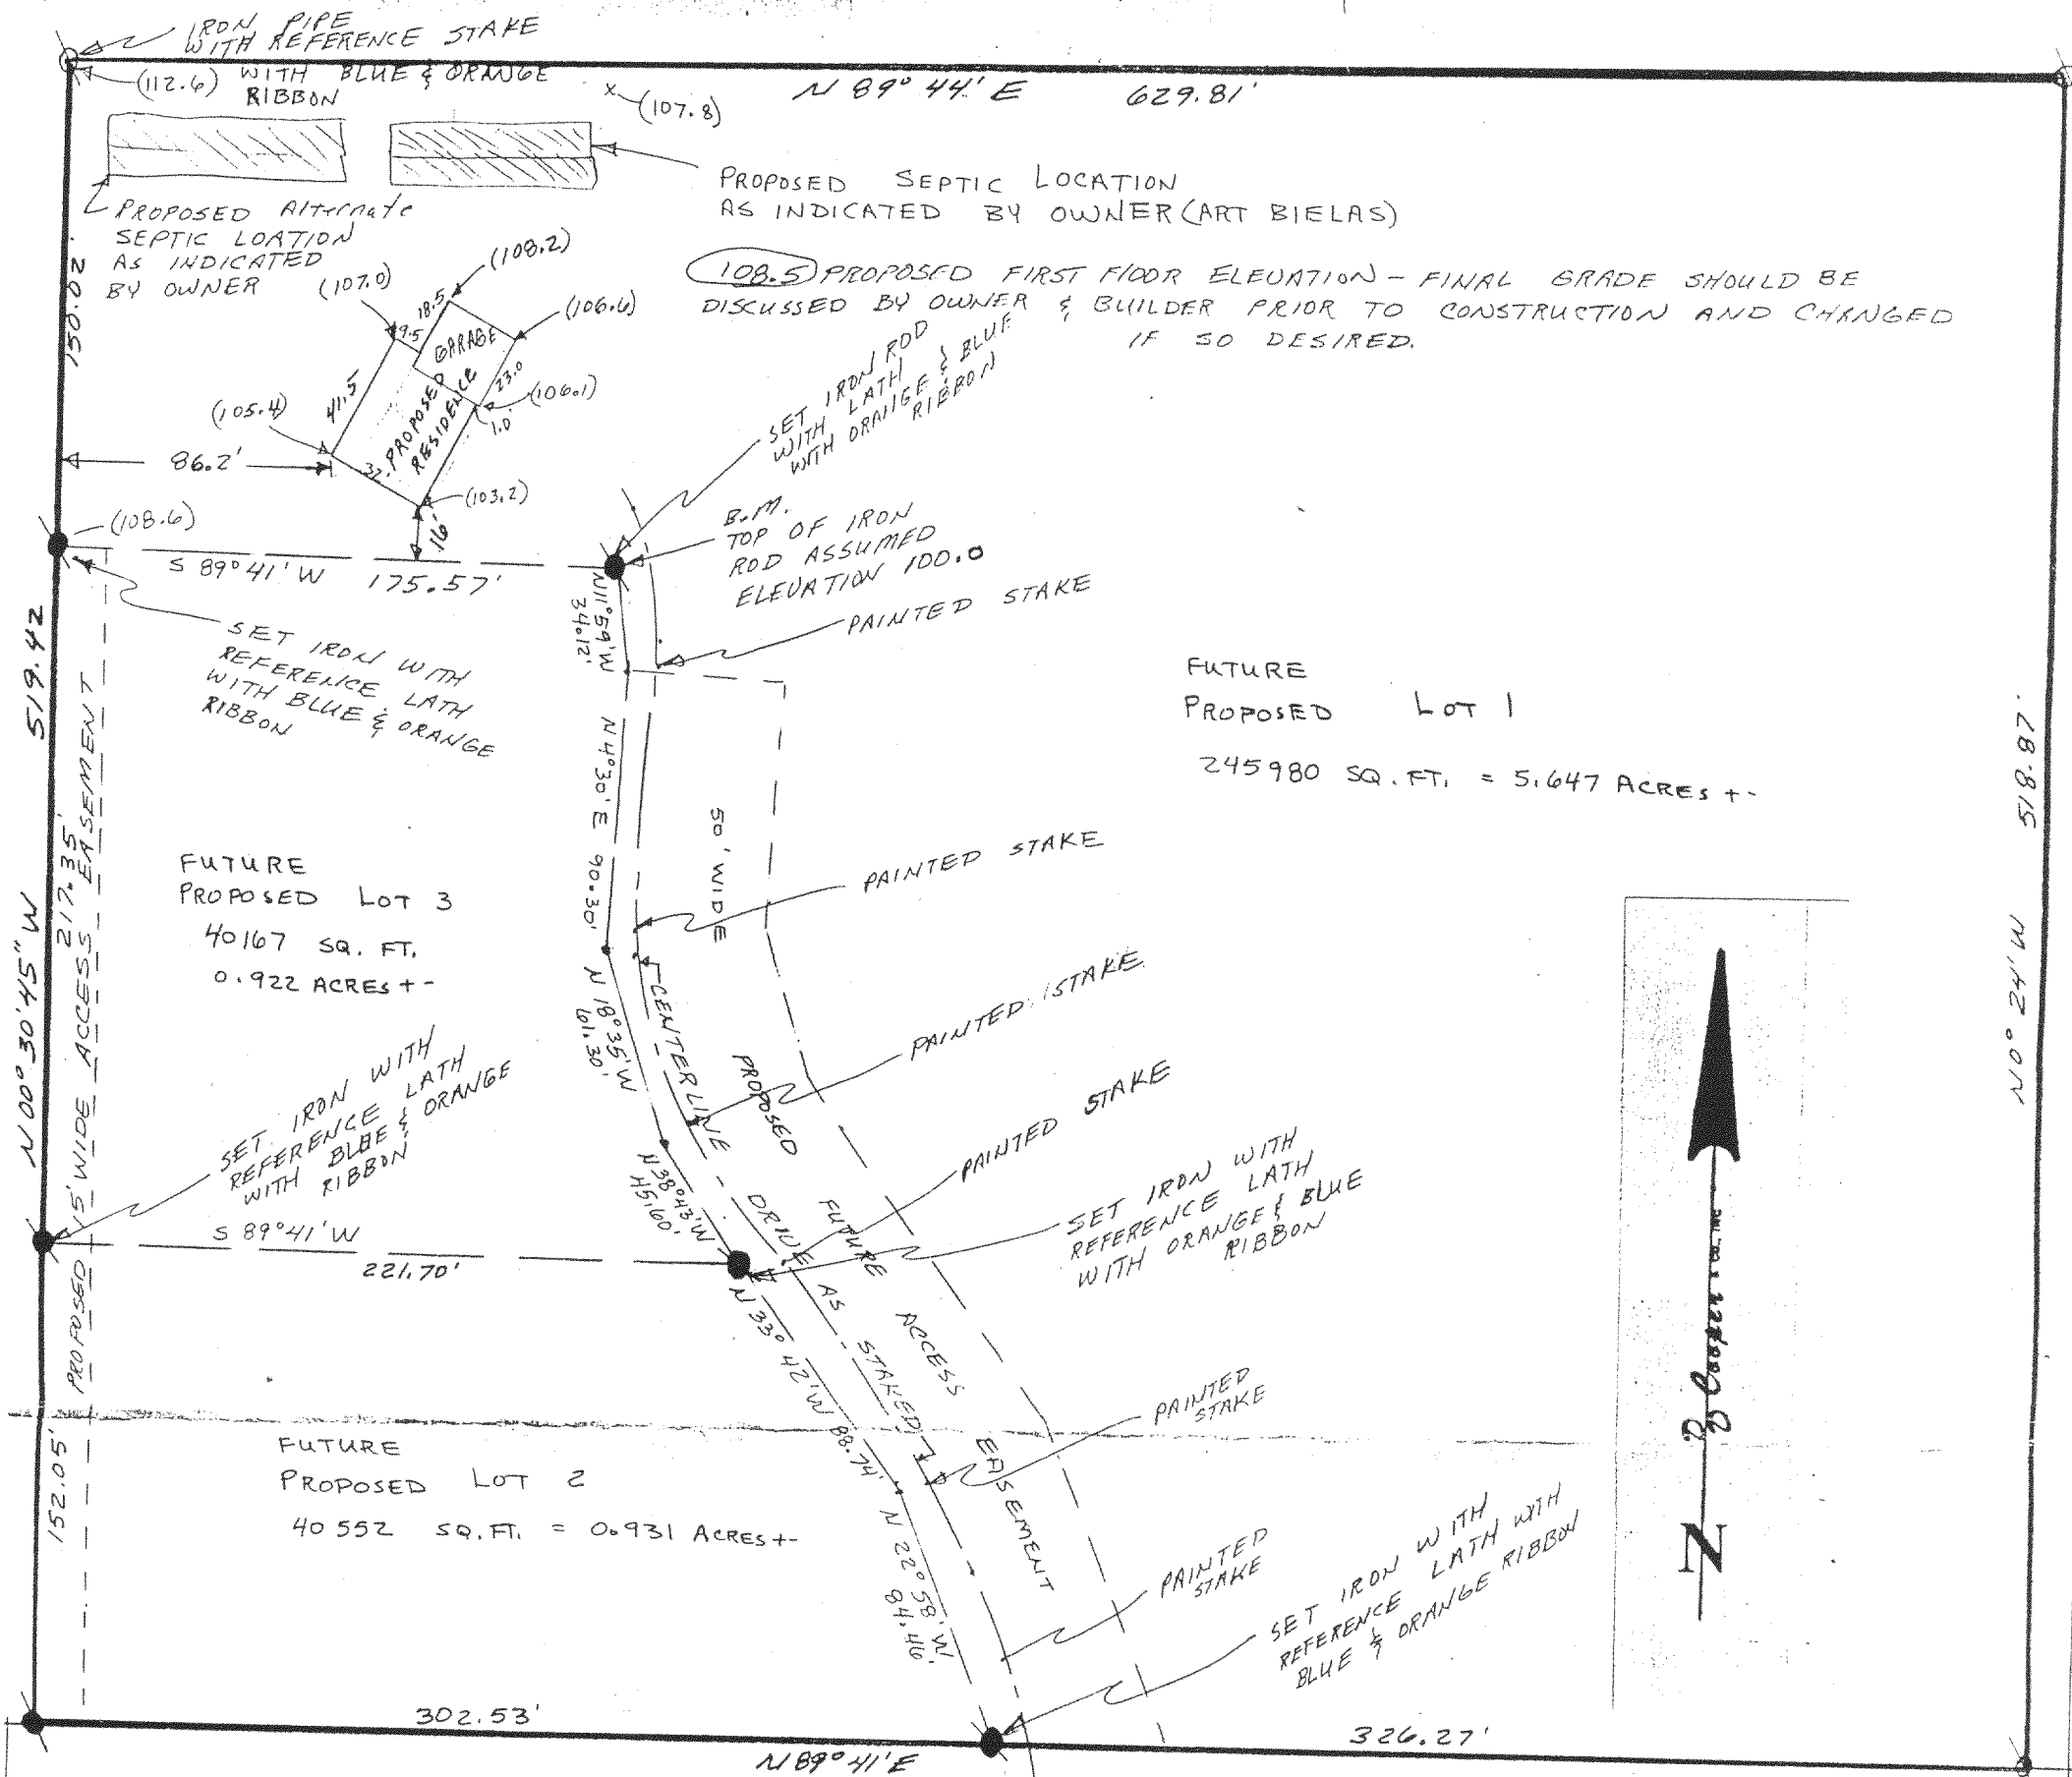

Plat of Survey of Outlot 4 of Springfield Subdivision, located in Section 7, T2N, R18E, Walworth County, Wisconsin.

Bearing Reference: Northerly line of High Street assumed to Bear N89°41'E

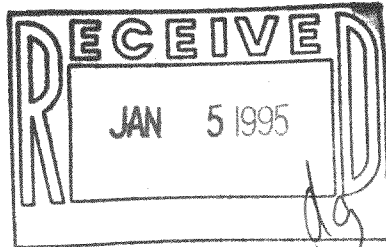

Received from Arthur Bielas
January 5, 1995
@ 3:00 pm
Dawn Grinn


Survey ordered by Arthur Bielas
Rt 1 Box 660
Genoa City WI
53128

- (X) - EXISTING GROUND ELEVATIONS.
- Indicates iron pipe found
- Indicates iron rod found
- Indicates 5/8" x 24" iron rod set

I hereby certify that I have surveyed the property described hereon and that the map shown hereon is a true and accurate representation thereof to the best of my professional knowledge and belief.

Dated this 23rd day of March, 1990

Daniel D. Cooper
Daniel D. Cooper, RLS No. S-1464

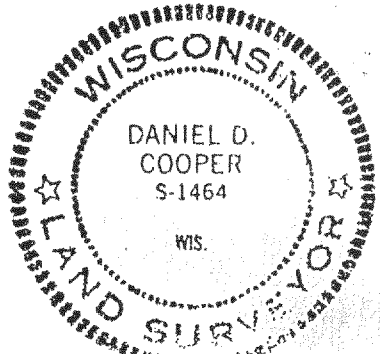


Scale: 1" = 60'

NUS-82
NUS-83


UP DATE 4-6-1990

CREEK

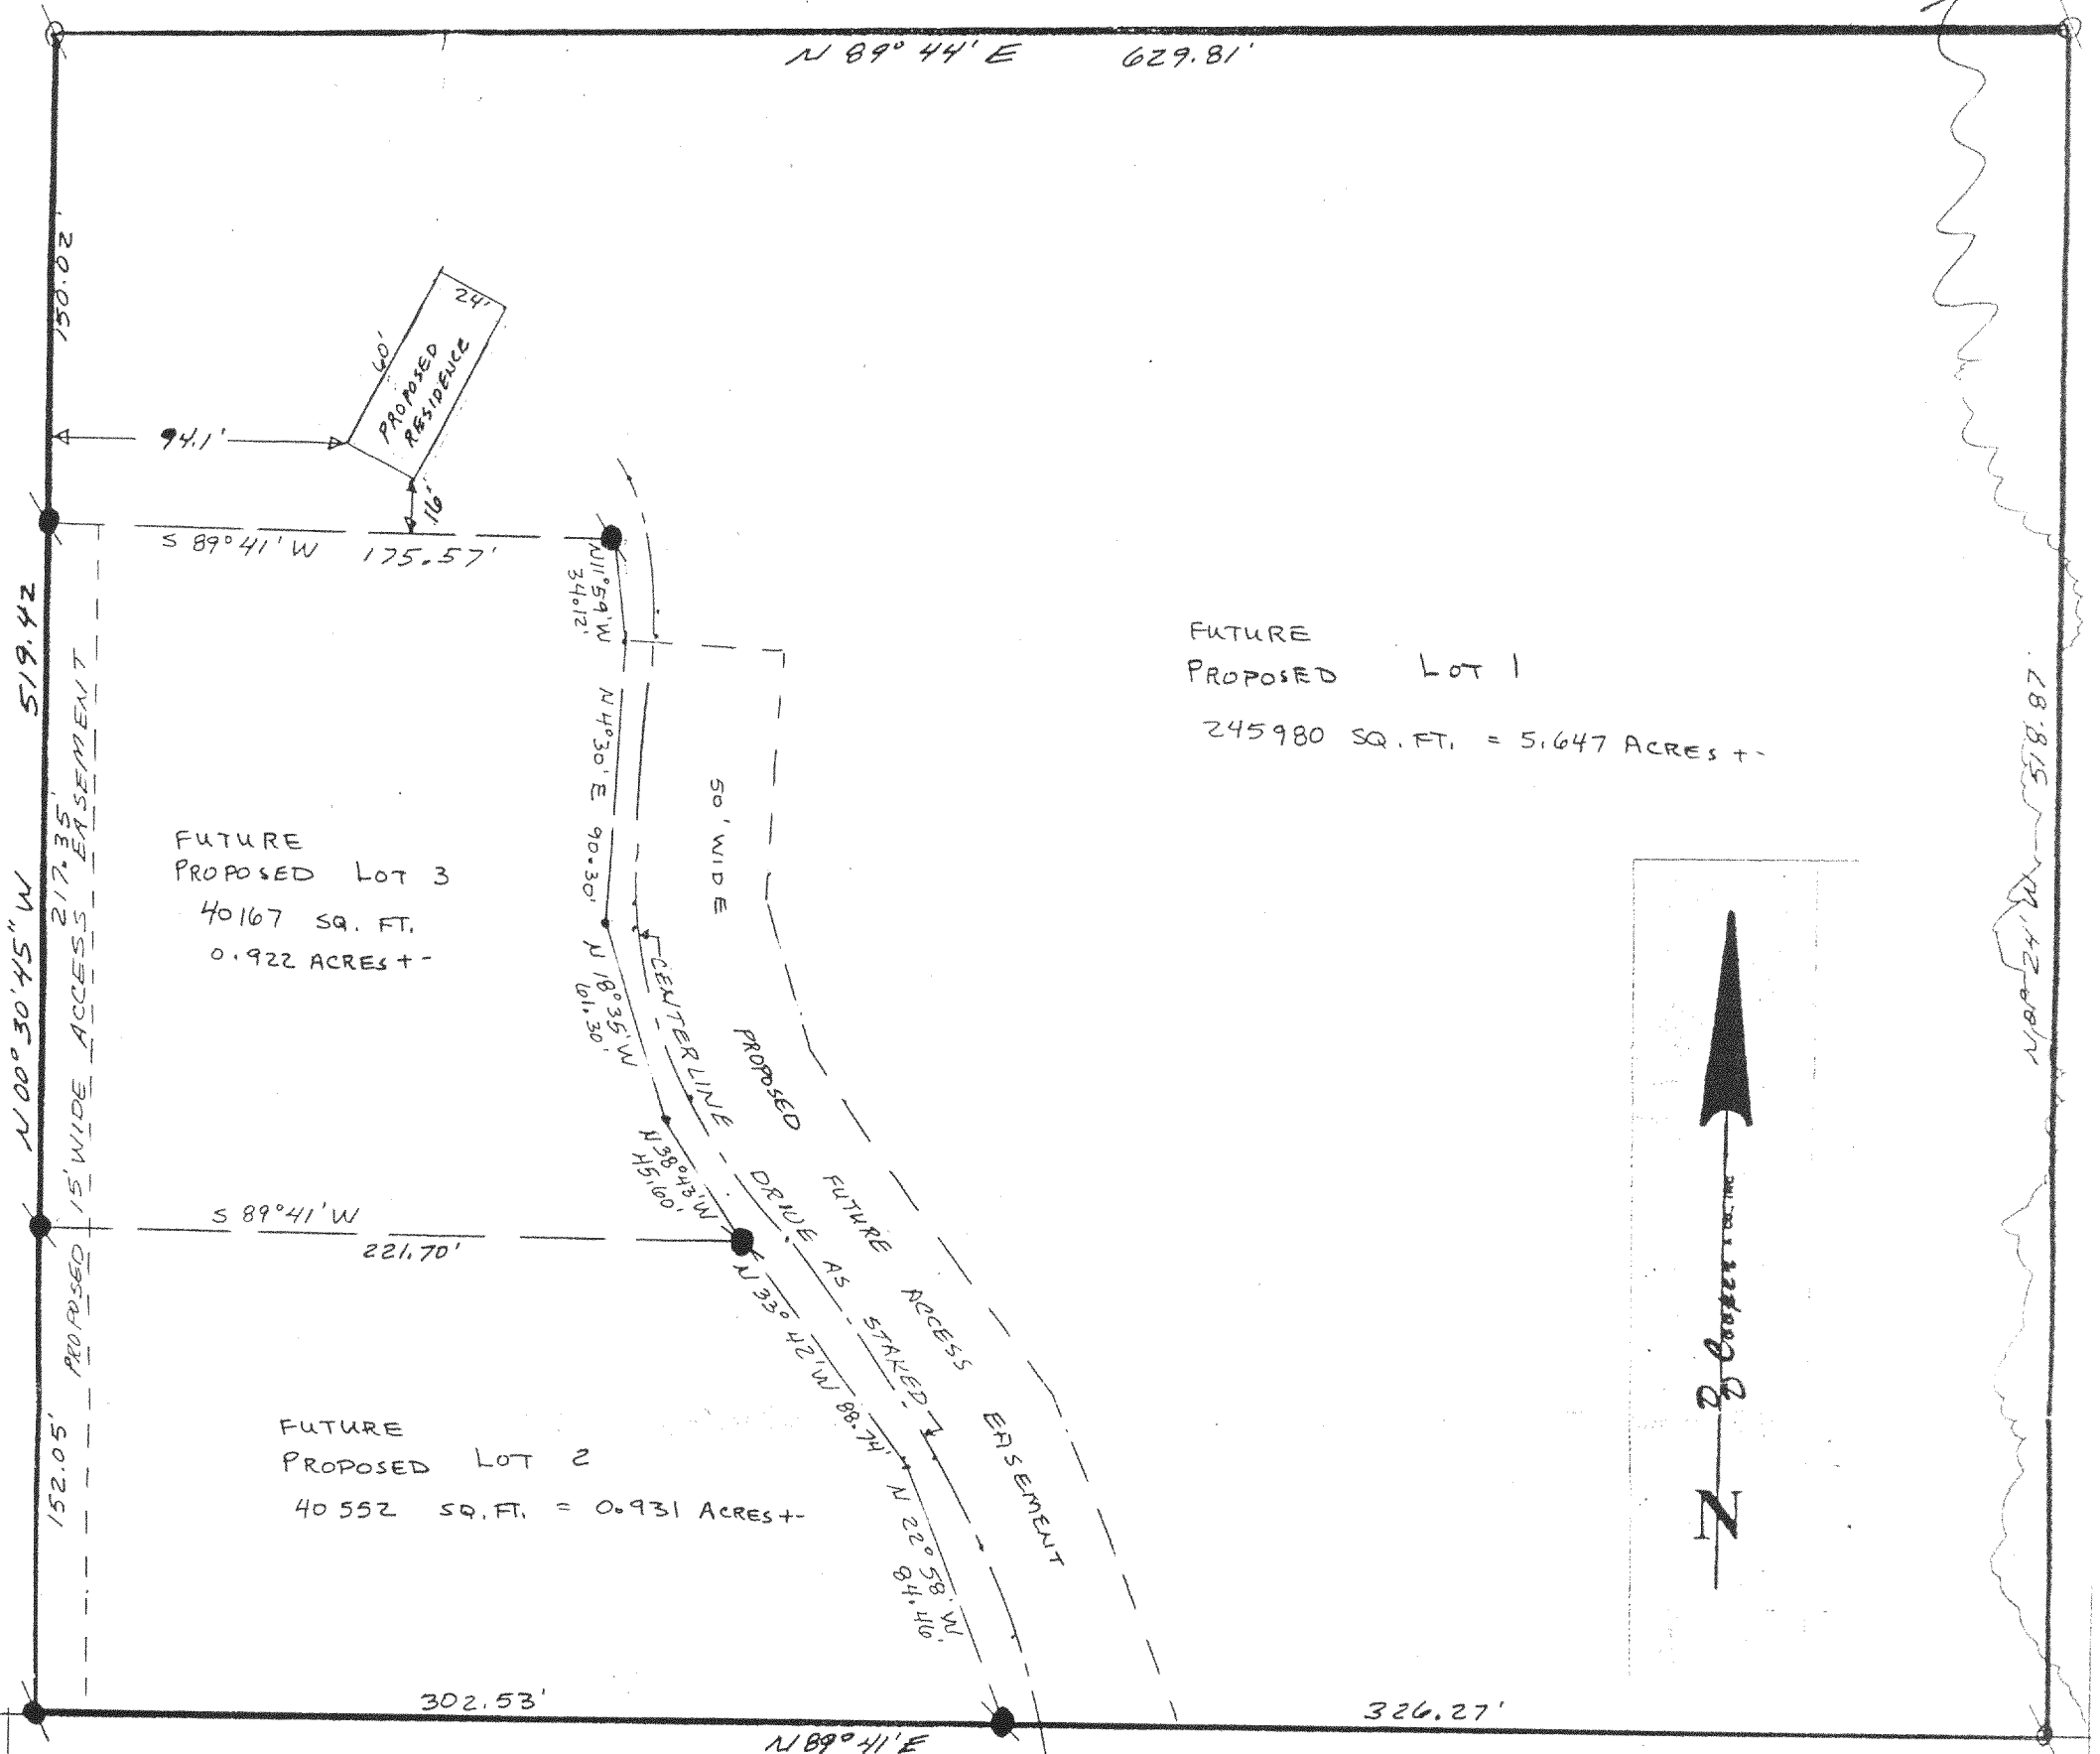

Plat of Survey of Outlot 4 of Springfield Subdivision, located in Section 7, T2N, R18E, Walworth County, Wisconsin.

Bearing Reference: Northerly line of High Street assumed to Bear N89°41'E

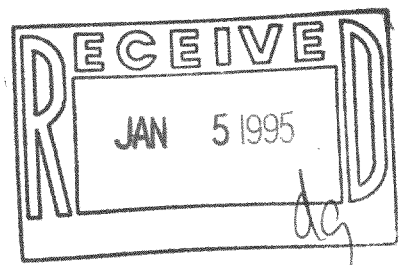


Survey ordered by Arthur Bielas
Rt 1 Box 660
Genoa City WI
53128

I hereby certify that I have surveyed the property described hereon and that the map shown hereon is a true and accurate representation thereof to the best of my professional knowledge and belief.

Dated this 23rd day of March, 1990



Daniel D. Cooper
Daniel D. Cooper, RLS No. S-1464

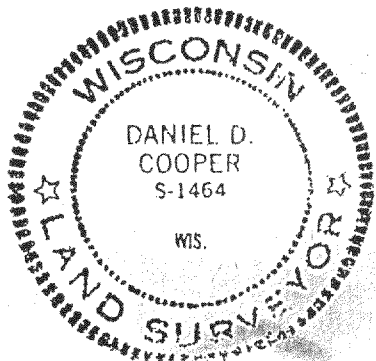

- ⊗ Indicates iron pipe found
- Indicates iron rod found
- Indicates 5/8" x 24" iron rod set

Scale: 1" = 60'

BEARING REFERENCE

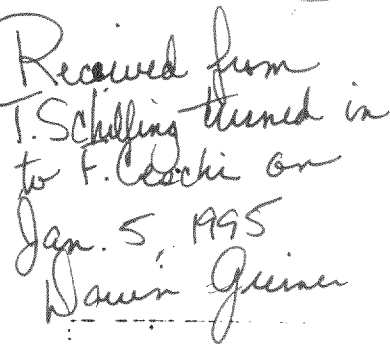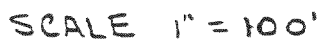

Dated this 17th day of June, 1983

WISCONSIN

DANIEL D.
COOPER

S-1454

~~EAST TROY,~~
WIS.

LAND SURVEY

REVISED THIS 12 DAY OF AUG., 1993 TO CORRECT BEARING OF NORTHERLY
LINE FROM N 89° 41' E TO N 89° 44' E DANIEL D. Coon