

PLAT OF SURVEY
OF

LINE BETWEEN LOTS 1 & 2, IN RUEDEBUSCH PINES SUBDIVISION IN
SECTION 12-2-18 LYONS, WALWORTH COUNTY, WISCONSIN.

SCALE 1" = 50'

BEARINGS RELATE TO RECORDED PLAT DATUM.

⊠ = 2" IRON PIPE FOUND

FOR: UHEN

○ = 1" OD IRON PIPE FOUND.

○ = 1" OD IRON PIPE SET.




● = SOLID IRON ROD FOUND.

✕ = SEWER VENT.

I have caused to be surveyed and plotted the line between Lots 1 & 2, in Ruedebusch Pines Subdivision in Section 12-2-18 Lyons, Walworth County, Wisconsin, and the same is shown on the attached map. The survey was made by John F. Degen, a Licensed Land Surveyor in the State of Wisconsin, and the same is shown on the attached map. The survey was made for the purpose of showing the line between Lots 1 & 2, and the same is shown on the attached map. The survey was made for the purpose of showing the line between Lots 1 & 2, and the same is shown on the attached map.

This survey is made for the exclusive use of the present owners of the property, and also those who purchase, mortgage, or guarantee the same thereto, within one year from date hereof.

Burlington, this 30th day,
of December 1994.
John F. Degen
1589 N. Pine St. Burlington, WI 53105

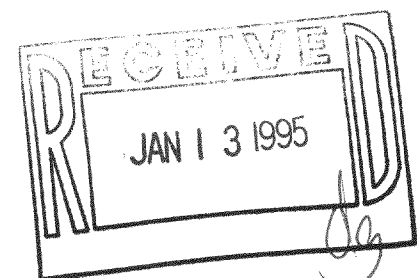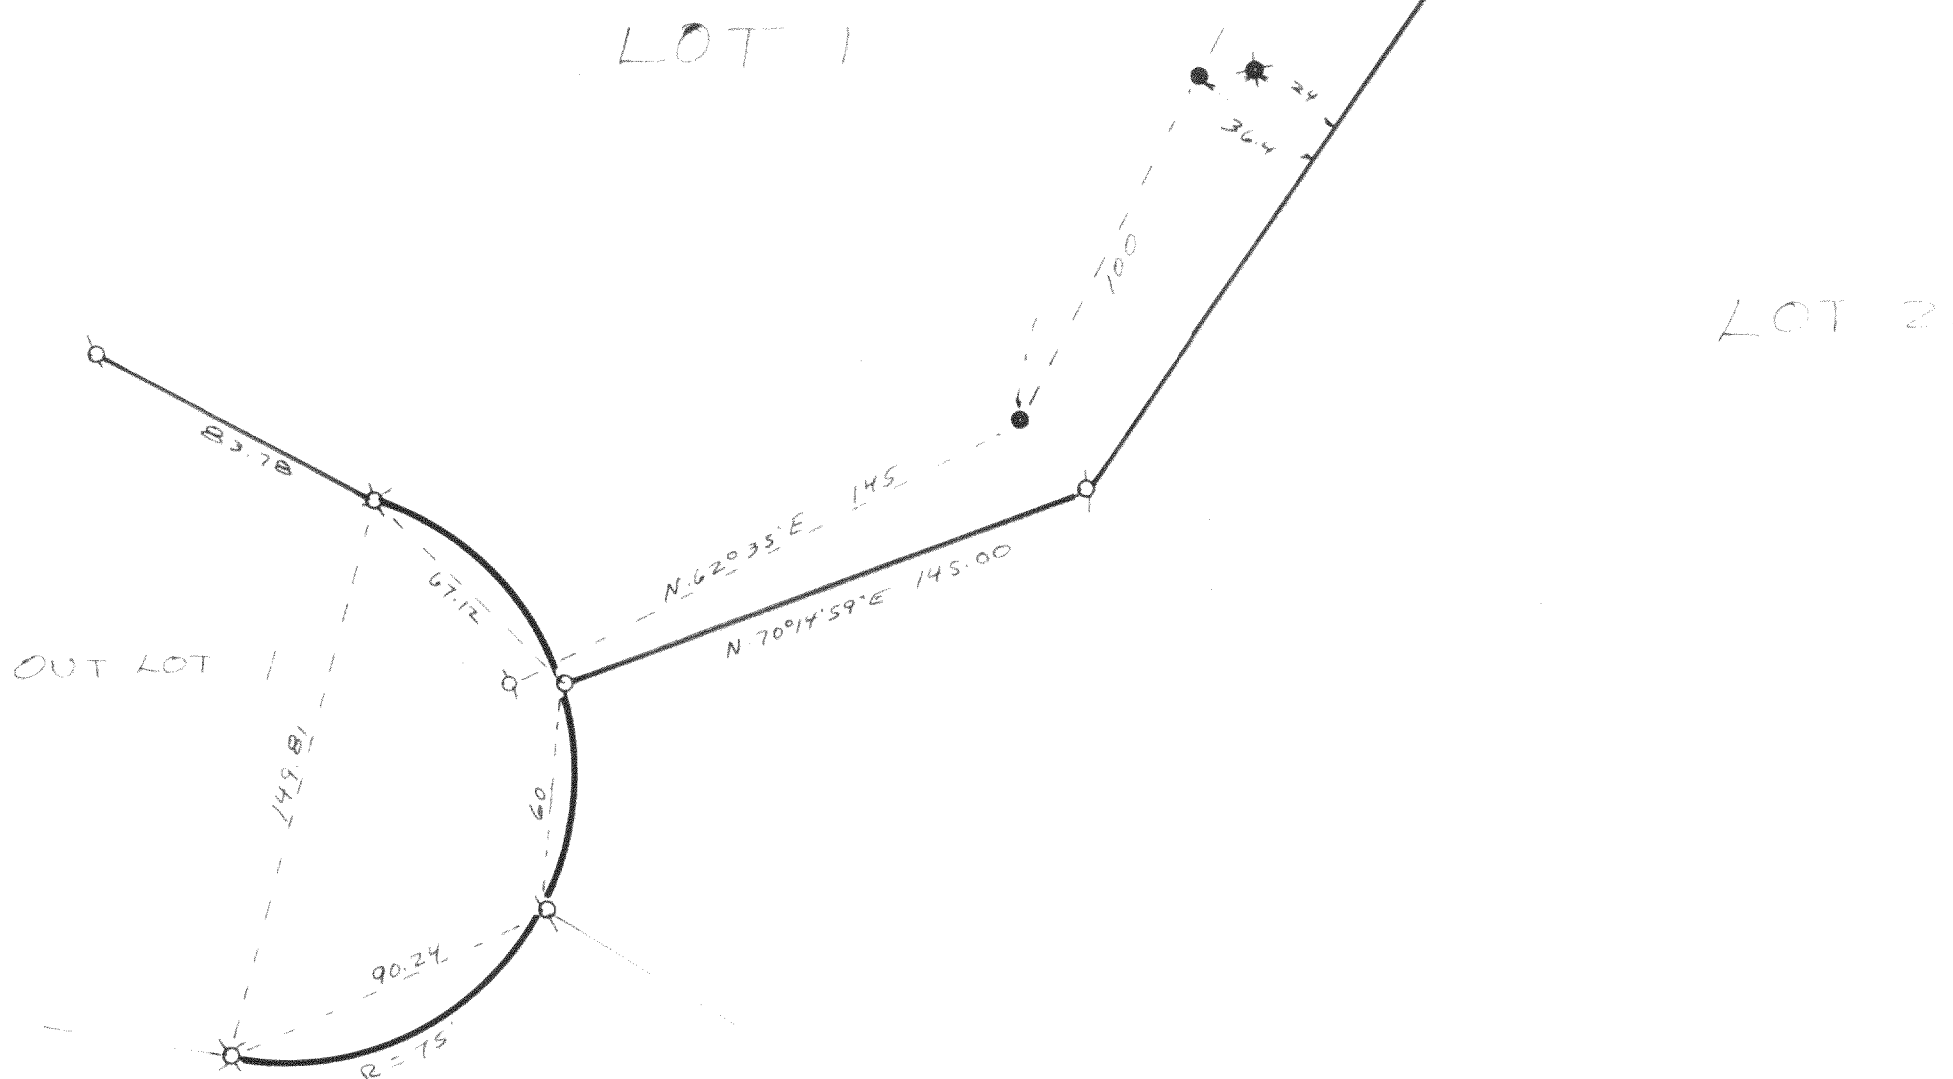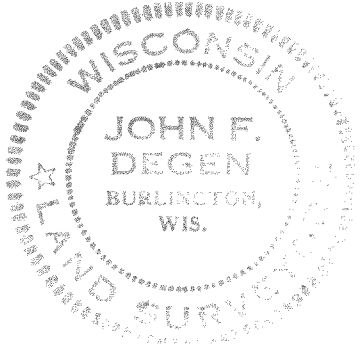

218-824