



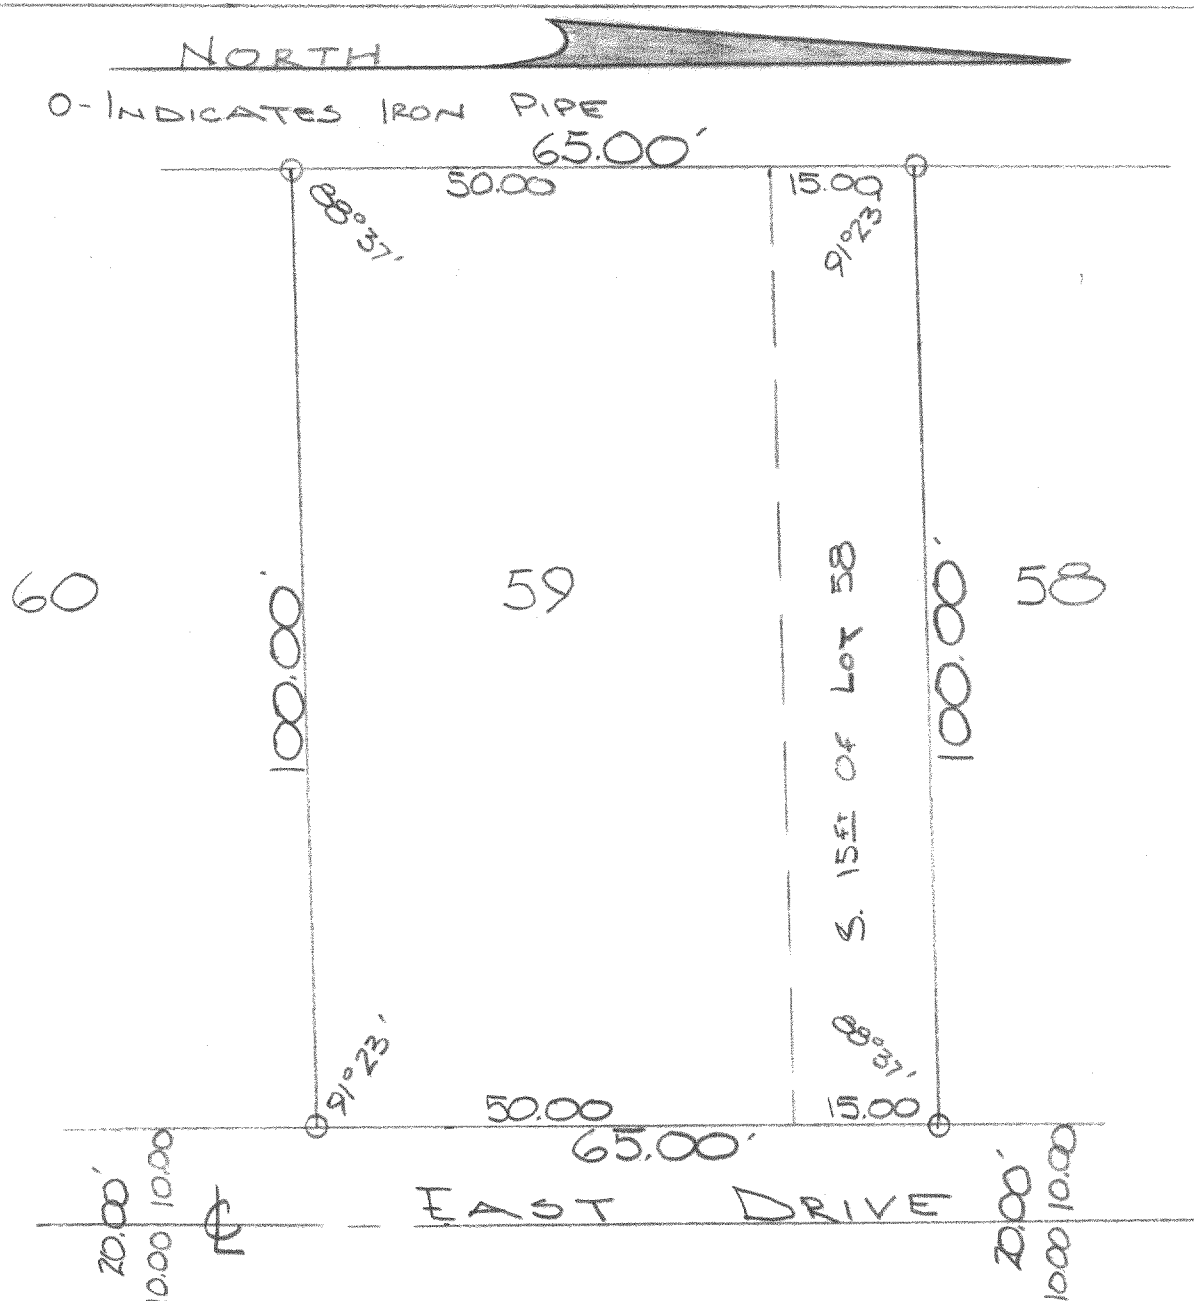

DESCRIPTION: Lot 59 and the South 15.00 feet of Lot 58 of Golf Hills Subdivision located in Section 31, T. 2 N., R. 18 E., Walworth County, Wisc.

CERTIFICATE: I, James F. Biagi, surveyor, do hereby certify that I have surveyed the property hereon described on this 9th day of December 1961.

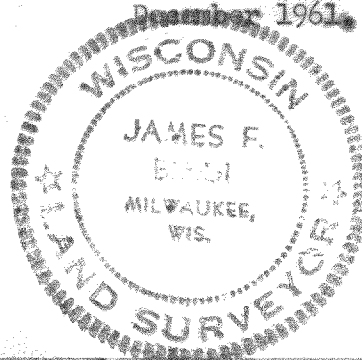

James F. Biagi 272