

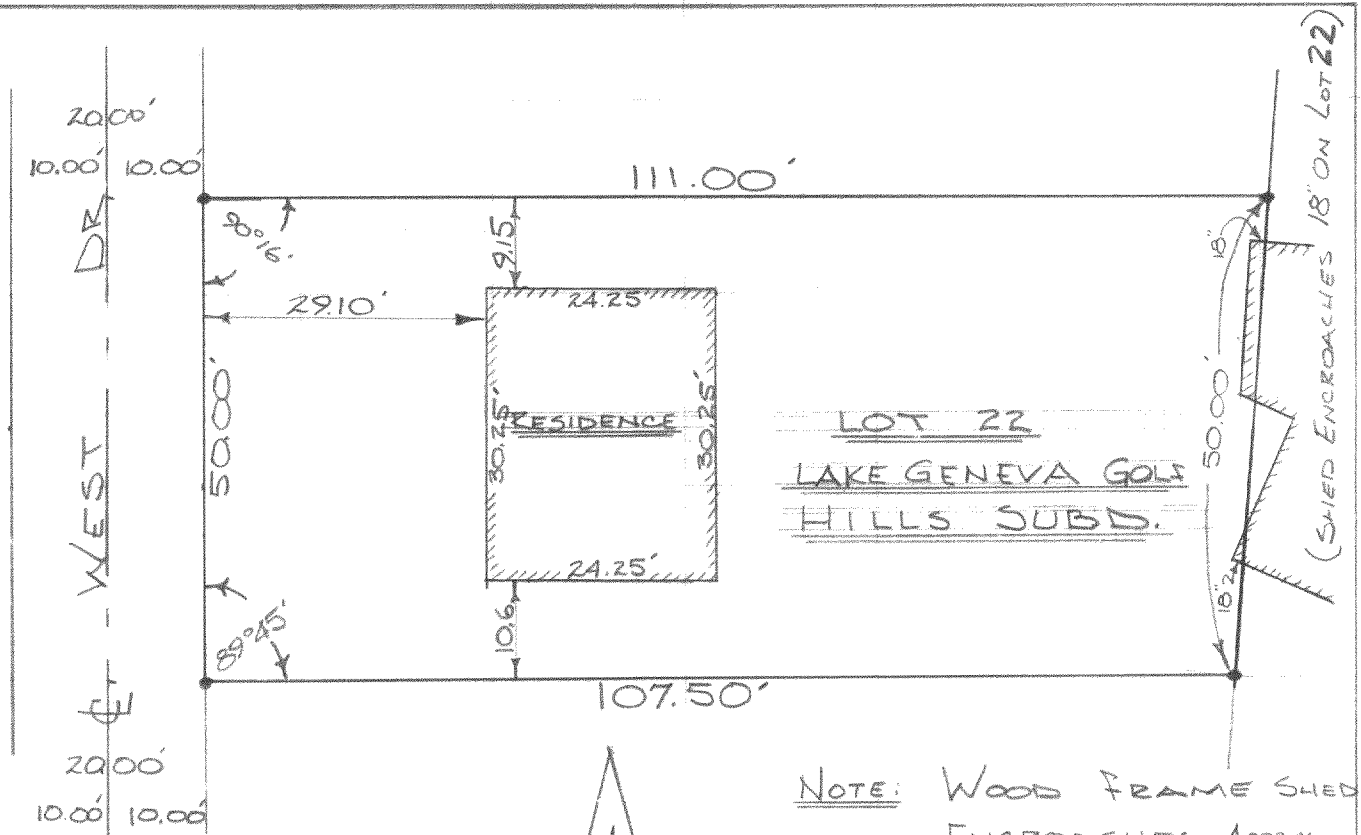


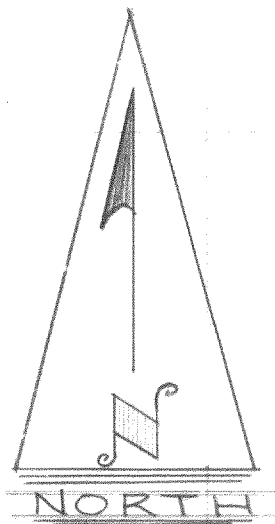

NOTE: WOOD FRAME SHED
ENCROACHES APPROX.
18" ON LOT 22

•-INDICATES IRON PIPE

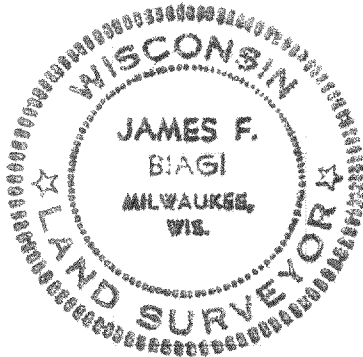

DESCRIPTION: Lot 22 of Lake Geneva Golf Hills Subdivision located in
Section 31 of T. 2 N., R. 18 E. Walworth County, Wisconsin.

CERTIFICATE: I, James F. Biagi, surveyor, do hereby certify that I have
surveyed the property hereon described and that the location
of the improvements are as shown.

May 1, 1965.

James F. Biagi
James F. Biagi RLS 272