


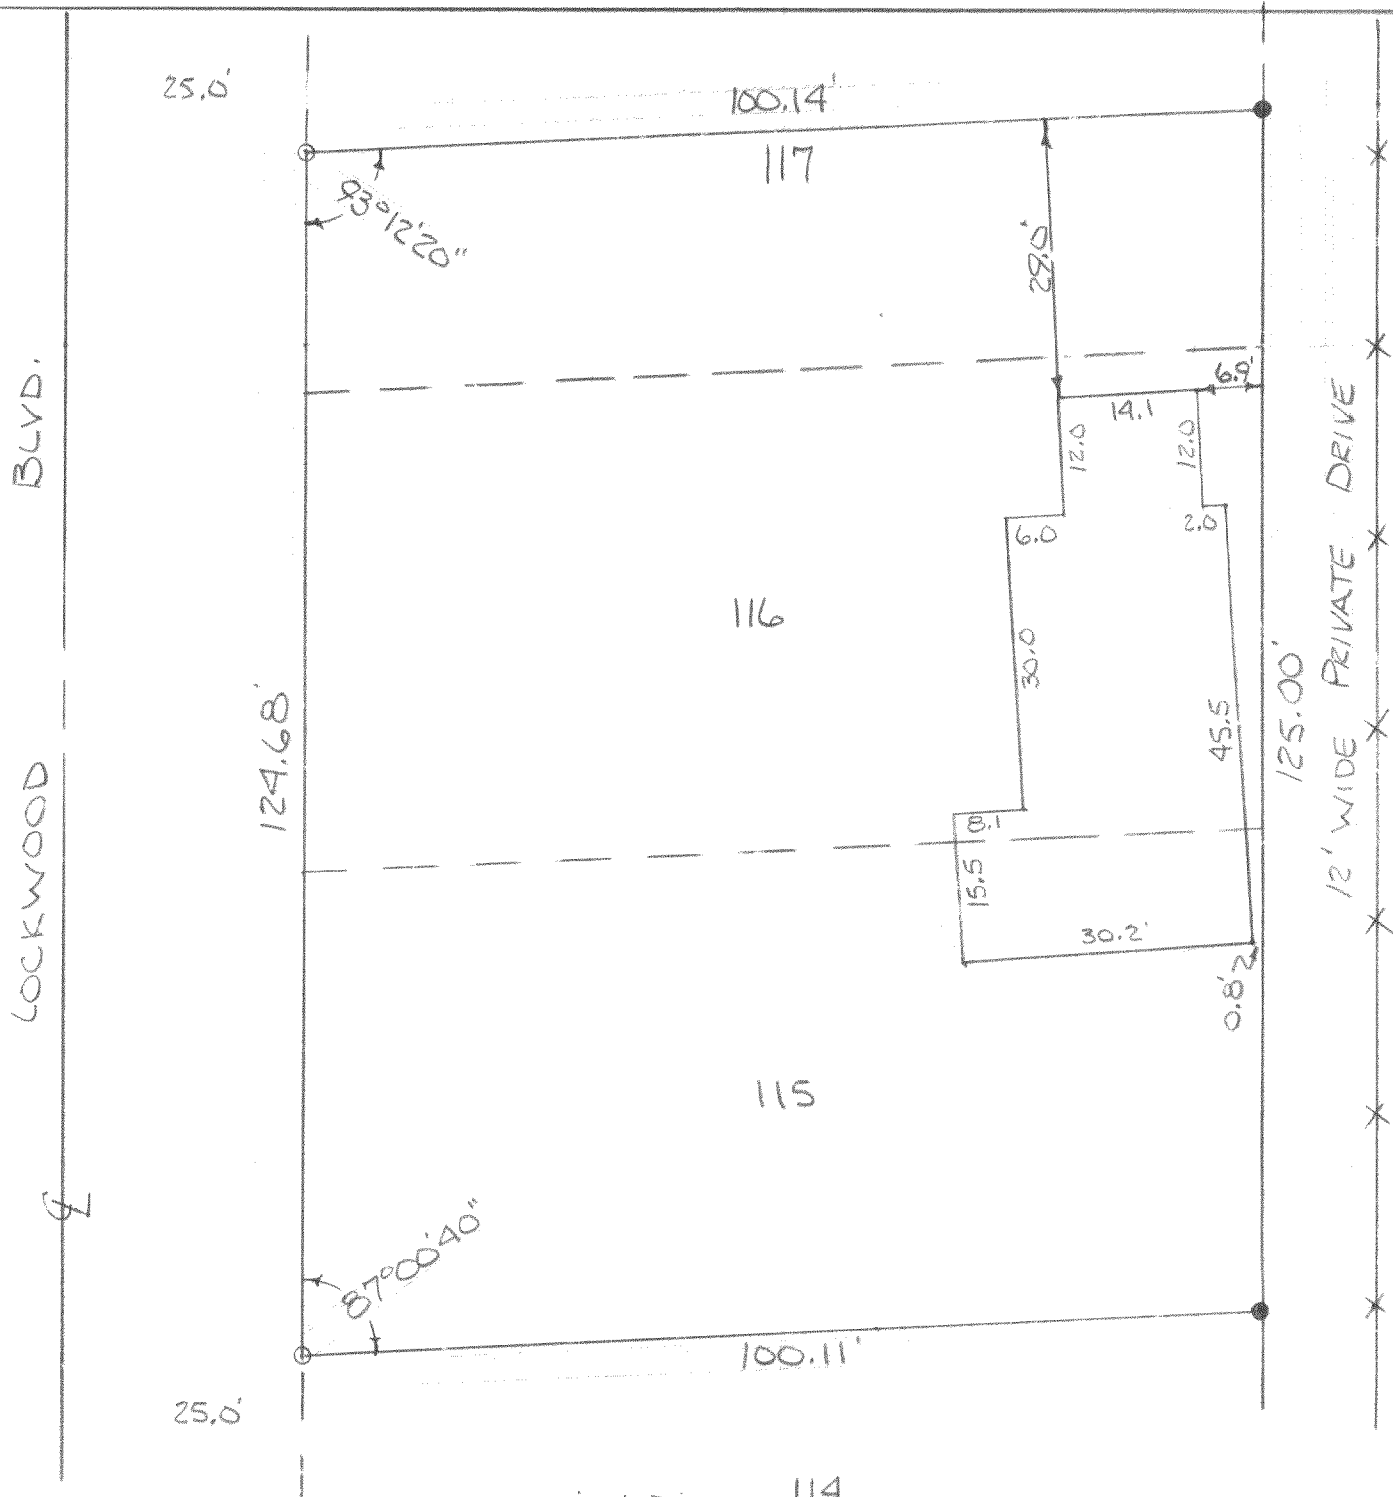

○ - INDICATES IRON PIPE 114
 ● - INDICATES $\frac{3}{4}$ " IRON ROD

DESCRIPTION:

All of Lots 115 & 116 and the South $\frac{1}{2}$ of Lot 117 all in Lake Geneva Golf Hills Add.a subdivision located in Section 31, T2N, R18E, Walworth County, Wisconsin.

CERTIFICATE:

I, Joseph M. Biagi, surveyor, do hereby certify that I have surveyed the lands hereon described.

DATE:

August 13, 1973

Joseph M. Biagi
 Elkhorn, Wisconsin

RLS #12