


PLAT OF SURVEY  
OF

LOT 4, BLOCK 3, OF THE FIRST ADDITION TO KNOLL BROOK, A SUBDIVISION LOCATED IN SECTION 10, T. 2 N., R. 18 E. OF THE 4TH P.M., TOWNSHIP OF LYONS, COUNTY OF WALWORTH, STATE OF WISCONSIN.

FOR: HOFER SCALE 1" = 30'  $\phi$  = 2" IRON PIPE FOUND  $\sigma$  = 1" IRON PIPE FOUND  $\bullet$  = 1-1/4" SOLID IRON FOUND.

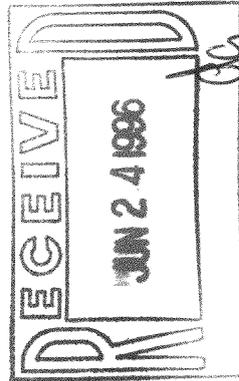

I have surveyed the above-described property, and the map hereon is a true representation thereof and shows the size and location of the property, its exterior boundaries, the location and dimensions of all visible structures thereon, fences, apparent easements and roadway and visible encroachments, if any.

This survey is made for the exclusive use of the present owners of the property, and also those who purchase, mortgage, or guarantee the title thereto, within one year from date hereof.

Dated at Burlington, this 1ST day, of MAY 1996  
John F. Degan  
John F. Degan, Land Surveyor S 242  
589 N. Pine St. Burlington, WI 53105

19-9  
# 1-A-1 # 4  
NK01-16  
218-892