
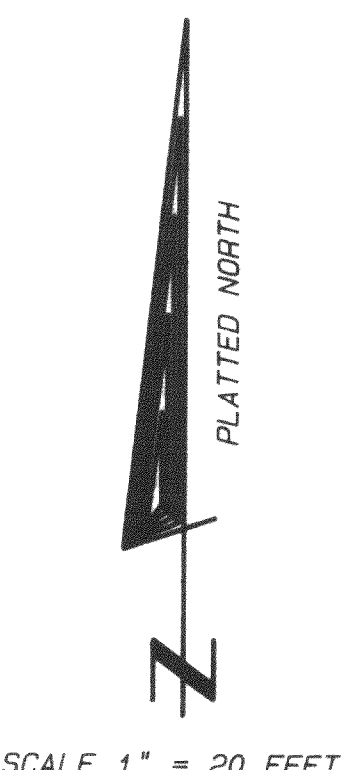


PLAT OF SURVEY

LOT 7 OF THE SECOND ADDITION TO HEATHER RIDGE, A SUBDIVISION LOCATED IN THE SOUTHWEST 1/4 OF SECTION 18, TOWN 2 NORTH, RANGE 18 EAST, WALWORTH COUNTY, WISCONSIN.

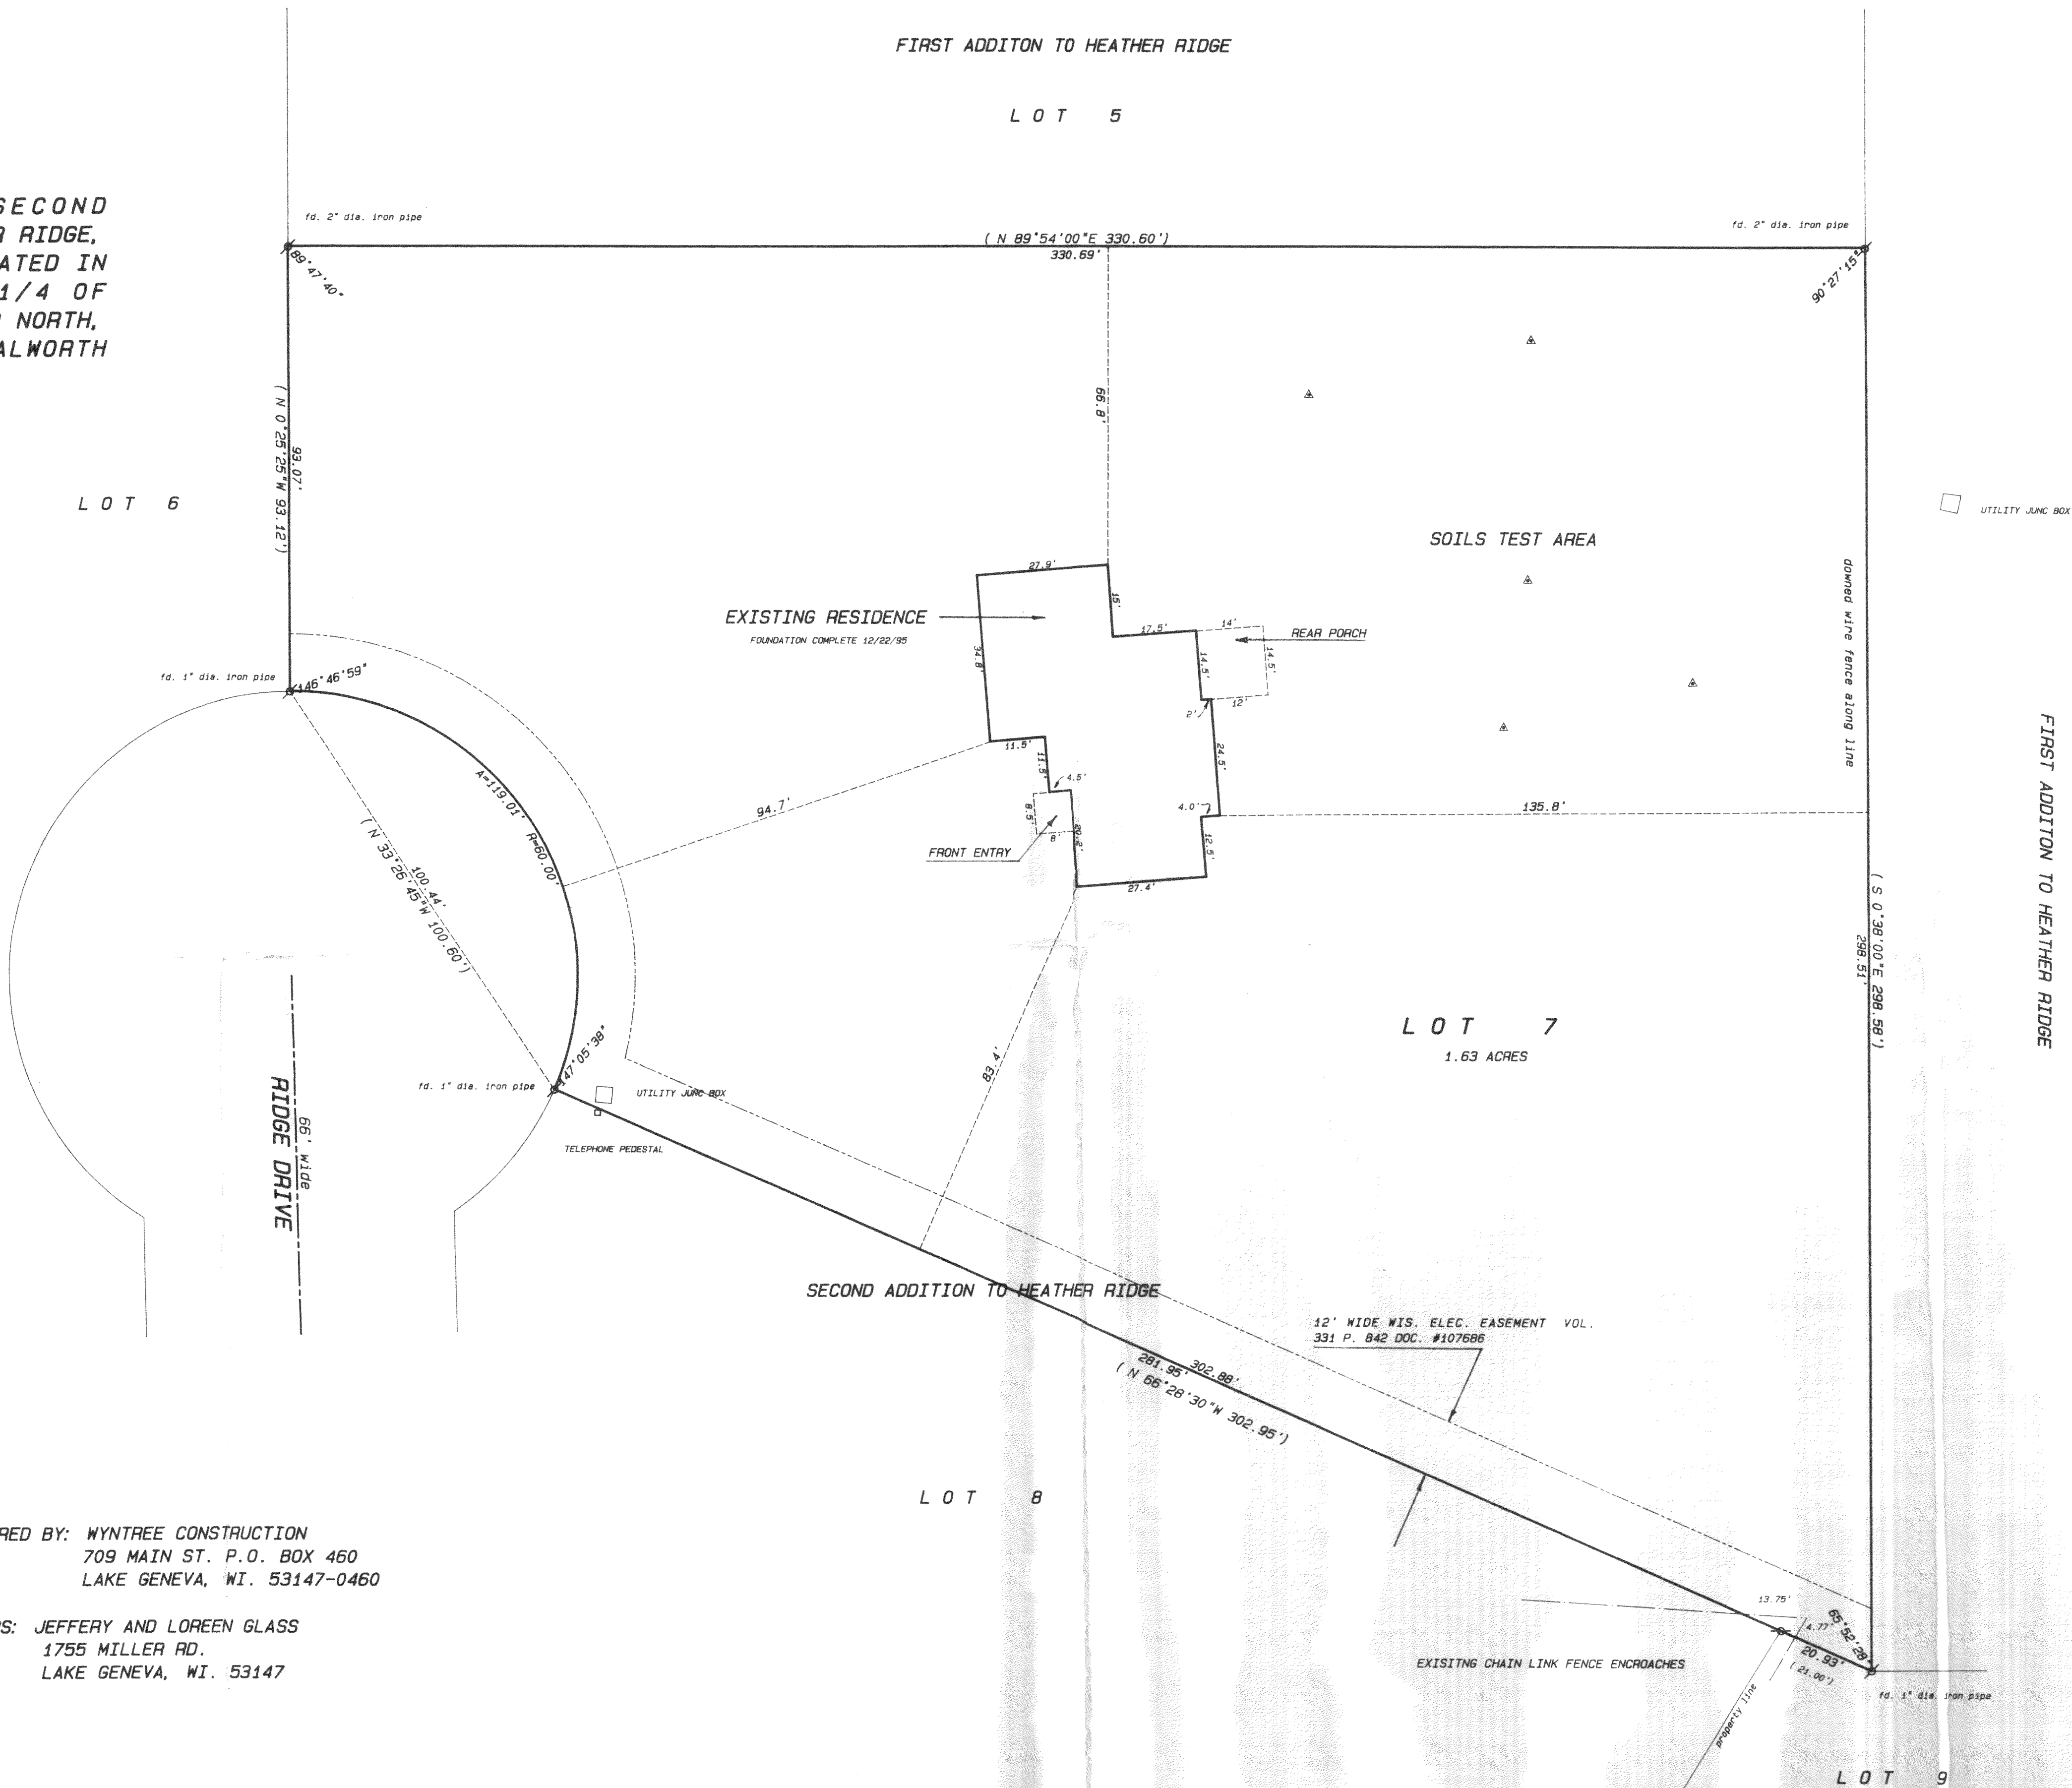


SCALE 1" = 20 FEET


LOT 4

ORDERED BY: WYNTREE CONSTRUCTION
709 MAIN ST. P.O. BOX 460
LAKE GENEVA, WI. 53147-0460

OWNERS: JEFFERY AND LOREEN GLASS
1755 MILLER RD.
LAKE GENEVA, WI. 53147

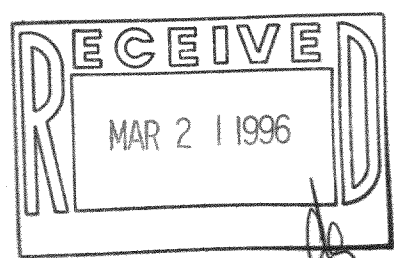

- Legend
- FOUND IRON PIPE
 - FOUND IRON ROD
 - FOUND BRASS CAPPED MONUMENT
 - FOUND CONCRETE MONUMENT
 - CHISEL CUT IN CONCRETE
 - SET IRON ROD, 34" LONG, WEIGHING 1.5 LBS./LINEAL FT., 3/8" DIA.
 - SET IRON ROD, 30" LONG, WEIGHING 4.5 LBS./LINEAL FT., 1-11/16" DIA.
 - RECORDED AS DIMENSION
 - EXISTING FENCE

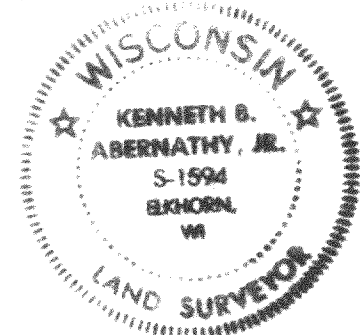

I hereby certify that the above described property has been surveyed by me or under my direction and that the above map is a true representation thereof and shows the size and location of the property, its exterior boundaries, the location of all visible structures and dimensions of all principal buildings thereon, boundary fences, apparent easements, roadways and visible encroachments, if any. This survey is made for the use of the present owners of the property, and also those who purchase, mortgage, or guarantee the title thereto within one year from date hereof.

Kenneth B. Abernathy, Jr.
KENNETH B. ABERNATHY, JR.
WISCONSIN REGISTERED LAND SURVEYOR,
S-1594

Date: Dec. 22, 1995 Job No. 95.1002

AS BUILT REVISION DATED 12/22/95

NDE2-7
218-895