

ABERNATHY and ASSOCIATES


Kenneth B. Abernathy Jr.

Wisconsin Registered Land Surveyor S-1594

Rt. 3, Box 273  
Elkhorn, Wisconsin 53121  
Phone: (414) 723-4260 (office)  
(414) 723-7209 (FAX)

PLAT OF SURVEY


LOT 3 OF CERTIFIED SURVEY MAP NO. 2161 AS RECORDED IN VOL. 10 AS PAGES 218 AND 219 AS DOCUMENT NO. 236035, LOCATED IN PART OF THE NORTHWEST 1/4 OF THE NORTHEAST 1/4 AND PART OF THE SOUTHWEST 1/4 OF THE NORTHEAST 1/4 OF SECTION 34, TOWN 2 NORTH, RANGE 18 EAST, TOWN OF LYONS, WALWORTH COUNTY, WISCONSIN.

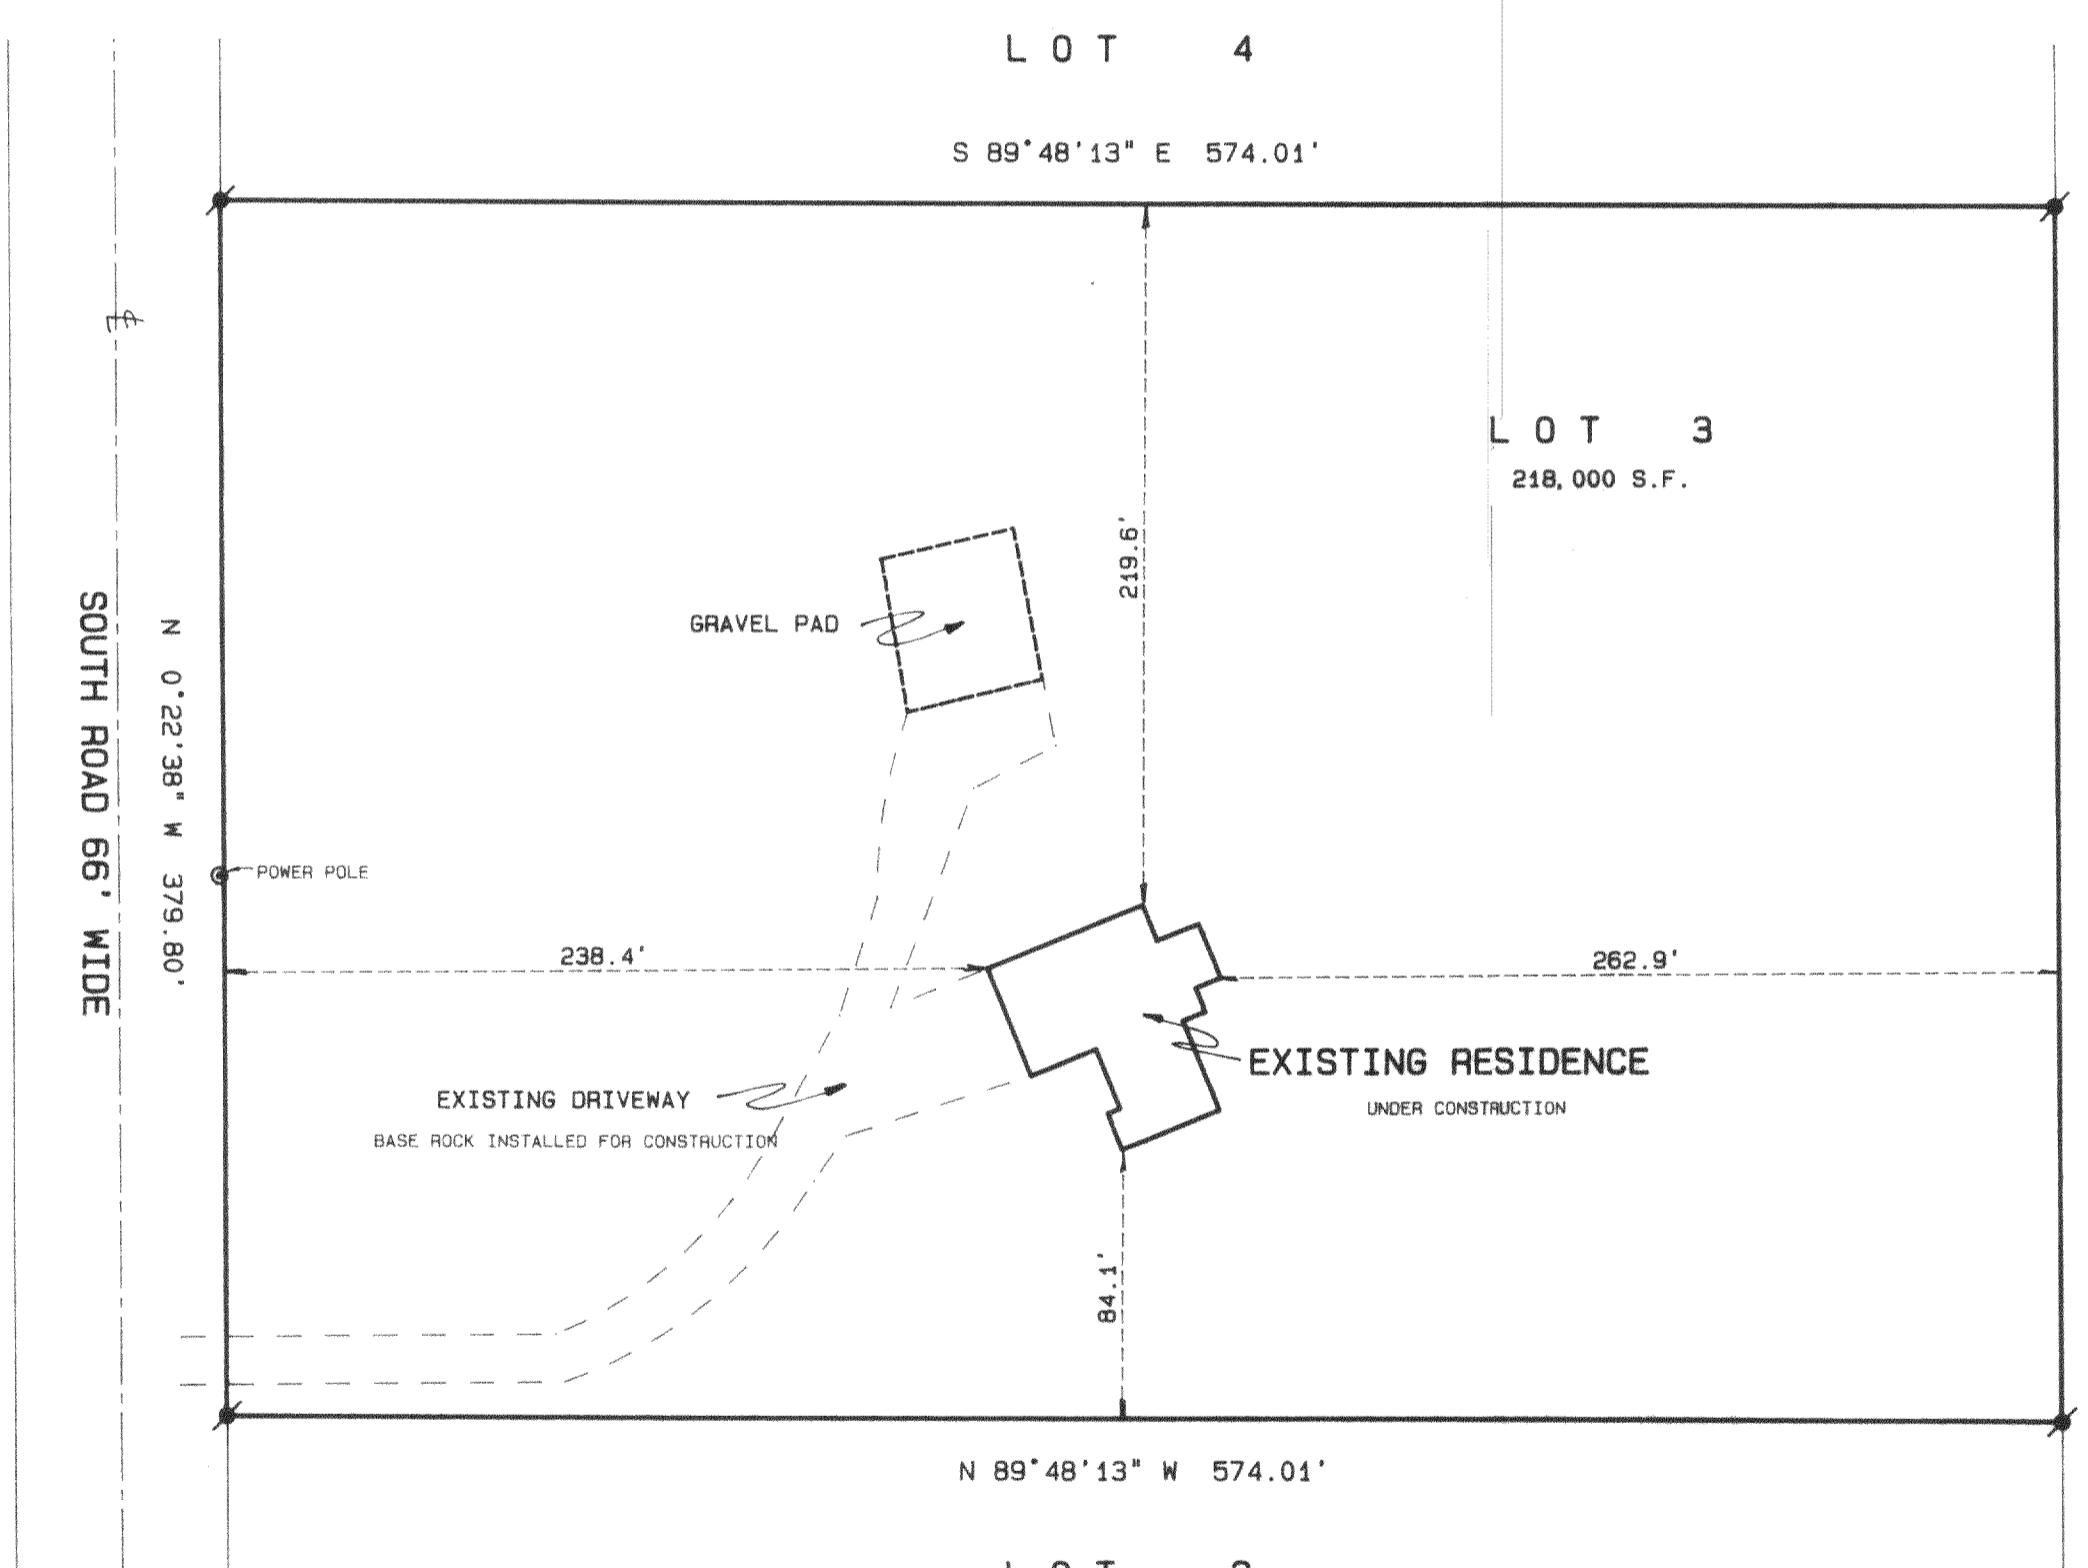

ORDERED BY: WES ERSKINE  
27 S. BROAD ST.  
ELKHORN, WI. 53121


SCALE 1" = 60 FEET  
BEARINGS ARE BASED ON  
C.S.M. # 2161

"I hereby certify that the above described property has been surveyed by me or under my direction and that the above map is a true representation thereof and shows the size and location of the property, its exterior boundaries, the location and all other structures and dimensions of all principal buildings thereon, boundary fences, apparent easements, roadways and visible encroachments, if any."  
"This survey is made for the use of the present owner of the property, and also those who purchase, mortgage, or guarantee the title thereto within one year from date hereof."

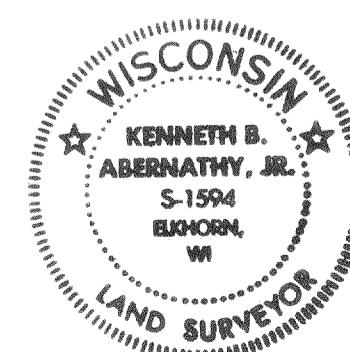

KENNETH B. ABERNATHY, JR.  
WISCONSIN REGISTERED LAND SURVEYOR,  
S-1594

Date: Oct. 24, 1997 Job No. 971014

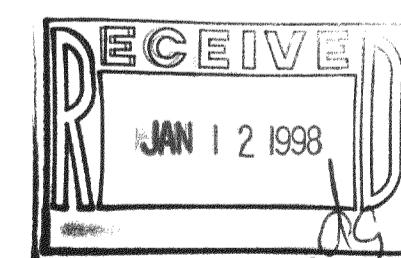

SCALE: 1" = 60 FEET