

in accordance with Comm 85, Wis. Adm. Code

Attach complete site plan on paper not less than 8 1/2 x 11 inches in size. Plan must include, but not limited to: vertical and horizontal reference point (BM), direction and percent slope, scale or dimensions, north arrow, and location and distance to nearest road.

Please print all information.

Personal information you provide may be used for secondary purposes (Privacy Law, s. 15.04 (1) (m)).

County	WALWORTH
Parcel I.D.	JTR 00004
Reviewed by	Date
BDO	12/6/02

Property Owner	SAL DIMICELI			Property Location	Govt. Lot SW 1/4 SE 1/4 S 13 T 2 N R 17 E (part)		
Property Owner's Mailing Address	Lot #	Block #	Subd. Name or CSM#	City	Village	Town	Nearest Road
101 BROAD ST UNIT 105	4		TRINITY MOUNTAIN ESTATES	GENEVA		<input checked="" type="checkbox"/>	Summit Dr KROEGER Rd.
City State Zip Code Phone Number							
LAKE GENEVA WI 53147 (262) 249-7003							

New Construction Use: Residential / Number of bedrooms 5 Code derived design flow rate 750 GPD

Replacement Public or commercial - Describe: _____

Parent material: GLACIAL OUTWASH Flood Plain elevation if applicable NA ft.

General comments: AREA FOR SYSTEMS 170 FT X 54 FT. MAY USE SIDEWINDER HIGH CAPACITY

and recommendations: INFILTRATORS

RIC DORGAY OF WALWORTH COUNTY-ONSITE

Boring # 5006 Boring PR Ground surface elev. 1008.2 ft. Depth to limiting factor >127 in.

Horizon	Depth in.	Dominant Color Munsell	Redox Description Qu. Sz. Cont. Color	Texture	Structure Gr. Sz. Sh.	Consistence	Boundary	Roots	Soil Application Rate GPD/ft ²	
									*EFF#1	*EFF#2
1	0-7	10YR 3/3	-	Sil	2f sbk	mvfr	CS	3f	0.5	0.8
2	7-14	10YR 5/4	-	Sil	2f sbk	mfr	GS	2f	0.5	0.8
3	14-44	7.5YR 4/4	-	CL	2nabk	mfr	GW	1f	0.4	0.6
4	44-111	7.5YR 5/4	-	cbgs	0-Sq	ML	GW	-	0.7	1.2
5	111-127	7.5YR 5/4	-	grs	0-Sq	ML	-	-	0.7	1.2

Boring # 5007 Boring PR Ground surface elev. 1004.8 ft. Depth to limiting factor 787 in.

Horizon	Depth in.	Dominant Color Munsell	Redox Description Qu. Sz. Cont. Color	Texture	Structure Gr. Sz. Sh.	Consistence	Boundary	Roots	Soil Application Rate GPD/ft ²	
									*EFF#1	*EFF#2
1	0-7	10YR 3/3	-	Sil	2f sbk	mvfr	CS	3f	0.5	0.8
2	7-33	7.5YR 4/4	-	CL	2nabk	mfr	GW	2f	0.4	0.6
3	33-87	7.5YR 5/4	-	grs	0-Sq	ML	GW	1f	0.7	1.2

* Effluent #1 = BOD₅ > 30 ≤ 220 mg/L and TSS > 30 ≤ 150 mg/L

* Effluent #2 = BOD₅ < 30 mg/L and TSS < 30 mg/L

CST Name (Please Print)	Signature	CST Number
BRIAN L. GATES	Brian L. Gates	1339
Address	Date Evaluation Conducted	Telephone Number
P.O. Box 822 WILLIAMS BAY WI 53191-0822	JAN 24 th 2002	262-245-6150

Property Owner SAL DIMICELI

Parcel ID # _____

Page 2 of 3

Boring # 5008 Boring
 Pit Ground surface elev. 1009.7 ft. Depth to limiting factor >143 in.

Horizon	Depth in.	Dominant Color Munsell	Redox Description Qu. Sz. Cont. Color	Texture	Structure Gr. Sz. Sh.	Consistence	Boundary	Roots	Soil Application Rate	
									GPD/ft ²	
									*EFF#1	*EFF#2
1	0-9	10YR 3/3	-	Sil	2f sbk	mvft	CS	3f	0.5	0.8
2	9-17	10YR 5/4	-	Sil	2f sbk	mfr	GS	2f	0.5	0.8
3	17-48	7.5YR 4/4	-	CL	2m abk	mfr	GW	1f	0.4	0.6
4	48-80	7.5YR 4/6	-	Ch Gr S	0-Sq	ML	GW	-	0.7	1.2
5	80-143	7.5YR 4/6	-	Gr S	0-Sq	ML	-	-	0.7	1.2

Boring # _____ Boring
 Pit Ground surface elev. _____ ft. Depth to limiting factor _____ in.

Horizon	Depth in.	Dominant Color Munsell	Redox Description Qu. Sz. Cont. Color	Texture	Structure Gr. Sz. Sh.	Consistence	Boundary	Roots	Soil Application Rate	
									GPD/ft ²	
									*EFF#1	*EFF#2

Boring # _____ Boring
 Pit Ground surface elev. _____ ft. Depth to limiting factor _____ in.

Horizon	Depth in.	Dominant Color Munsell	Redox Description Qu. Sz. Cont. Color	Texture	Structure Gr. Sz. Sh.	Consistence	Boundary	Roots	Soil Application Rate	
									GPD/ft ²	
									*EFF#1	*EFF#2

* Effluent #1 = BOD₅ > 30 ≤ 220 mg/L and TSS > 30 ≤ 150 mg/L

* Effluent #2 = BOD₅ ≤ 30 mg/L and TSS ≤ 30 mg/L

The Department of Commerce is an equal opportunity service provider and employer. If you need assistance to access services or need material in an alternate format, please contact the department at 608-266-3151 or TTY 608-264-8777.

100 0 100
SCALE IN FEET


OWNER: SAL DIMICELY
SOIL TESTER: Brian L. Gates
CST #1339
JAN 24th 2002

RIC DORGAY OF WALWORTH COUNTY
ONSITE

PLAT OF

LOT 4 OF TRINITY MOUNTAIN ESTATES A PROPOSED
SUBDIVISION LOCATED IN THE SOUTHEAST 1/4 OF
SECTION 13, AND THE NORTHEAST 1/4 OF SECTION
24 TOWN 2 NORTH, RANGE 17 EAST, TOWN OF
GENEVA, WALWORTH COUNTY, WISCONSIN.

J.K. SURVEYING INC.
N3705 WILLOWBEND LANE
LAKE GENEVA, WI, 53147
262-248-3697

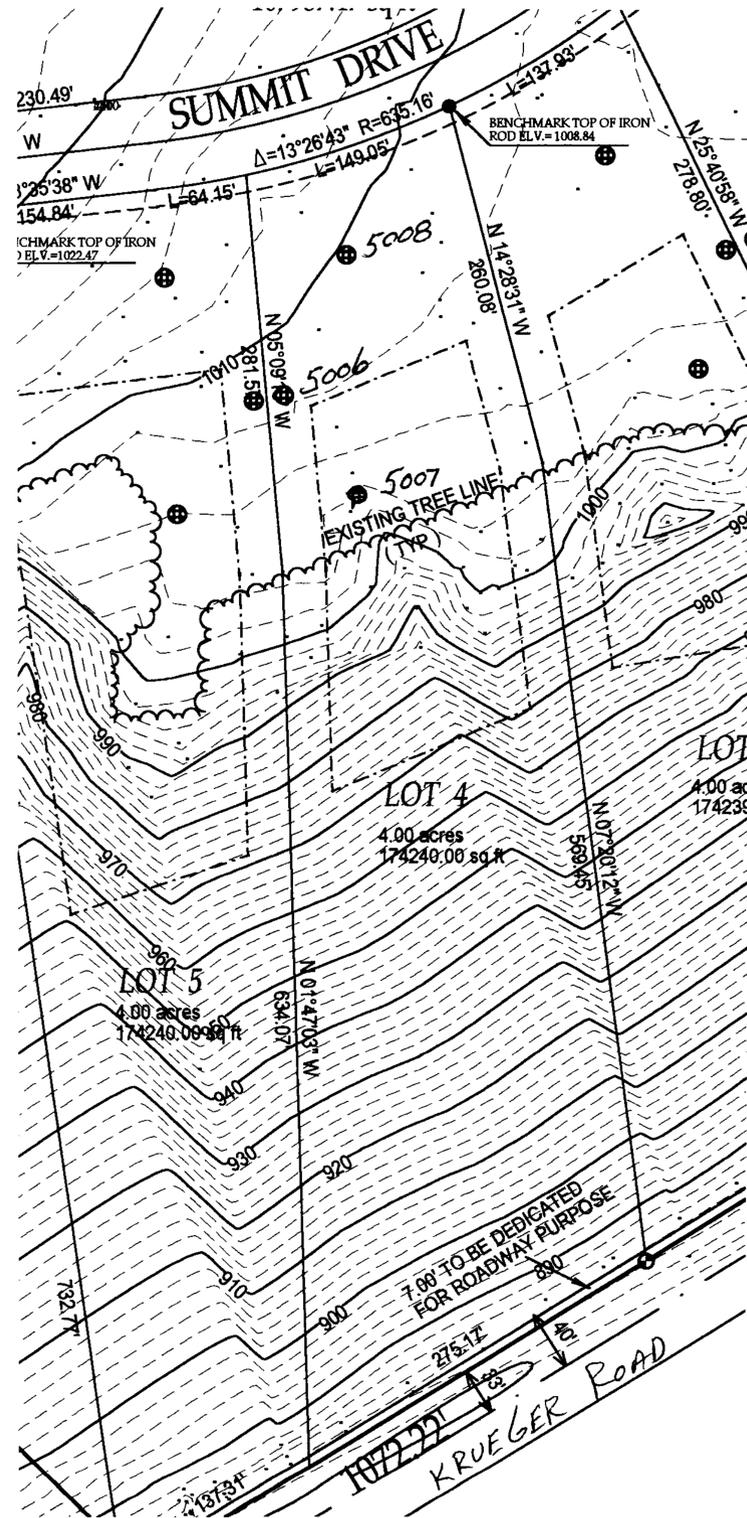

LEDGEND

- () = recorded as
- = found iron bar
- = found iron pipe
- = set iron pipe
- = set iron bar
- ⊕ = soil boring

JOB # 01-1000-4

COMPARE LEGAL DESCRIPTION ABOVE AND DRAWING WITH DEED. FOR BUILDING RESTRICTIONS AND EASEMENTS NOT SHOWN, REFER TO DEED, ABSTRACT SOURCES AND LOCAL MUNICIPAL CODES. NOTIFY THE SURVEYOR IMMEDIATELY OF ANY DISCREPANCY.

"I hereby certify that I have surveyed the above described property and that the above map is a true representation thereof and shows the size and location of all visible structures, apparent easements and encroachments if any."

This survey is made for the present owners of the property, and those who purchase, mortgage, or guarantee the title thereto, within one year from the date hereof.

DATED THIS THE 31st OF JANUARY 2002.



John P. Krott

JOHN KROTT S - 2258
Wisconsin Registered Land Surveyor

(original signed in red)

FEB - 5 2002

WALWORTH COUNTY





INSPECTION REPORT

	1/24/02	Trinity Mtn	Geneva
	Brian Gates	Krueger Rd	
	Licensed Individual Name and Address		License Type and Number
	Soils		
Land Management Department	Type of Inspection: (Soil and Site Evaluation, System Installation, Complaint Investigation)		
	Domiceli		
	Owners Name and Address		
	Lot 4		

Planning
Zoning
Sanitation


5006

0-7 10yr 3/3 — sil 2fsbk mvr CS
 7-14 10yr 5/4 — sil 2fsbk mvr JS
 14-44 7.5yr 4/4 — cl 2nabk mtr gw
 44-111 7.5yr 5/4 — ^{cos} gcs 05g ml gw
 111-127 7.5yr 5/4 — gcs 05g ml

5007

0-7 10yr 3/3 — sil 2fsbk mvr CS
 7-33 7.5yr 4/4 — cl 2nabk mtr gw
 33-87 7.5yr 5/4 — gcs 05g ml —

5008 similar to 5006
 48" - 143" gcs

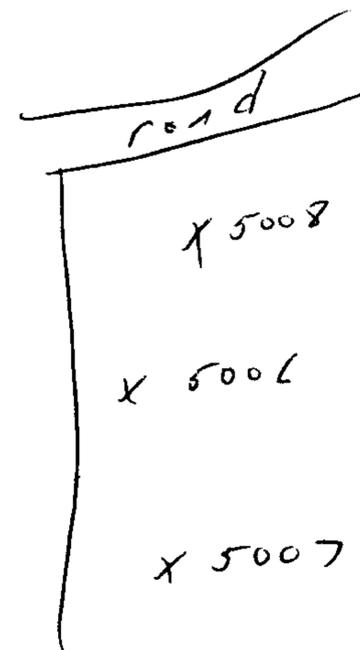

W3929 County Road NN
 Elkhorn, WI 53121
 262.741.3394 tel
 262.741.3266 fax

Copies:
 White-County
 Yellow-Agent
 Pink-Owner


 Signature of County Sanitarian

