

LAND-MARK SURVEYING

Mark L. Miritz

Wisconsin Registered Land Surveyor S-2582

N9330 Knuteson Drive
Whitewater, WI 53190
Phone: (262) 495-3284
FAX : (262) 495-8421
LAND-MARKSURVEYING.COM


PLAT OF SURVEY

**LOT 1, BLOCK 3 OF CHAPEL HILLS SUBDIVISION,
LOCATED IN SECTION 3, TOWN 3 NORTH, RANGE 15
EAST, RICHMOND TOWNSHIP, WALWORTH COUNTY,
WISCONSIN.**

**OWNERS: JAMES T. & GAYLE R. BROUSSEAU
37 N. DEERPATH ROAD
BARRINGTON, IL 60010**


**SHORELAND SETBACK
BY AVERAGING**

$$\begin{array}{r} \text{LOT 2} \quad + \quad 51.3' \\ \text{LOT 7} \quad + \quad 34.6' \\ \hline 85.90' \div 2 \\ \hline = \quad 42.95' \end{array}$$

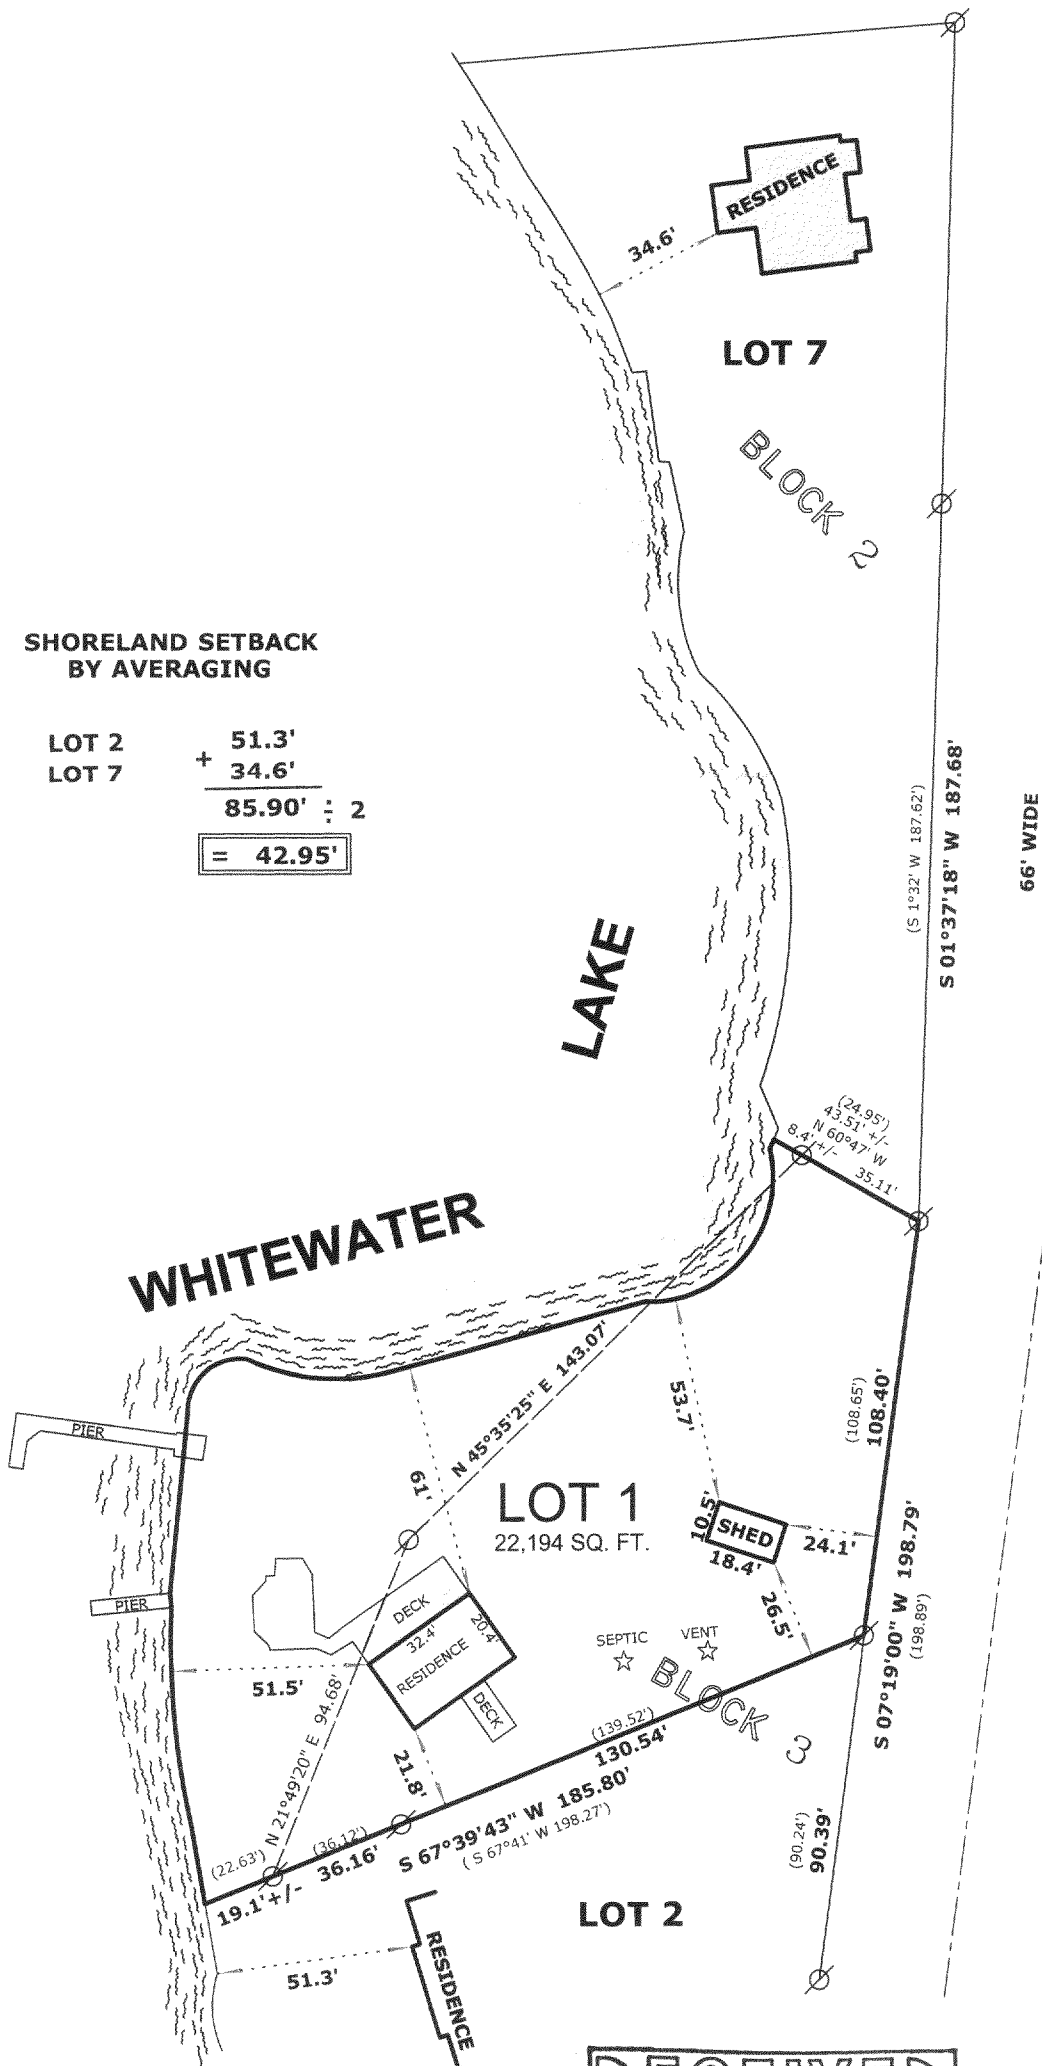

NOTES:

1. THE WELL FOR LOT 1 IS LOCATED INSIDE THE EXISTING RESIDENCE.
2. MATHEMATICAL CLOSURE OF RECORDED LOT 1, BLOCK 3, DOES NOT MEET MINIMUM STANDARDS. THE FOUND IRON PIPE WERE USED TO ESTABLISH THE BOUNDARY.

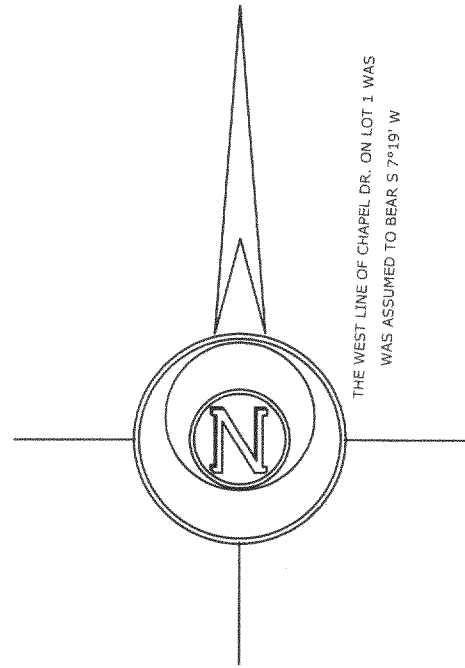

LEGEND


- FOUND IRON PIPE
- FOUND IRON ROD
- FOUND COUNTY MONUMENT
- FOUND CONCRETE MONUMENT
- CHISEL CUT IN CONCRETE
- SET IRON ROD, 24" LONG, WEIGHING 1.5 LBS./LINEAL FT., 3/4" DIA.
- RECORDED AS DIMENSION
- EXISTING FENCE

SCALE: 1" = 50 FEET

"I hereby certify that the above described property has been surveyed by me or under my direction and that the above map is a true representation thereof and shows the size and location of the property, its exterior boundaries, the location of all visible structures and dimensions of all principal buildings thereon, boundary fences, apparent easements, roadways and visible encroachments, if any."
"This survey is made for the use of the present owners of the property, and also those who purchase, mortgage, or guarantee the title thereto within one year from date hereof."

Mark L. Miritz
MARK L. MIRITZ
WISCONSIN REGISTERED
LAND SURVEYOR S-2582

DATE: AUGUST 22, 2004 JOB NO. 04.803

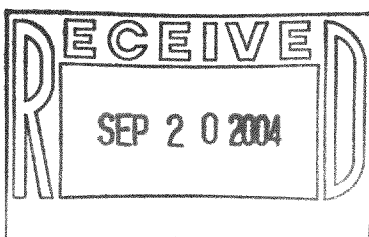

CCH 000066

315-875