


SURVEY DATE: 02/07/07
SURVEY MADE FOR:
WATERVIEW LODGE, LLC
160 W HONEYSUCKLE RD
LAKE FOREST IL 60045

THIS SURVEY IS MADE FOR THE USE OF THE
PRESENT OWNERS OF THE PROPERTY, AND
ALSO THOSE WHO PURCHASE, MORTGAGE OR
GUARANTEE TITLE TO WITHIN ONE (1) YEAR
FROM DATE HERETO.

RSV
ENGINEERING, INC.
146 E. MILWAUKEE ST.
JEFFERSON, WI 53549 (920) 674-3411


I, RANDAL K. WELTZIN R.L.S. *1848, HEREBY CERTIFY THAT
THIS SURVEY WAS MADE IN ACCORDANCE WITH
THE MINIMUM STANDARDS FOR PROPERTY SURVEYS
(CHAPTER A-E 7) FOR THE STATE OF WISCONSIN AND
HAS BEEN PREPARED UNDER MY DIRECTION AND
CONTROL AND IS CORRECT TO THE BEST OF MY
KNOWLEDGE AND BELIEF.

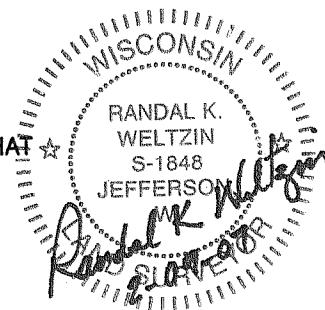

RECERTIFICATION OF BUILDING LOCATION

DESCRIPTION:

LOT 4, CLIFF'S VIEW SUBDIVISION, LYING IN PART OF THE NORTHEAST 1/4 OF THE NORTHWEST 1/4 OF SECTION 3, TOWNSHIP 3 NORTH, RANGE 15 EAST, TOWN OF WHITEWATER, WALWORTH COUNTY, WISCONSIN.

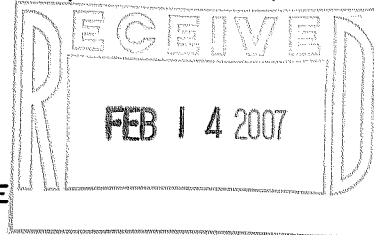

AREA:

4.15 ACRES TO MEANDER LINE
4.37 ACRES TO SHORELINE

NOTE:

CONTOURS DRAWN FROM PLAT OF SURVEY MADE
BY, PETER S. GORDON, S-2101, FARRIS, HANSEN
AND ASSOCIATES, 7 RIDGEWAY COURT, ELKHORN,
WISCONSIN. DATED OCTOBER 7, 2005. MEAN SEA
LEVEL CONVERSION FACTOR, +854.4'.

LEGEND

(33.00')	RECORDED DISTANCE
33.00'	MEASURED DISTANCE
■	3/4" FOUND IRON ROD
▲	FOUND SPIKE
⊙SB	SOIL BORING LOCATION

BASIS OF BEARING:

THE WESTERLY
PROPERTY BOUNDARY
OF LOT 4 WAS
TAKEN TO BEAR
N01° 46'56"W

CLIFF'S VIEW SUBDIVISION

