


ABELL
SURVEYING & MAPPING

1140 SEQUOIA STREET • DELAVAN, WISCONSIN 53115
262-728-6737

HICKORY

ROAD

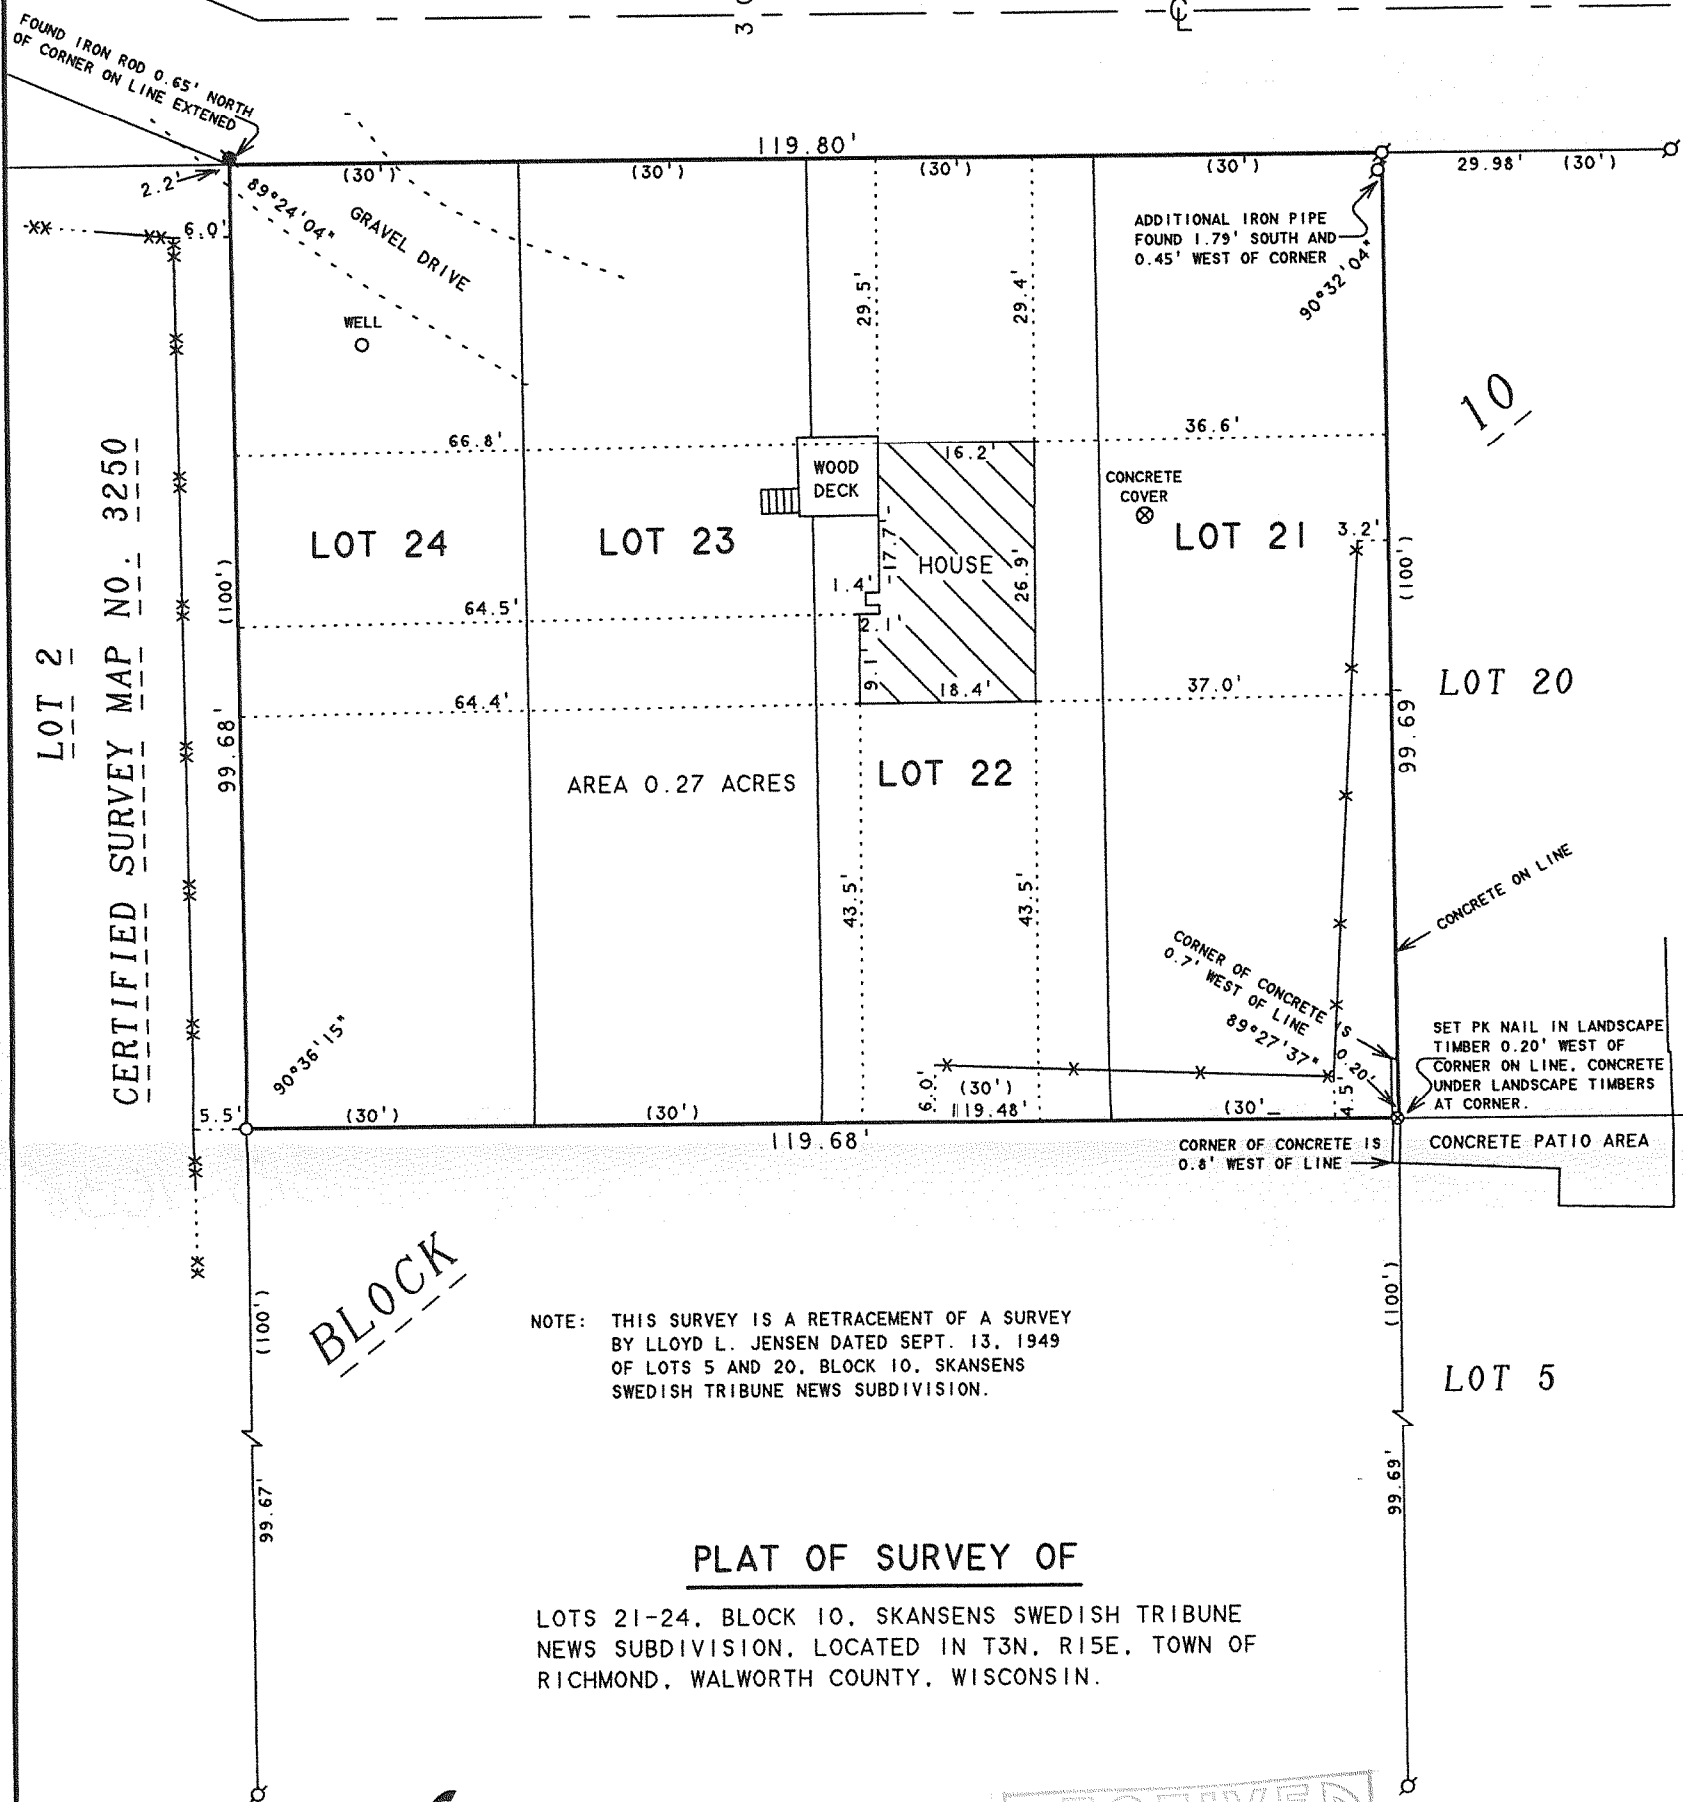

PLAT OF SURVEY OF

LOTS 21-24, BLOCK 10, SKANSENS SWEDISH TRIBUNE NEWS SUBDIVISION, LOCATED IN T3N, R15E, TOWN OF RICHMOND, WALWORTH COUNTY, WISCONSIN.


N



SCALE 1"=20'

LEGEND

- - IRON PIPE FOUND
- - IRON ROD FOUND
- - 1" DIA. IRON PIPE SET
- ⊗ - PK NAIL SET IN LANDSCAPE TIMBER
- XX - WIRE FENCE
- * - WOOD BOARD FENCE
- () - RECORDED AS

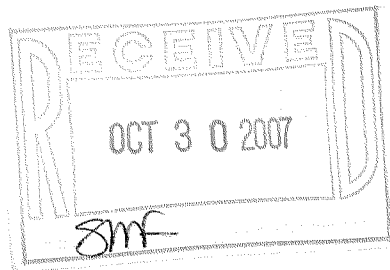

I HEREBY CERTIFY THAT I HAVE SURVEYED THE ABOVE DESCRIBED PROPERTY AND THAT THE ABOVE MAP IS A TRUE REPRESENTATION THEREOF AND SHOWS THE SIZE AND LOCATION OF THE PROPERTY, ITS EXTERIOR BOUNDARIES, THE LOCATION OF ALL VISIBLE STRUCTURES AND DIMENSIONS OF ALL PRINCIPAL BUILDINGS THEREON, BOUNDARY FENCES, APPARENT EASEMENTS, ROADWAYS AND VISIBLE ENCROACHMENTS, IF ANY, TO THE BEST OF MY KNOWLEDGE AND BELIEF.

THIS SURVEY IS MADE FOR THE USE OF THE PRESENT OWNERS OF THE PROPERTY, AND ALSO THOSE WHO PURCHASE, MORTGAGE, OR GUARANTEE THE TITLE THERETO WITHIN ONE (1) YEAR FROM DATE HEREON.

David F. Abell

DAVID F. ABELL
WISCONSIN REGISTERED LAND SURVEYOR, S-1596

ORDERED BY: JEFF LUKAS
460 LOUDON ROAD
RIVERSIDE, IL 60546

September 5, 2007

DATE: September 5, 2007 JOB NUMBER - 07064
NOTE: THIS IS NOT A CERTIFIED COPY UNLESS SEALED.

CS 173

315-1038