

PREPARED FOR
DANIEL BLAEDOW
N6534 LORRAINE RD.
DELAVAN, WI. 53115


PLAT OF SURVEY

-OF-

LOTS 15 THRU 20 IN BLOCK 5 SKANSEN SUBDIVISION
AND THAT PORTION OF LOT 14 BLOCK 5 SKANSEN
SUBDIVISION DESCRIBED AS FOLLOWS TO-WIT:
BEGINNING AT THE NORTHEAST CORNER OF SAID
LOT 14; THENCE S 87°41'14" W 90.06 FEET TO A POINT
IN THE EAST RIGHT OF WAY OF LORRAINE ROAD AND
THE WEST LINE OF SAID LOT 14; THENCE N 00°00'00" W
ALONG SAID WEST LINE OF SAID LOT 14 AND SAID
EAST LINE OF LORRAINE ROAD 4.00 FEET TO THE
NORTHWEST CORNER OF SAID LOT 14; THENCE
N 89°46'02" W 89.99 FEET TO THE PLACE OF BEGINNING.


KROTT SURVEYING INC.

N3705 WILLOW BEND LANE
LAKE GENEVA WI. 53147
PHONE # (262)248-3697
FAX # (262)249-0639

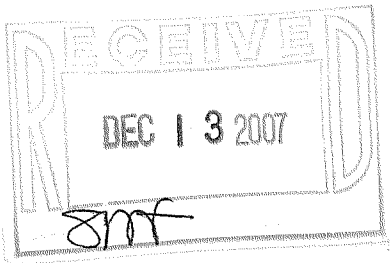

(30' WIDE)

LORRAINE ROAD

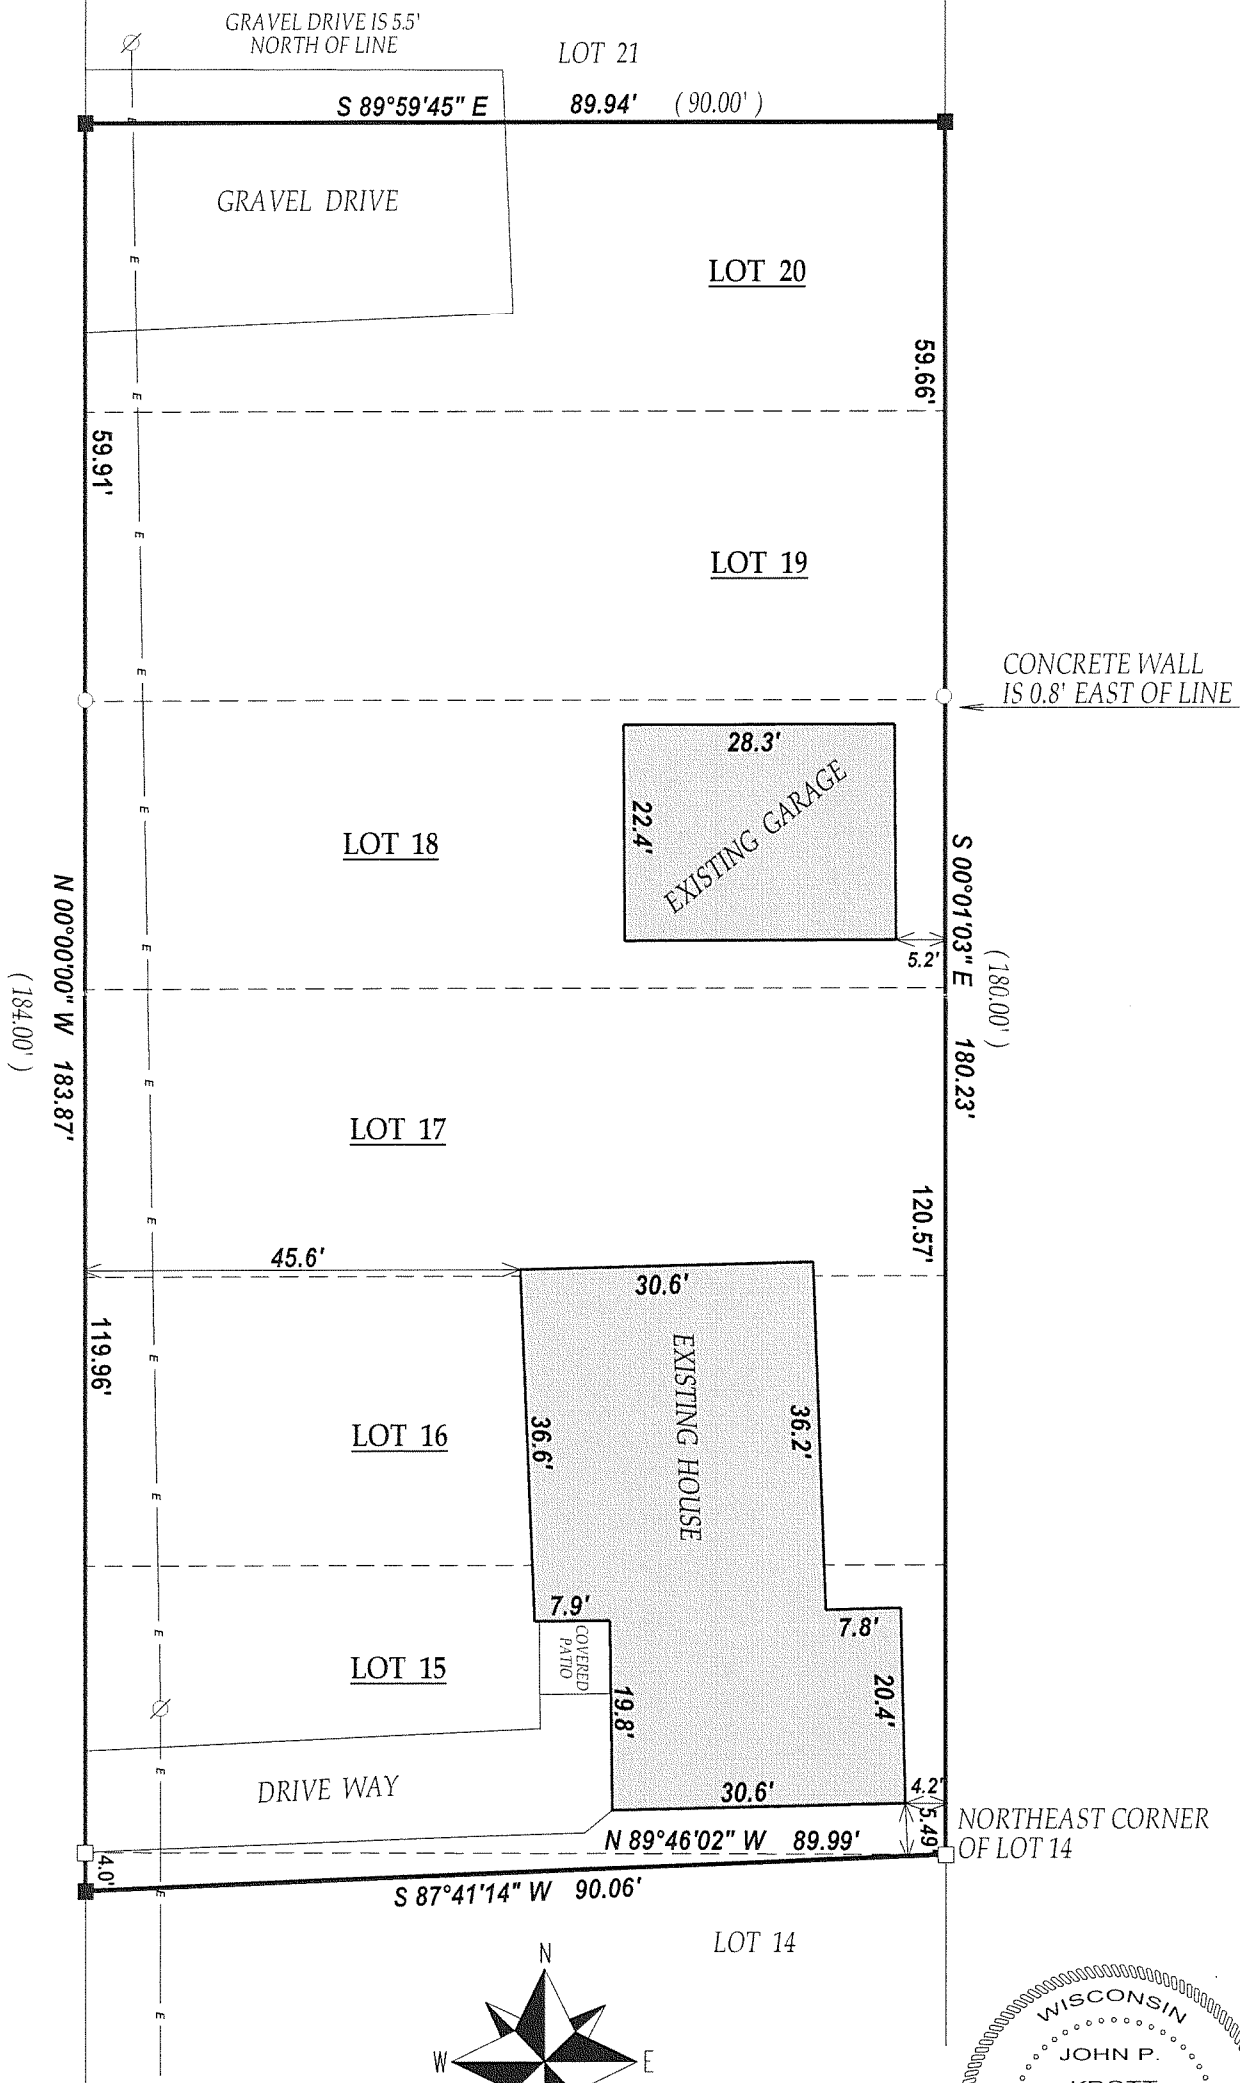

LEGEND

○ FOUND IRON PIPE

□ FOUND IRON BAR

■ SET IRON BAR

∅ POWER POLE

—E— OVERHEAD WIRES

(xx) RECORDED AS

JOB # 07-526 TAX ID # CS00080C
DATED THIS THE 10th DAY OF DECEMBER 2007.

SCALE 1" = 20'




COMPARE LEGAL DESCRIPTION ABOVE AND DRAWING WITH DEED.
FOR BUILDING RESTRICTIONS AND EASEMENTS NOT SHOWN, REFER
TO DEED, ABSTRACT SOURCES AND LOCAL MUNICIPAL CODES. NOTIFY
THE SURVEYOR IMMEDIATELY OF ANY DISCREPANCY.

"I hereby certify that I have surveyed the above described property and that
the above map is a true representation thereof and shows the size and
location of all visible structures, apparent easements and encroachments
if any."

This survey is made for the present owners of the property, and those who
purchase, mortgage, or guarantee the title thereto, within one year from
the date hereof.

NOTE : LORRAINE ROAD WAS ASSUMED TO BEAR NORTH-SOUTH

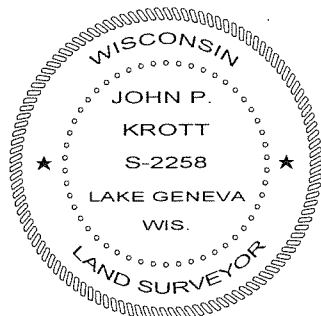

John P. Krott
JOHN KROTT S - 2258
Wisconsin Registered Land Surveyor
(original if signed in red)

CS - 80C

315- 1047