

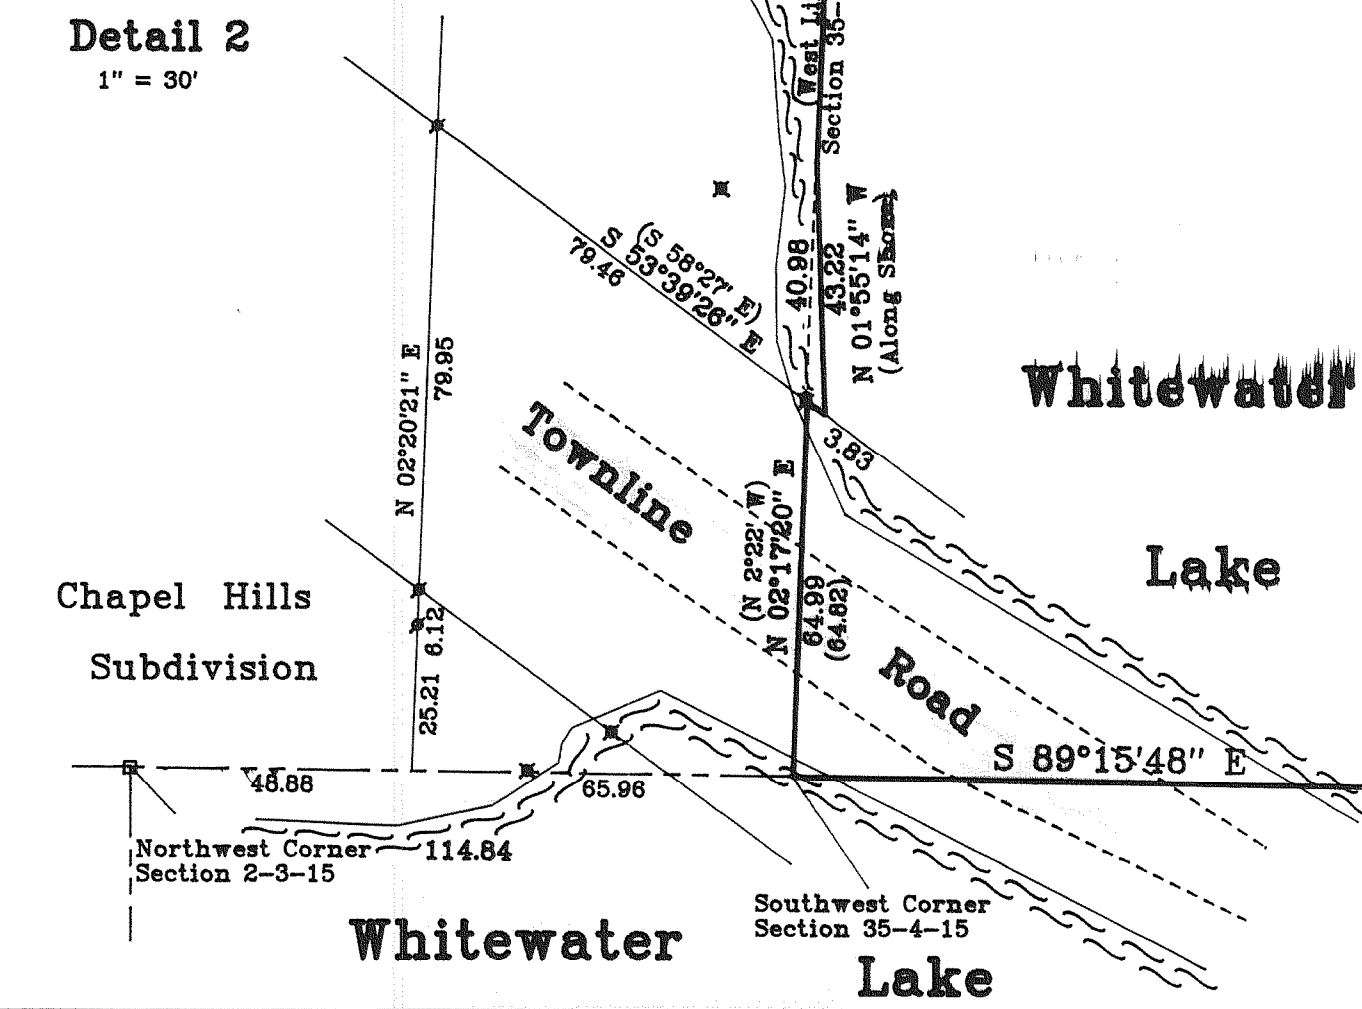
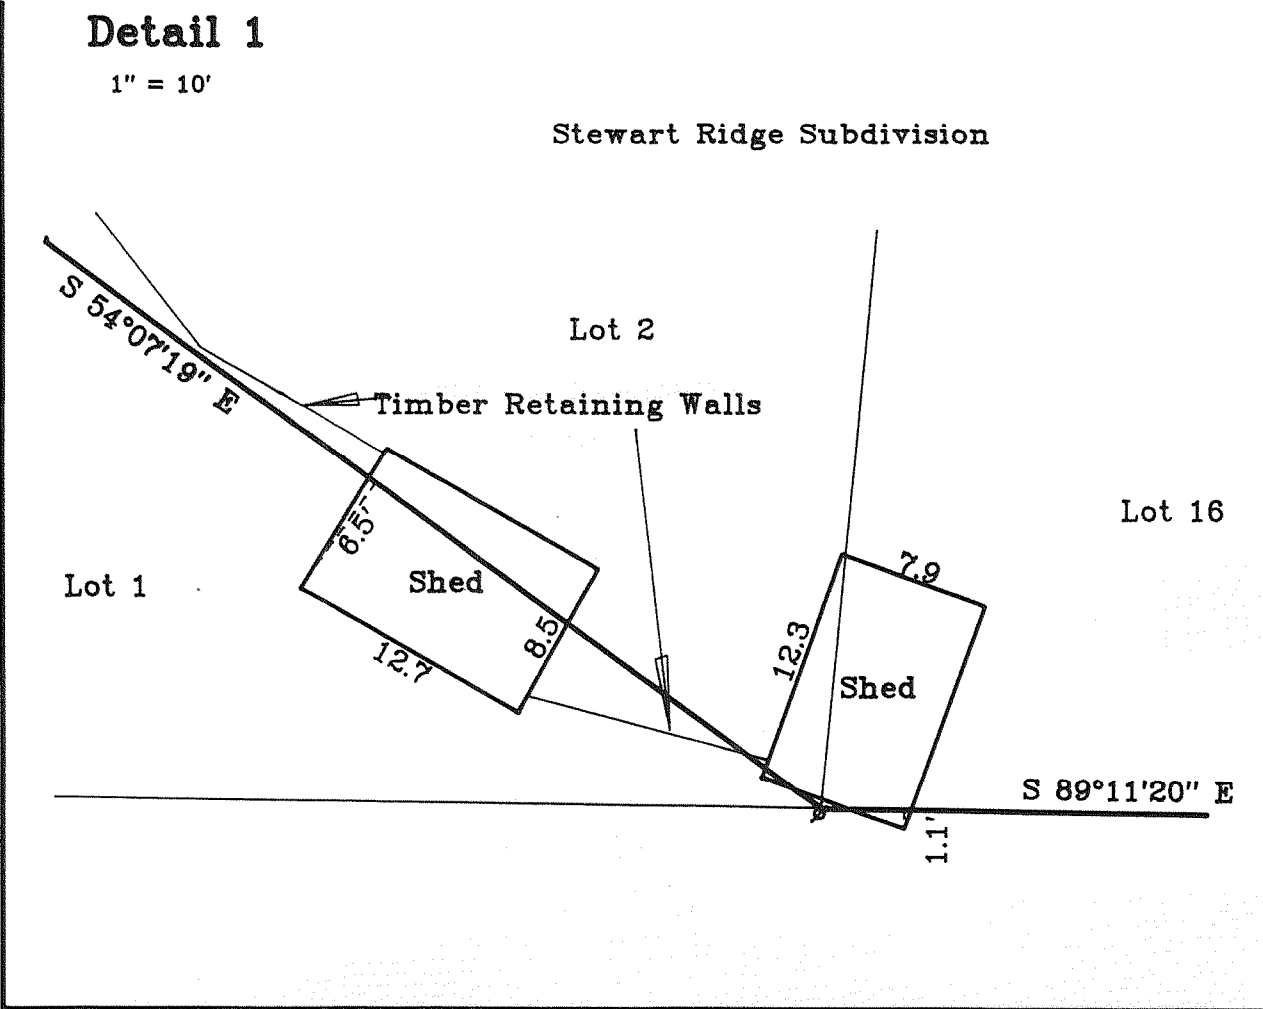


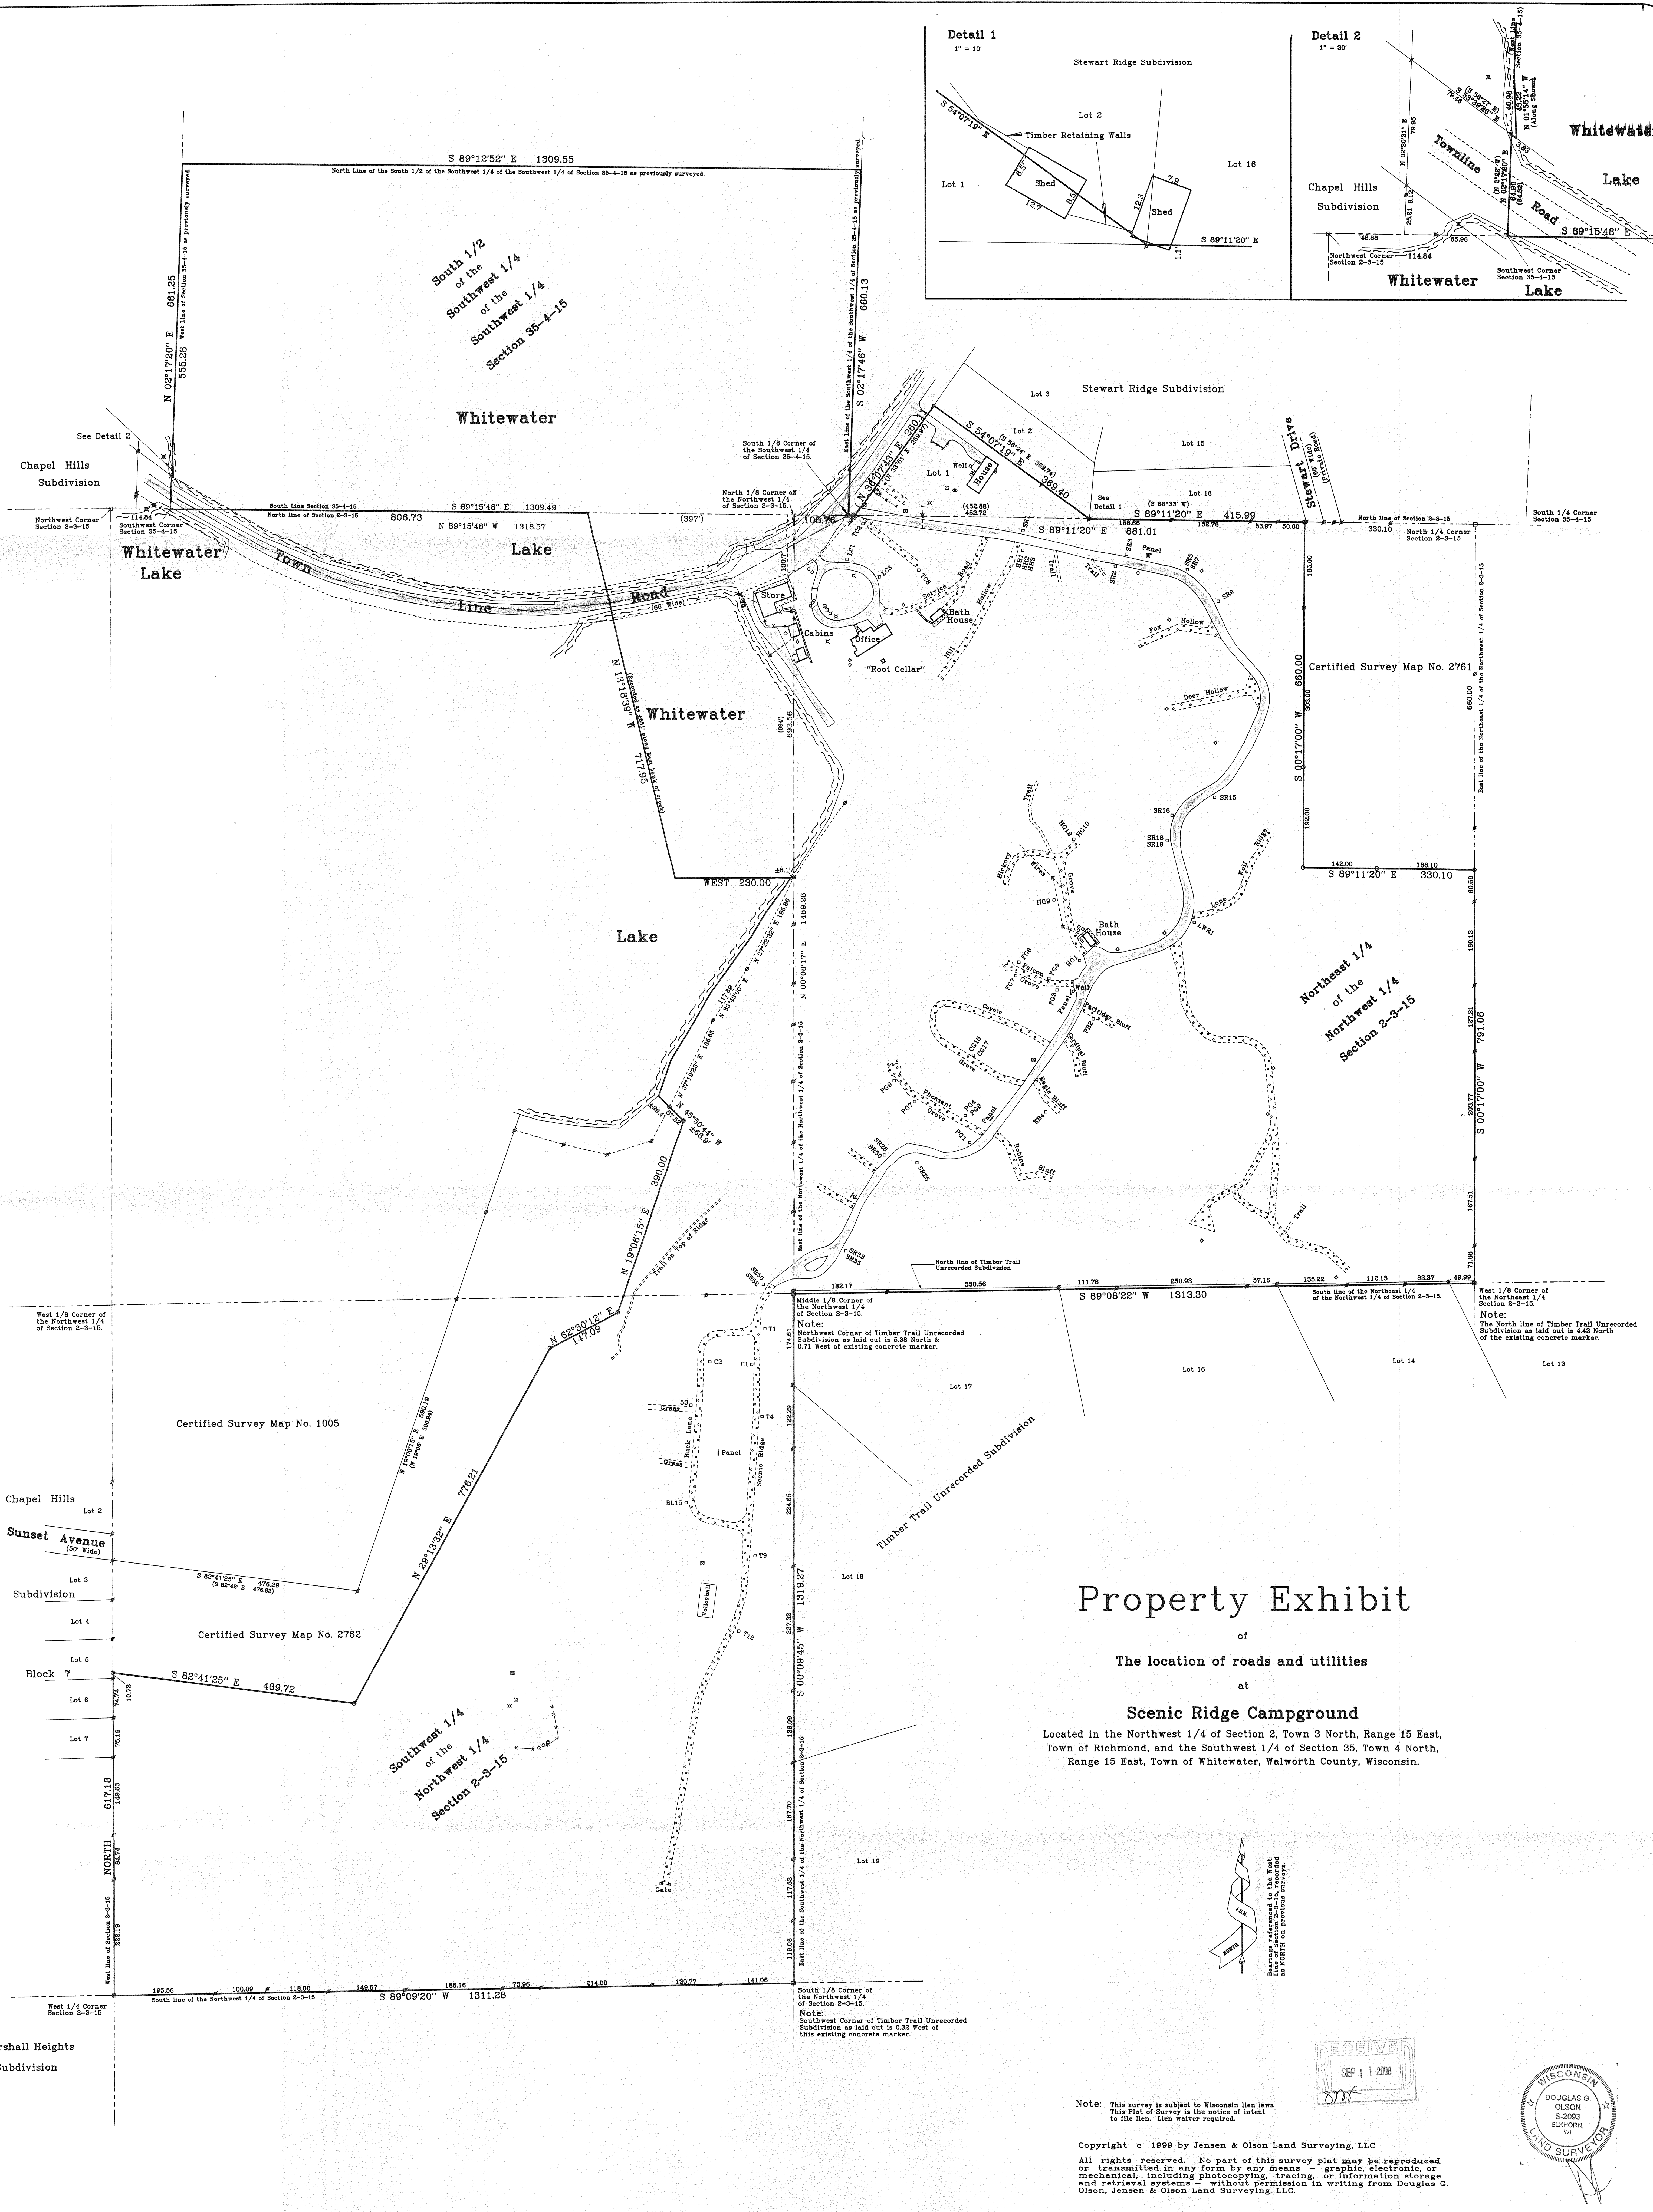


Property Exhibit

of
The location of roads and utilities
at
Scenic Ridge Campground
Located in the Northwest 1/4 of Section 2, Town 3 North, Range 15 East,
Town of Richmond, and the Southwest 1/4 of Section 35, Town 4 North,
Range 15 East, Town of Whitewater, Walworth County, Wisconsin.

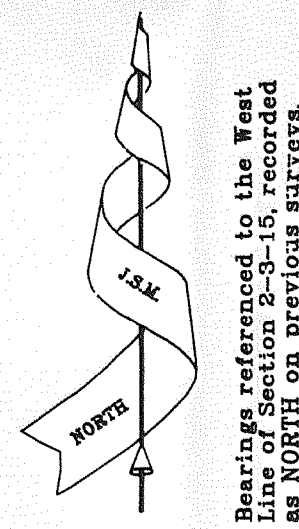

Note: This survey is subject to Wisconsin lien laws.
This Plat of Survey is the notice of intent
to file lien. Lien waiver required.

Copyright © 1999 by Jensen & Olson Land Surveying, LLC
All rights reserved. No part of this survey plat may be reproduced
or transmitted in any form by any means - graphic, electronic, or
mechanical, including photocopying, tracing, or information storage
and retrieval systems - without permission in writing from Douglas G.
Olson, Jensen & Olson Land Surveying, LLC.

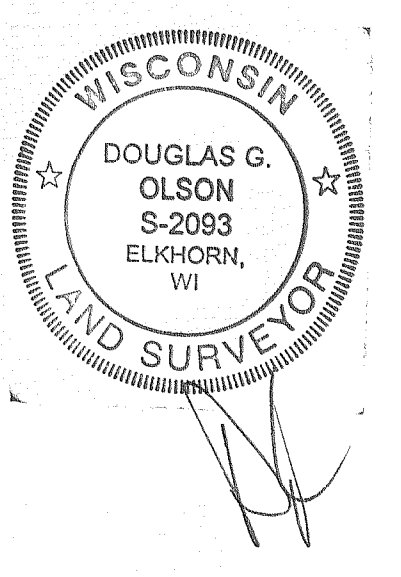

Sheet 1 of 3 Sheets.	Legend Found Concrete Monument as shown on Walworth County Section Corner 71e Sheets Found Iron Pipe Found Iron Rod Set Iron Pipe, 1" dia. Recorded Information Blacktop Surface Concrete Surface Gravel Surface Wood Post at Site	Mapping date: Sept. 15, 1999. Revisions:	Jensen & Olson Land Surveying, LLC 45 South Wisconsin Street P.O. Box 322 Elkhorn, Wisconsin 53121 Telephone (262) 723-3434 Facsimile (262) 723-8044	Scenic Ridge Campground W7991 R/W Townline Road Whitewater, Wisconsin. 53190	Scale in Feet 1"=100' 0' 50' 100' 200' 300'
Job Reference Number 1999.092					

CR2-8 CR2-3J CR2-4A

315-1070