




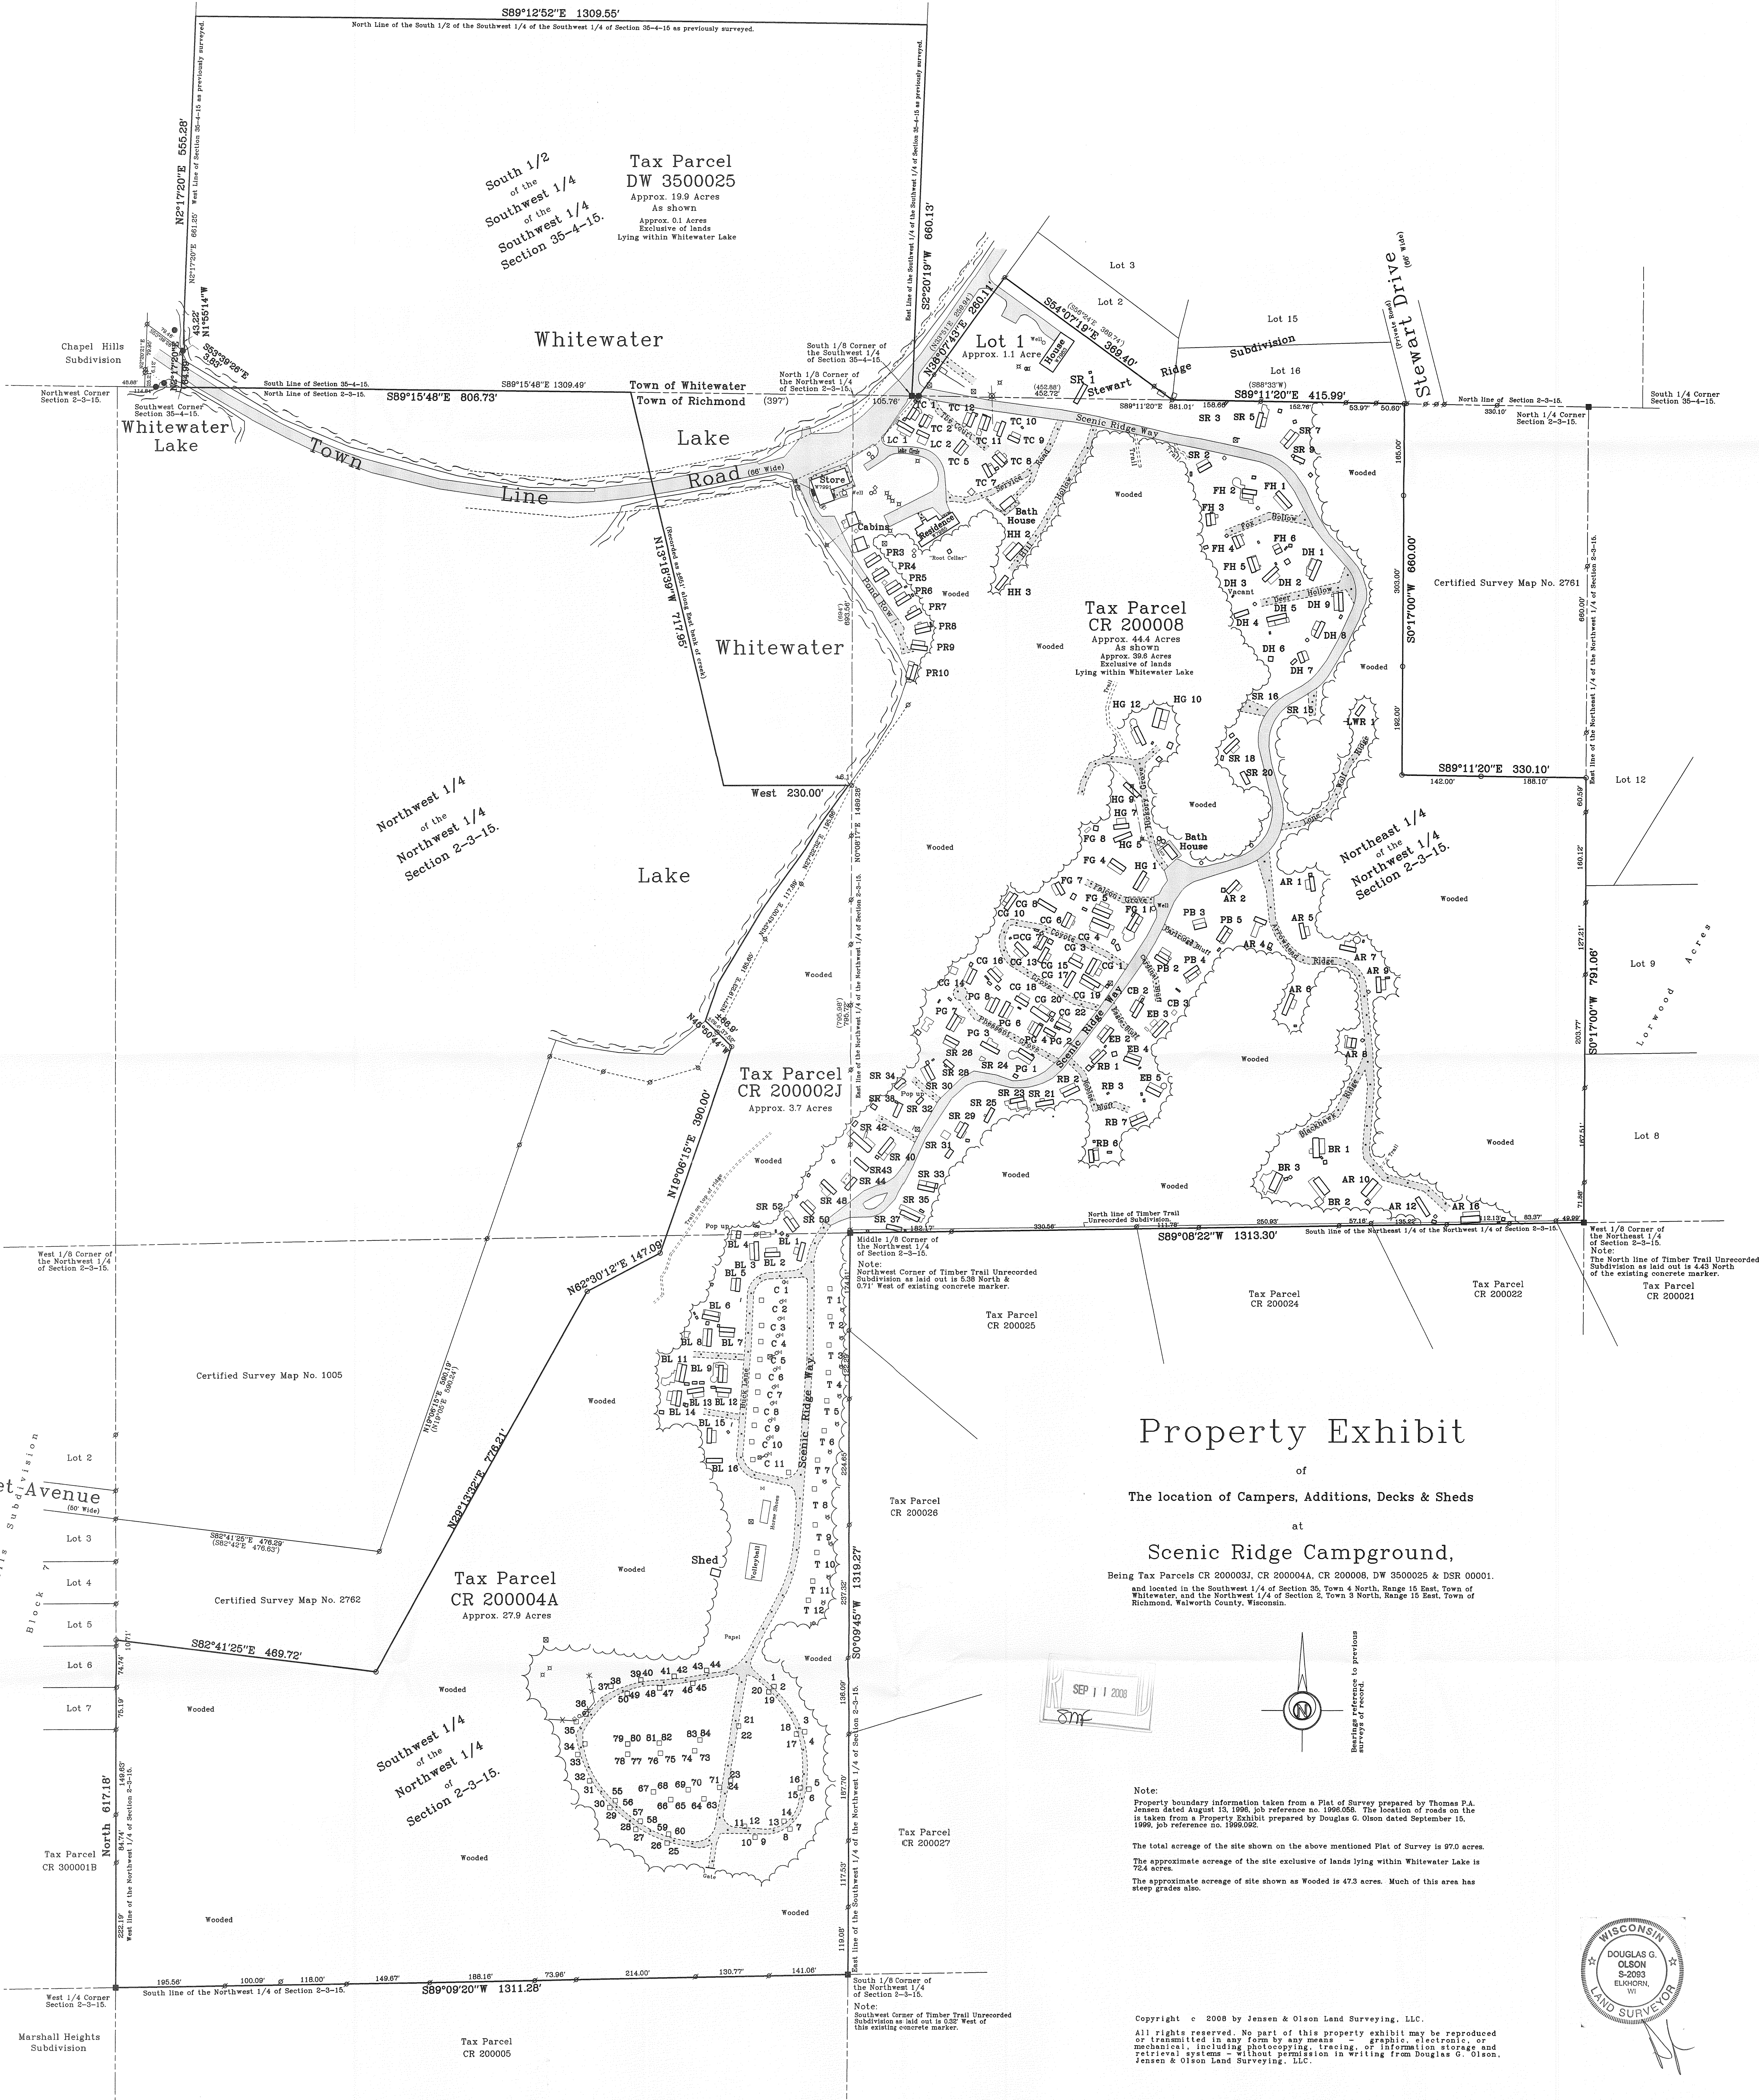

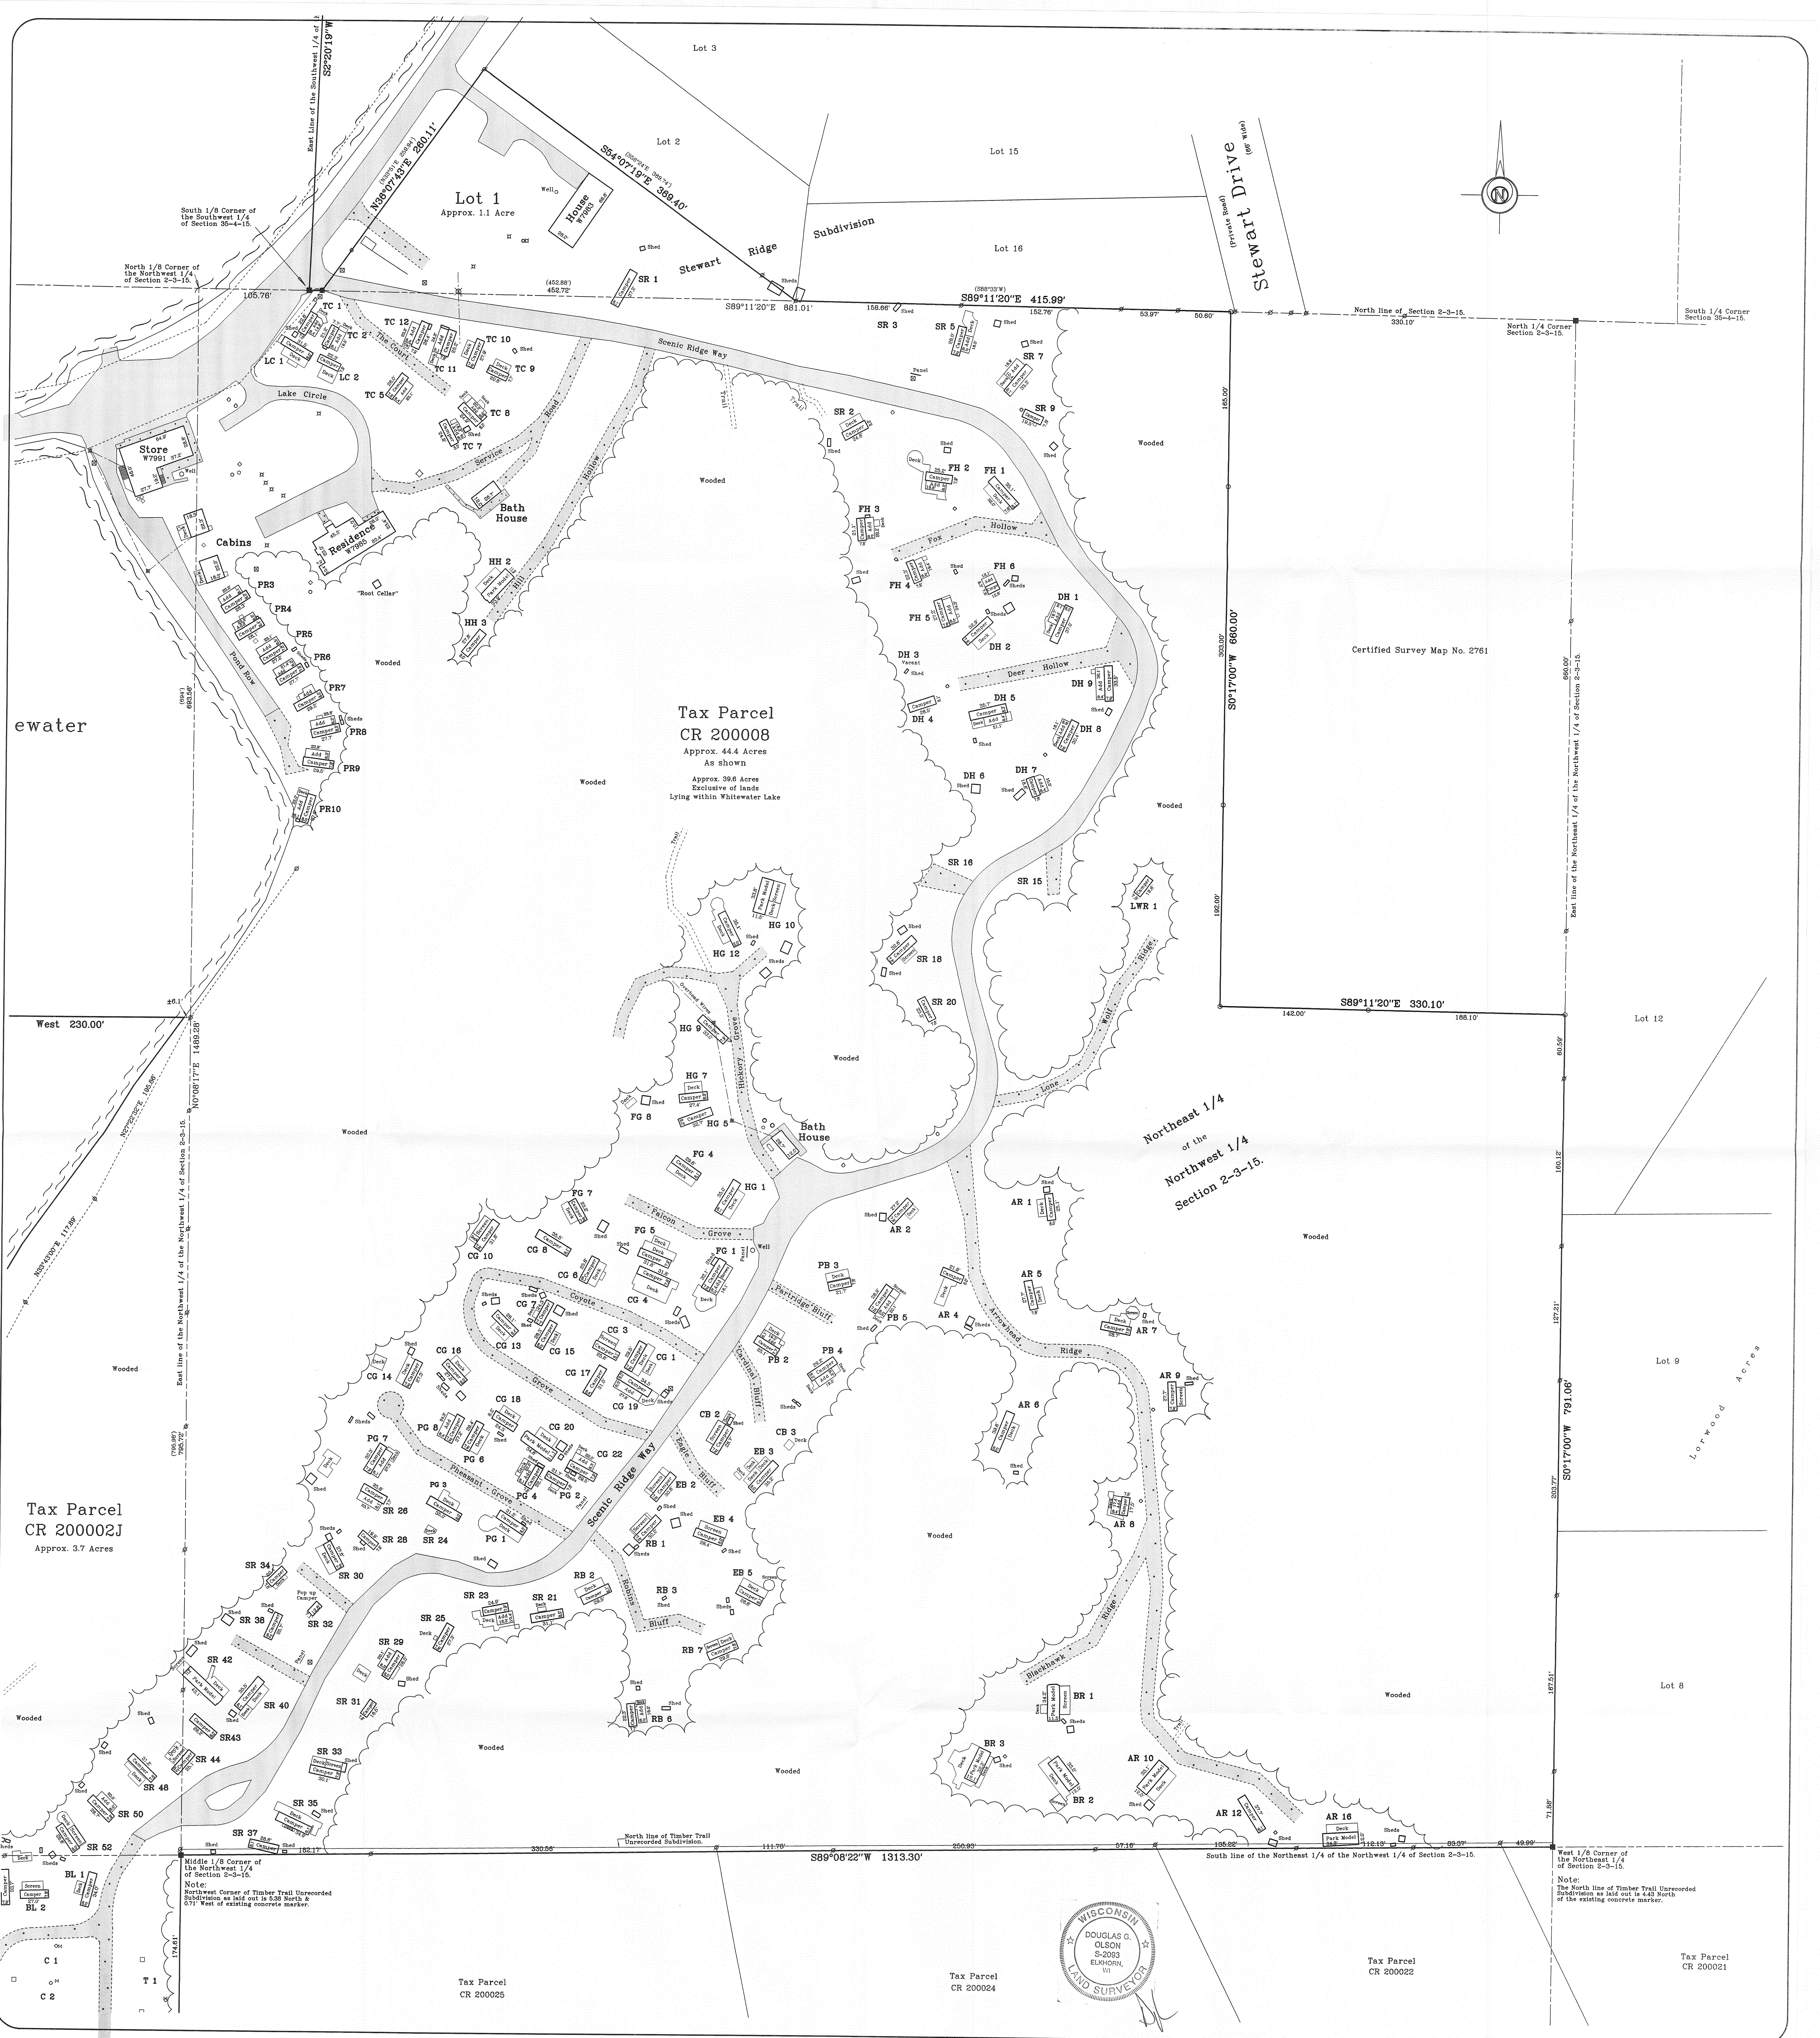

20080201	Sheet 3 of 4 Sheets. Job Reference Number 2008.021	Legend Found Concrete Monument as shown on Walworth County Section Corner the sheets Found Iron Rod Recorded Information Electric Box Outlet Box Telephone Pedestal Utility Pole Concrete Cover Septic Vent Asphalt Surface Gravel Surface Site Marker Sign Septic Cleanout Electric Panel with meter Fence Concrete Surface Gravel Surface	Jensen & Olson Land Surveying, LLC 45 South Wisconsin Street P.O. Box 322 Elkhorn, Wisconsin. 53121 Telephone: (262) 723-3434 Facsimile: (262) 723-8044	Scenic Ridge Campground W7991 R & W Town Line Road Whitewater, Wisconsin. 53190	Scale in Feet 1" = 50' 0' 25' 50' 100' 150' Survey date: May 19, 2008. Revisions: No. 1 - Camper labeling
----------	---	--	--	--	--

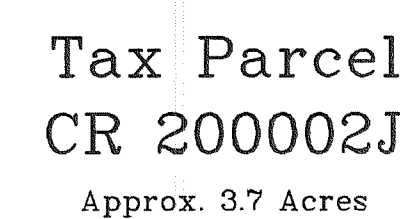

Approx. 3.7 Acres

Certified Survey Map No. 1005

Certified Survey Map No. 2762

Tax Parcel
CR 200004A
Approx. 27.9 Acres

Tax Parcel
CR 200026

Tax Parcel
CR 200027

South 1/8 Corner of
the Northwest 1/4
of Section 2-3-15.

Note:
Southwest Corner of Timber Trail Unrecorded
Subdivision as laid out is 0.32' West of
this existing concrete marker.

Survey date: May 19, 2008.
Revisions: No. 1 - Camper labeling

Scale in Feet

$$1'' = 50'$$

A circular seal for Douglas G. Olson, a Wisconsin Land Surveyor. The outer ring contains the text "WISCONSIN" at the top and "LAND SURVEYOR" at the bottom, separated by two five-pointed stars. The inner circle contains the text "DOUGLAS G. OLSON", "S-2093", and "ELKHORN, WI" in three lines.

Scenic Ridge Campground

W7991 R & W Town Line Road
Whitewater, Wisconsin. 53190

Jensen & Olson Land Surveying, LLC

45 South Wisconsin Street P.O. Box 322
Elkhorn, Wisconsin. 53121
Telephone: (262) 723-3434
Facsimile: (262) 723-8044

Sheet 4 of 4 Sheets.

Job Reference Number
2008.021

Legend

☒ Found Concrete Monument as shown on Walworth
☒ County Section Corner Tie Sheets
☒ Found Iron Pipe
☒ Found Iron Rod
☐ Recorded Information
☒ Electric Box
☒ Outlet Box
☒ Telephone Pedestal
☒ Utility Pole
☒ Concrete Cover
☒ Septic Vent
☒ Asphalt Surface
☐ Site Marker Sign
☒ Septic Cleanout
☒ Electric Panel with meter
☒ Fence
☒ Concrete Surface
☒ Gravel Surface

008.021