


ABELL
SURVEYING & MAPPING

1140 SEQUOIA STREET • DELAVAN, WISCONSIN 53115
262-728-6737

WEST 1/4 CORNER
SECTION 22-3-15

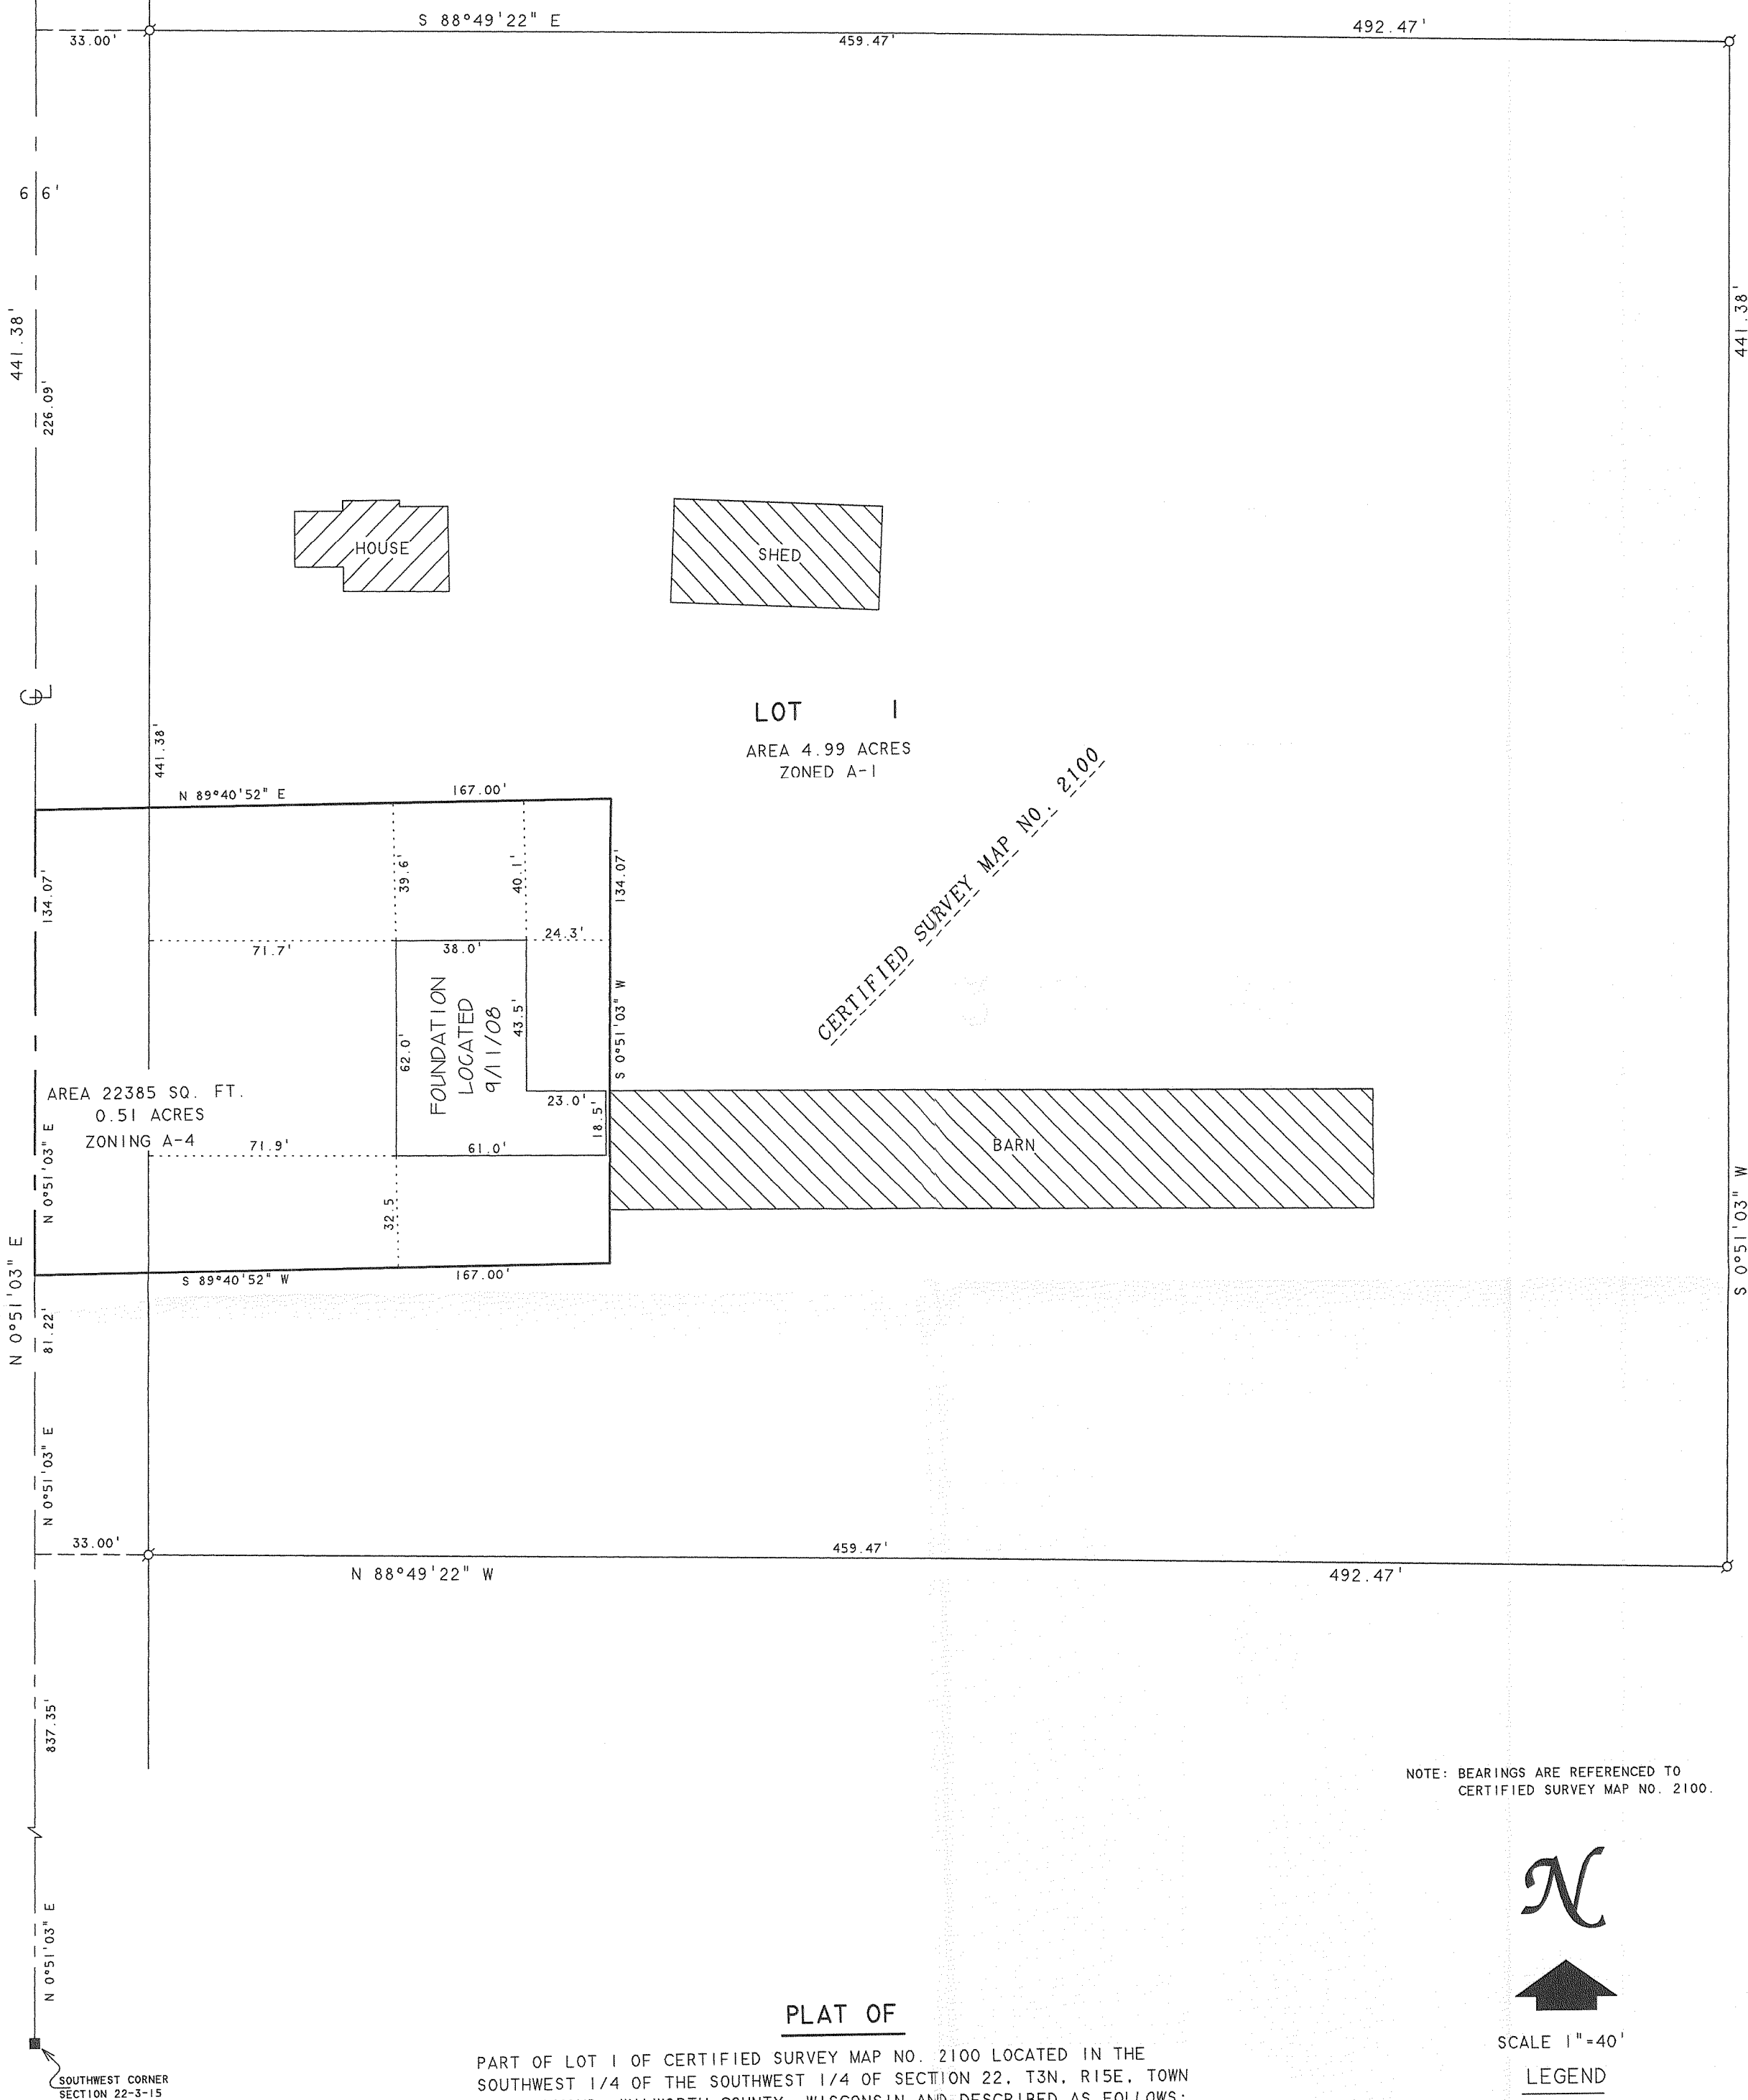

NOTE: BEARINGS ARE REFERENCED TO
CERTIFIED SURVEY MAP NO. 2100.

N




SCALE 1"=40'

LEGEND

- - IRON PIPE FOUND
- - CONCRETE MONUMENT FOUND
- P - PROPOSED PARKING STALL
10.6'X17' AREA 180 SQ. FT.
- - EXTERIOR LIGHT
- D - 8'X10'X5' DUMPSTER

PLAT OF

PART OF LOT 1 OF CERTIFIED SURVEY MAP NO. 2100 LOCATED IN THE
SOUTHWEST 1/4 OF THE SOUTHWEST 1/4 OF SECTION 22, T3N, R15E, TOWN
OF RICHMOND, WALWORTH COUNTY, WISCONSIN AND DESCRIBED AS FOLLOWS:
COMMENCING AT THE SOUTHWEST CORNER OF SAID SECTION 22; THENCE
N 0°51'03" E ALONG THE WEST LINE OF SAID SECTION 22; 837.35 FEET
TO THE SOUTHWEST CORNER OF SAID CERTIFIED SURVEY MAP; THENCE
CONTINUE N 0°51'03" E ALONG SAID WEST LINE, 81.22 FEET TO THE PLACE
OF BEGINNING; THENCE CONTINUE N 0°51'03" E ALONG SAID WEST LINE,
134.07 FEET; THENCE N 89°40'52" E 167.00 FEET; THENCE S 0°51'03" W
134.07 FEET; THENCE S 89°40'52" W 167.00 FEET TO THE WEST LINE OF
SAID SOUTHWEST 1/4 AND THE PLACE OF BEGINNING, CONTAINING 0.51
ACRES OF LAND MORE OR LESS.

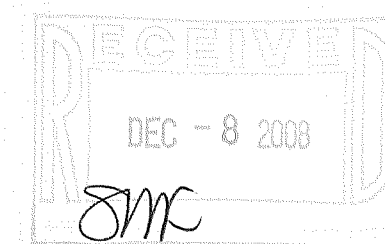

David F. Abell

DAVID F. ABELL
WISCONSIN REGISTERED LAND SURVEYOR, S-1596

OWNERS: STEVE & DARLENE PINNOW
N5784 JOHNSON ROAD
DELAVAN, WI 53115

September 12, 2008

DATE: September 12, 2008 JOB NUMBER - 91256D
NOTE: THIS IS NOT A CERTIFIED COPY UNLESS SEALED.

CA2100-1

315-1080