


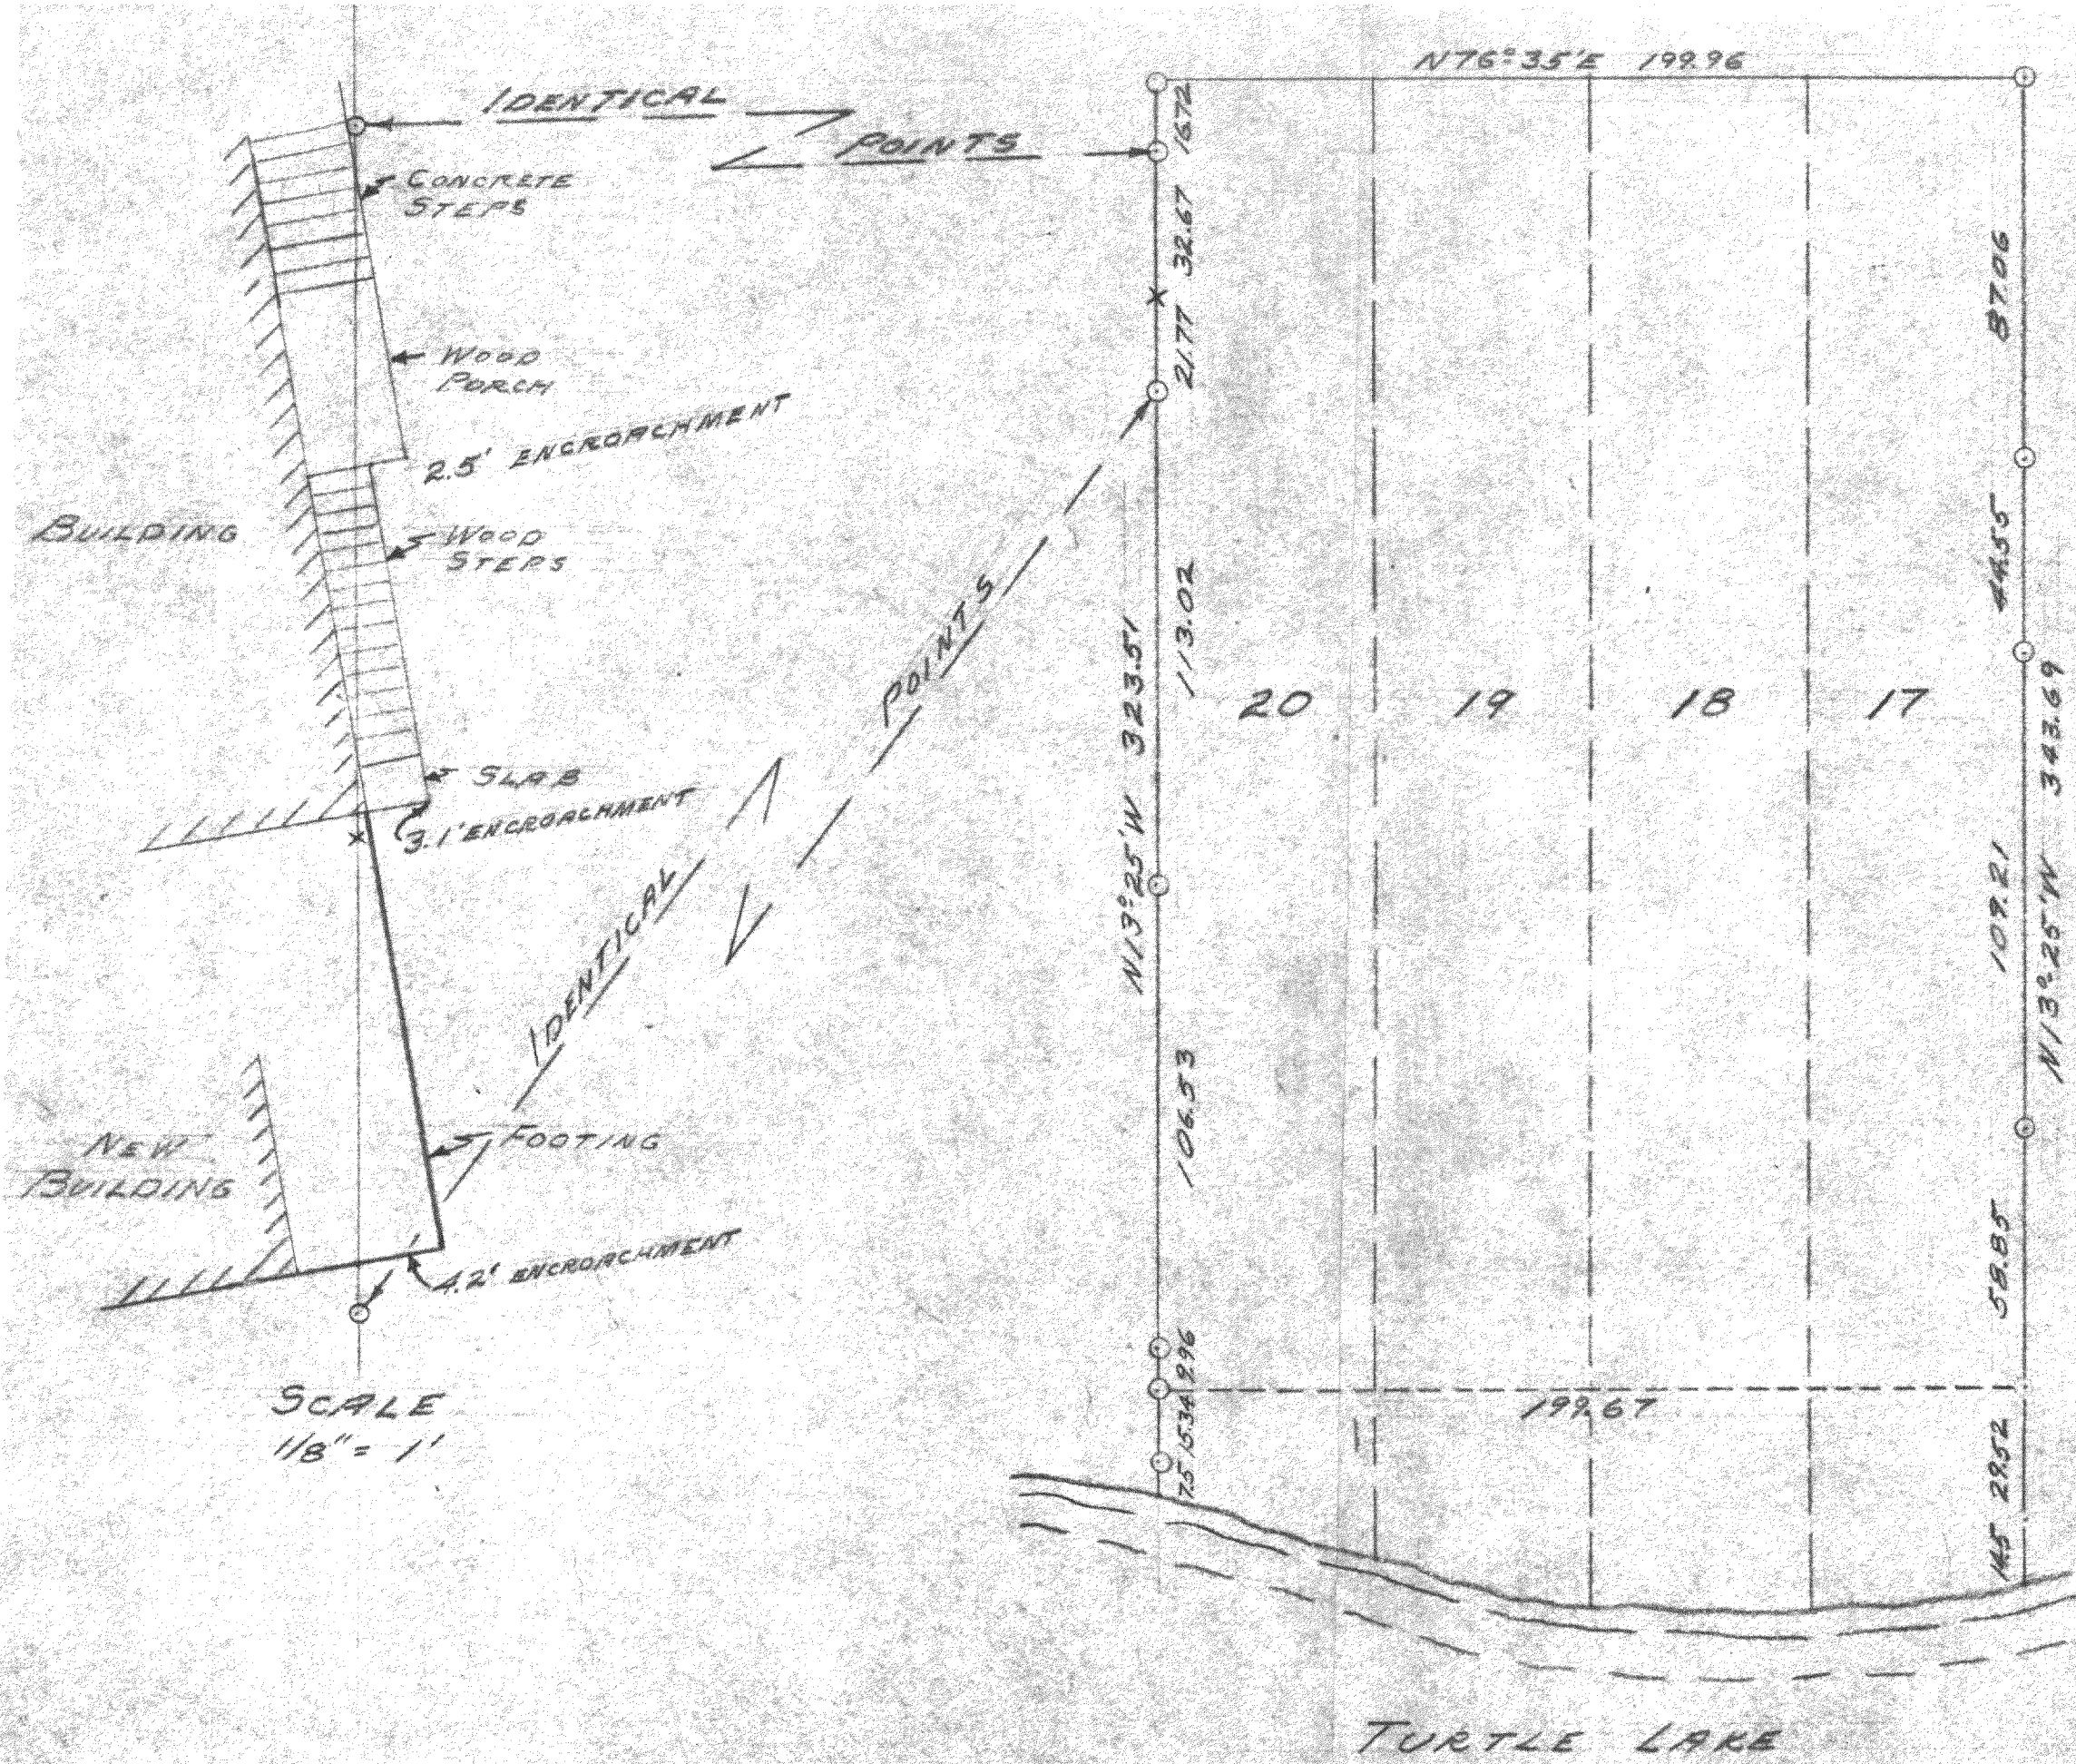

O = IRON PIPE
X = SPIKE IN CONC.

COR-13A
+ 19
COR-13, 14

315-11.1

PLAT OF SURVEY OF LOTS 17, 18, 19, AND 20 OAK PARK SUBDIVISION OF TURTLE LAKE WALWORTH CO., WISCONSIN	
Lloyd L. Jensen SURVEYOR	
SCALE 1" = 40'	DATE SEPT 1953