

# LAND-MARK SURVEYING

Mark L. Miritz




Wisconsin Registered Land Surveyor S-2582

N9330 Knuteson Drive  
Whitewater, WI 53190  
Phone: (262) 495-3284  
FAX : (262) 495-8421  
LAND-MARKSURVEYING.COM

OWNER: SONYA WARD  
N6613 JUNIPER ROAD  
DELAVER, WI 53115

## PLAT OF SURVEY

LOTS 5, 6 AND 8-14 INCLUSIVE OF BLOCK 9 OF  
SKANSEN SWEDISH TRIBUNE NEWS SUBDIVISION,  
LOCATED IN SECTION 9, TOWN 3 NORTH, RANGE  
15 EAST, WALWORTH COUNTY, WISCONSIN.

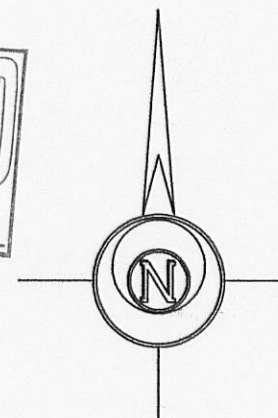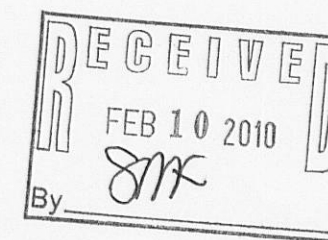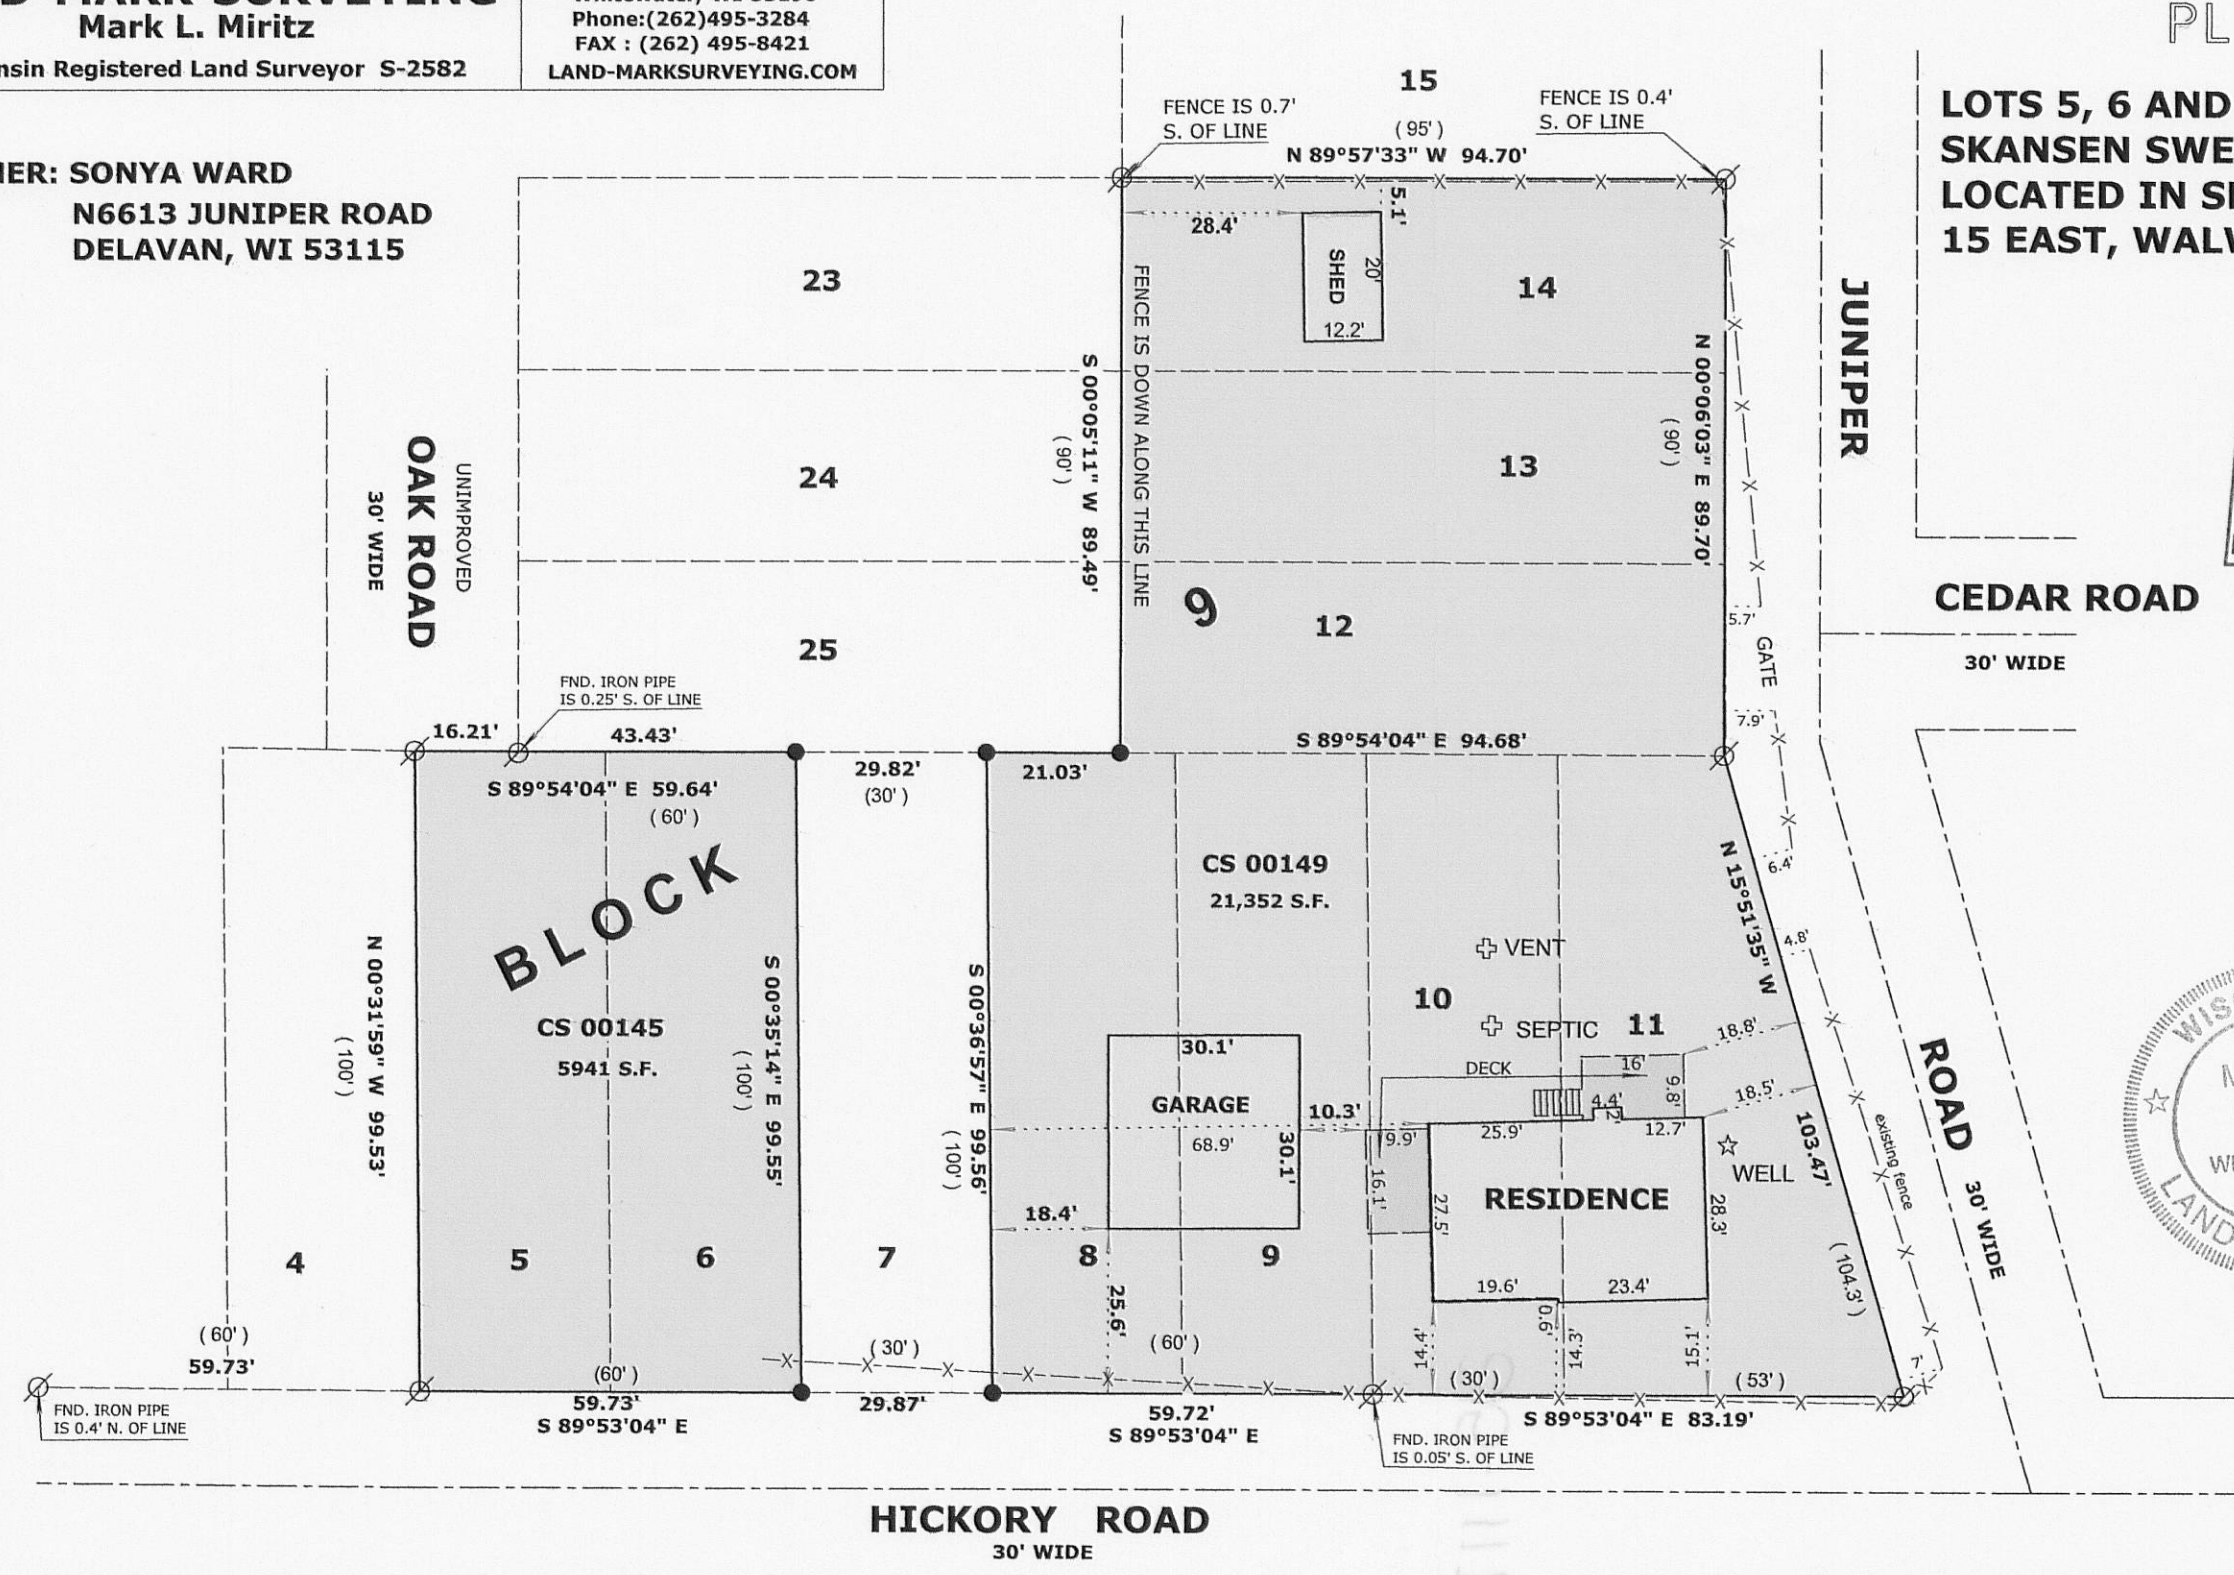

BEARINGS ARE BASED ON PREVIOUS SURVEYS OF RECORD

### LEGEND

- ⊗ FOUND IRON PIPE
- FOUND IRON ROD
- ⊠ FOUND COUNTY MONUMENT
- FOUND CONCRETE MONUMENT
- + CHISEL CUT IN CONCRETE
- SET IRON ROD, 24" LONG, WEIGHING 1.5 LBS./LINEAL FT., 3/4" DIA.
- ( x x ) RECORDED AS DIMENSION
- x-x- EXISTING FENCE



SCALE: 1" = 30 FEET

"I hereby certify that the above described property has been surveyed by me or under my direction and that the above map is a true representation thereof and shows the size and location of the property, its exterior boundaries, the location of all visible structures and dimensions of all principal buildings thereon, boundary fences, apparent easements, roadways and visible encroachments, if any."

"This survey is made for the use of the present owners of the property, and also those who purchase, mortgage, or guarantee the title thereto within one year from date hereof."

*Mark L. Miritz*  
MARK L. MIRITZ  
WISCONSIN REGISTERED  
LAND SURVEYOR S-2582

REVISED SEPT. 29, 2007 TO SHOW ADDITION "AS BUILT"  
REVISED OCT. 7, 2009 TO SHOW PROPOSED GARAGE  
REVISED JAN. 20, 2010 TO GARAGE & DECK "AS BUILT"  
AND MOVED SHED

DATE: AUG. 8, 2006 JOB NO. 06.803

CS-145 CS-149

315-1111