




PREPARED FOR:
KRIS KAYSER
KEEFE REAL ESTATE
LAKE GENEVA WI.

PLAT OF SURVEY

- OF -

PATHFINDER SURVEYING INC.
(formerly)
J.K. SURVEYING INC.
N3705 WILLOWBEND LANE
LAKE GENEVA, WI, 53147
262-248-8303

LOT 25, BLOCK G, IN CRYSTAL BOWL SUBDIVISION, A SUBDIVISION OF
PART OF THE SE 1/4 OF THE SW 1/4 OF SECTION 12 AND THE NE 1/4
OF THE NW 1/4 OF SECTION 13, TOWNSHIP 3 NORTH, RANGE 15
EAST, TOWN OF RICHMOND, COUNTY OF WALWORTH AND STATE
OF WISCONSIN.

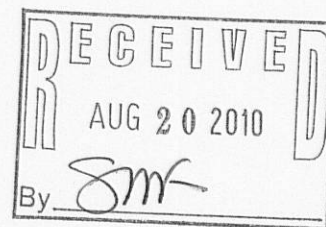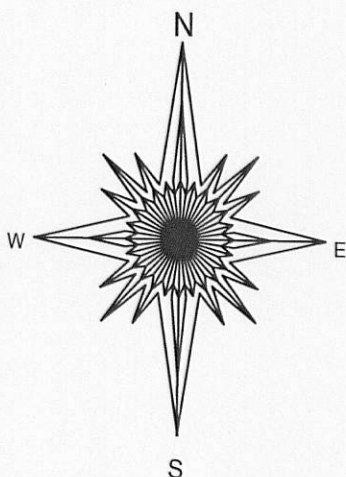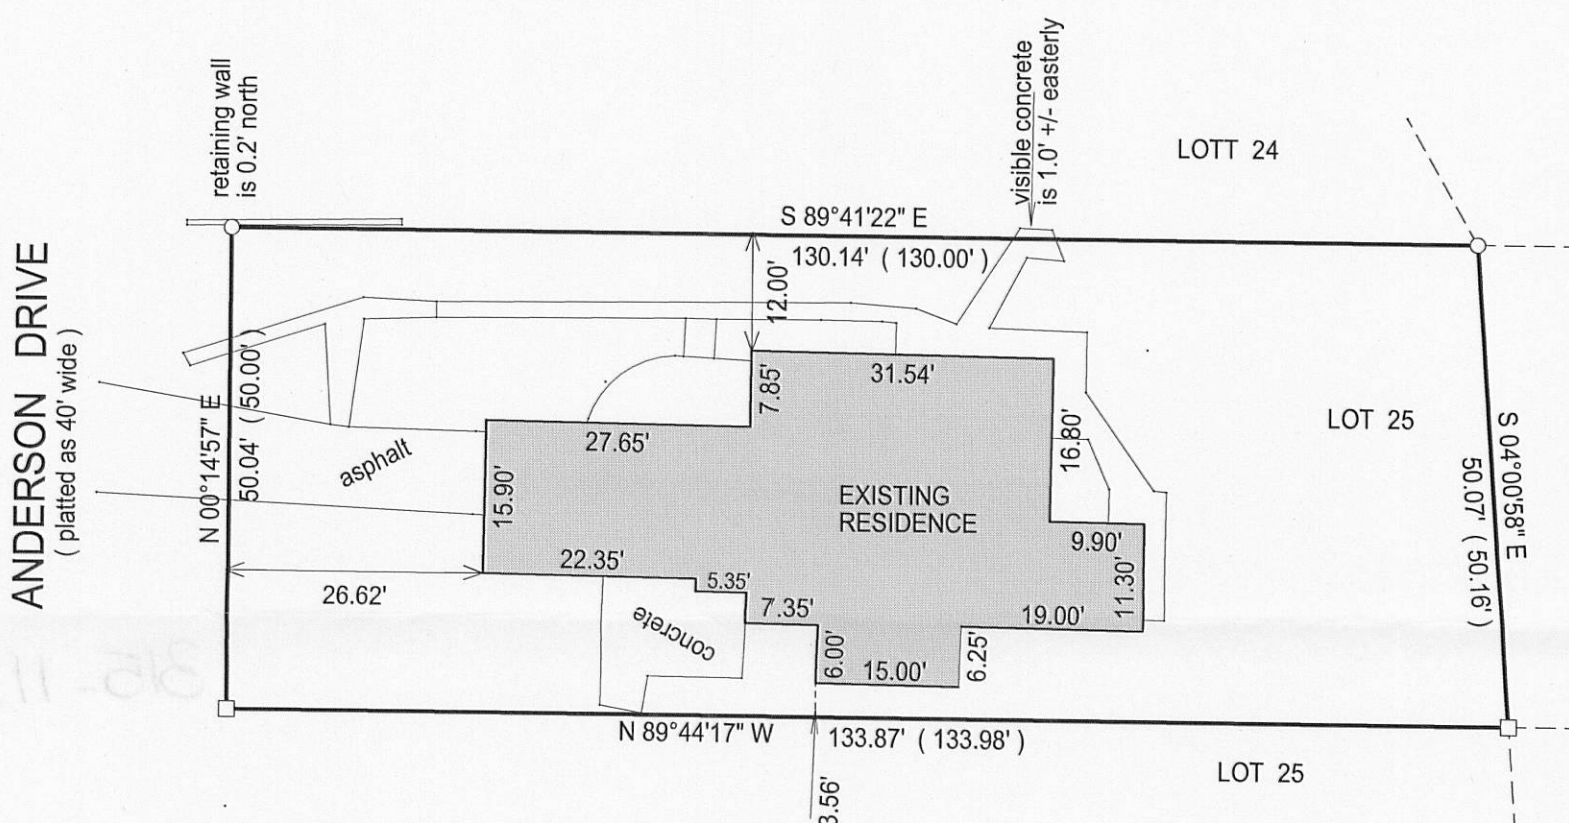

- () = recorded as
- = found iron bar
- = found iron pipe
- = set iron pipe
- = set iron bar



BASIS OF BEARING OF THIS PLAT: THE EAST LINE
OF ANDERSON DR. WAS ASSUMED TO BEAR
N 0°14'57"E.

SCALE 1" = 20'

JOB # 10-36

TAX ID #
CCR00131

"I hereby certify that I have surveyed the above described property and that the above map is a true representation of its exterior boundary and shows the size and location of all visible structures, apparent easements and encroachments if any."

This survey is made for the present owners of the property, and those who purchase, mortgage, or guarantee the title thereto, within one year from the date hereof.

DATED THIS 5TH DAY OF APRIL, 2010.



JEFFREY L. KIMPS S - 2436
Wisconsin Registered Land Surveyor
(original if signed in red)