

DEGEN - FOAT SURVEYING, INC.

100 SOUTH SECOND STREET
WATERFORD, WISCONSIN 53185
(262)534-5404 (FAX)534-2022

104024
104024S1.DWG

PLAT OF SURVEY


LOT 3, BLOCK 6, CHAPEL HILLS SUBDIVISION, LOCATED IN THE NORTHEAST 1/4 OF SECTION 3,
TOWN 3 NORTH, RANGE 15 EAST, TOWN OF RICHMOND, WALWORTH COUNTY, WISCONSIN.

* REFER TO A CURRENT TITLE REPORT FOR EASEMENTS, RESTRICTIONS OR COVENANTS OF RECORD THAT MAY AFFECT THIS LAND. *

SURVEY PREPARED FOR: ATTY. DAVID SMITH
P.O. BOX 268
TWIN LAKES, WI 53181

OWNER: JOHN & CATHERINE THOMPSON
1302 E. THAYER
MT. PROSPECT, IL 60056

SITE ADDRESS: N7207 CHAPEL DRIVE
WHITEWATER, WI 53190


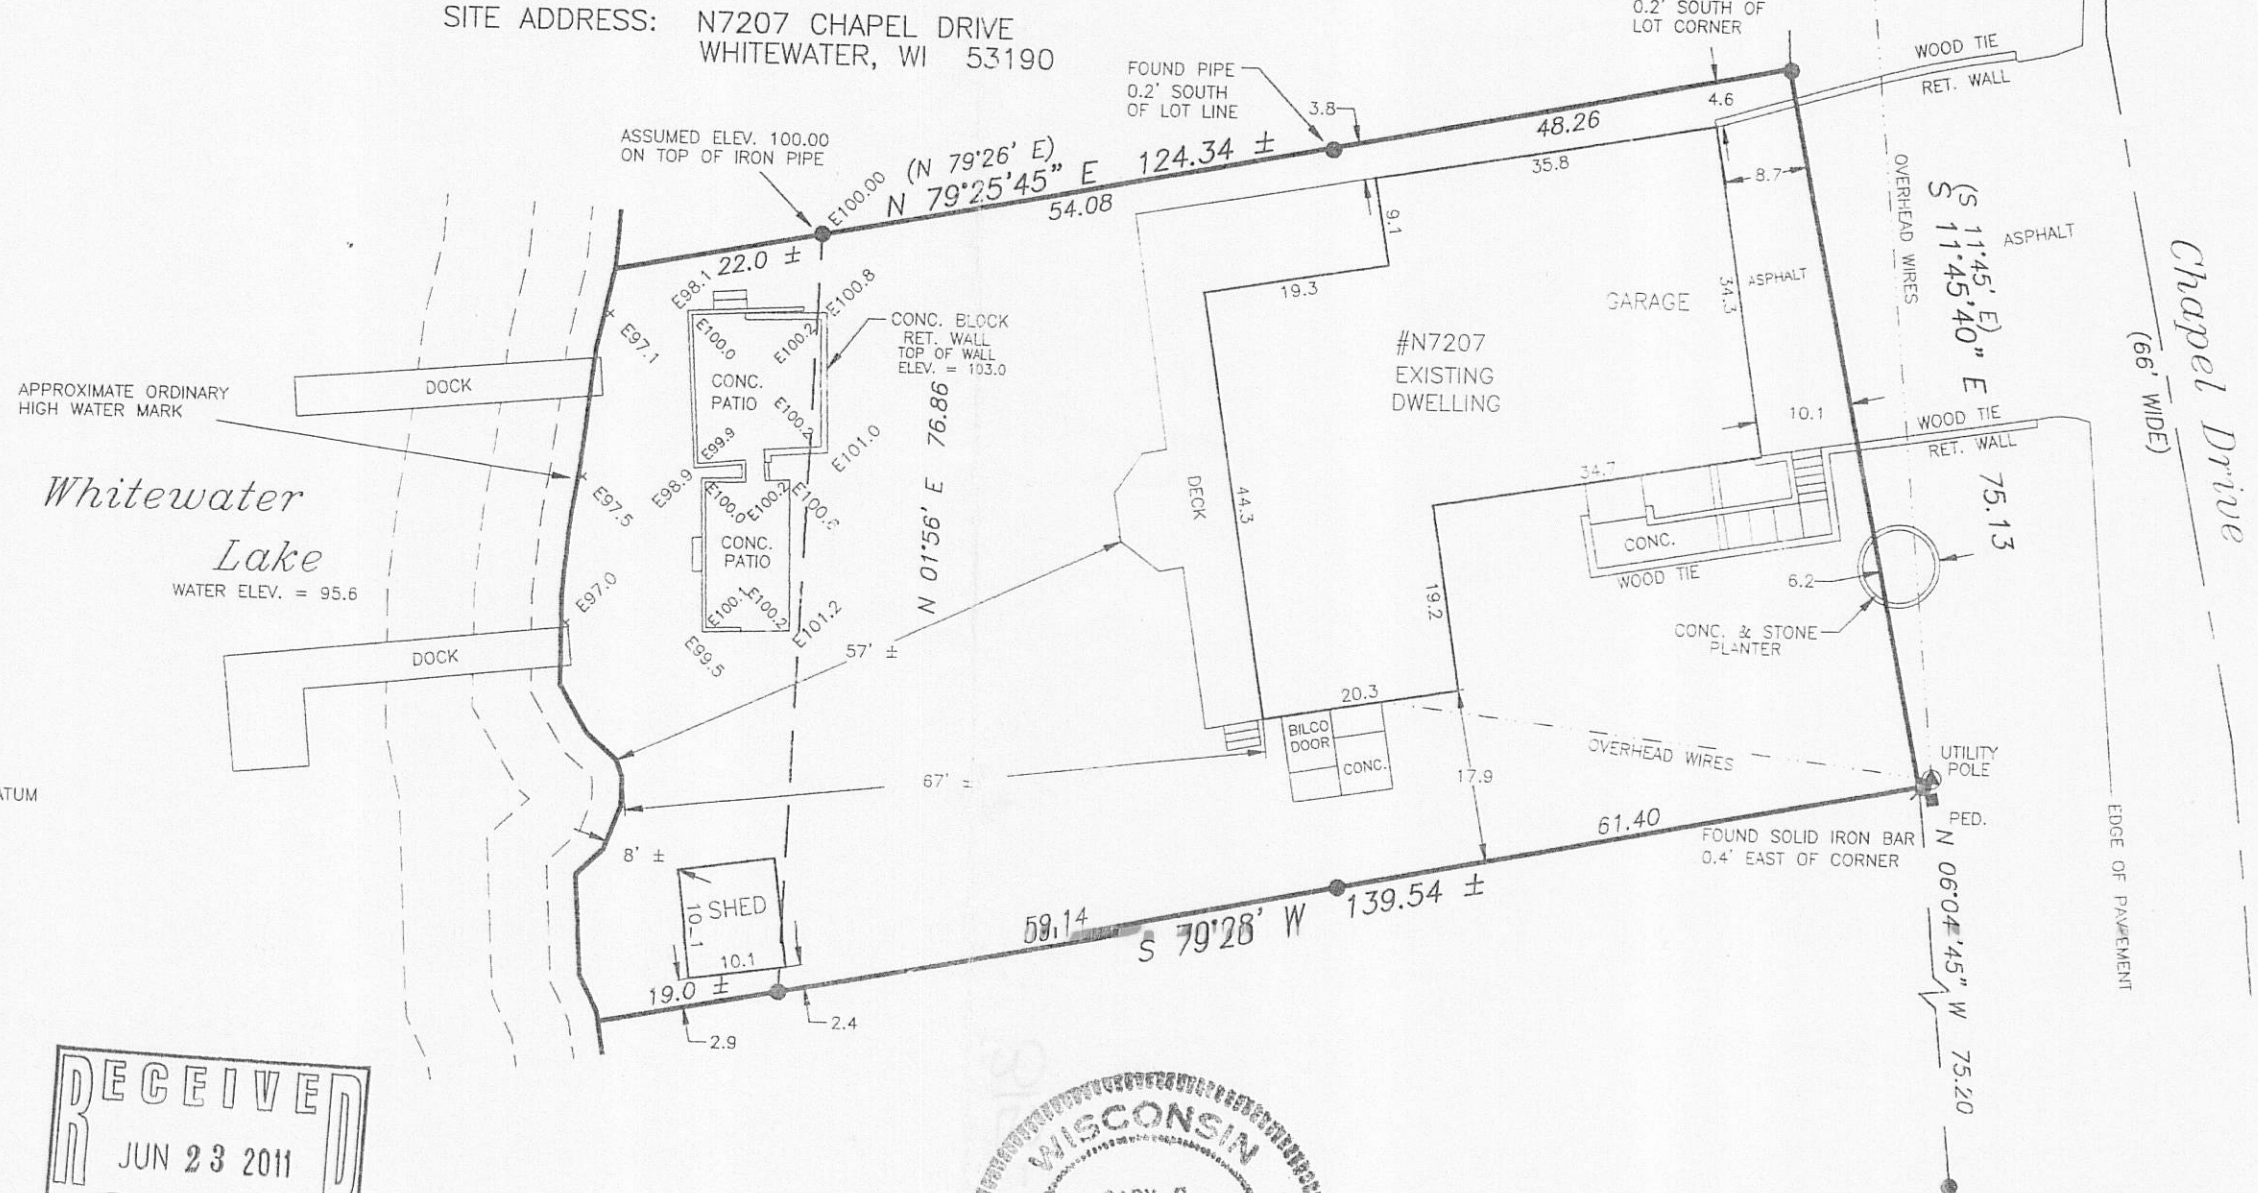


SCALE: 1" = 20'

BEARING BASE: AS RECORDED AS.

LEGEND

- - FOUND SOLID IRON BAR
- - FOUND IRON PIPE
- () - RECORDED AS
- E = ELEVATIONS BASED ON ASSUMED DATUM

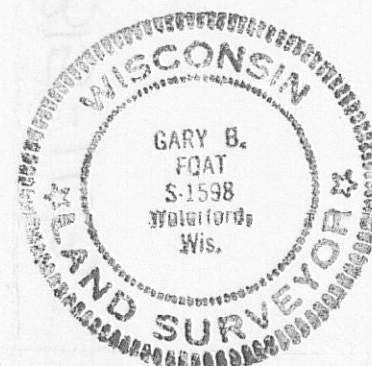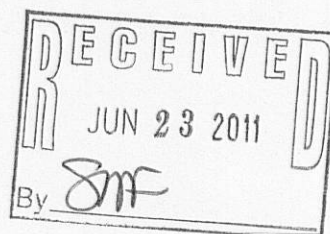

I HEREBY CERTIFY THAT I HAVE SURVEYED THE ABOVE DESCRIBED PROPERTY AND THE ABOVE MAP IS A TRUE REPRESENTATION THEREOF AND SHOWS THE SIZE AND LOCATION OF THE PROPERTY, THE LOCATION OF ALL VISIBLE STRUCTURES AND DIMENSIONS AT ALL PRINCIPAL BUILDINGS THEREON, BOUNDARY FENCES, APPARENT EASEMENTS, ROADWAY AND VISIBLE ENCROACHMENTS, IF ANY.

THIS SURVEY IS MADE FOR THE PRESENT OWNERS OF THE PROPERTY, AND ALSO THOSE WHO PURCHASE, OR GUARANTEE THE TITLE THERETO WITHIN (1) YEAR FROM THE DATE HEREOF.

DATED AT WATERFORD, WI THIS 22nd DAY OF April 2010

RECEIVED _____

Gary B. Foat

315-1153

CCH-13B