


FARRIS, HANSEN & ASSOC. INC.

7 RIDGWAY COURT- P.O. BOX 437
ELKHORN, WISCONSIN 53121
PHONE (262) 723-2098
FAX (262) 723-5886

ORDERED BY: MIKE SANGER
2741 WEST LAYTON AVE
MILWAUKEE, WI. 53221

PLAT OF SURVEY
LOT 33, BLOCK 3 SKANSSENS SWEDISH TRIBUNE-NEWS FIRST ADDITION
LOCATED IN TOWN 3 NORTH, RANGE 15 EAST
WALWORTH COUNTY, WISCONSIN

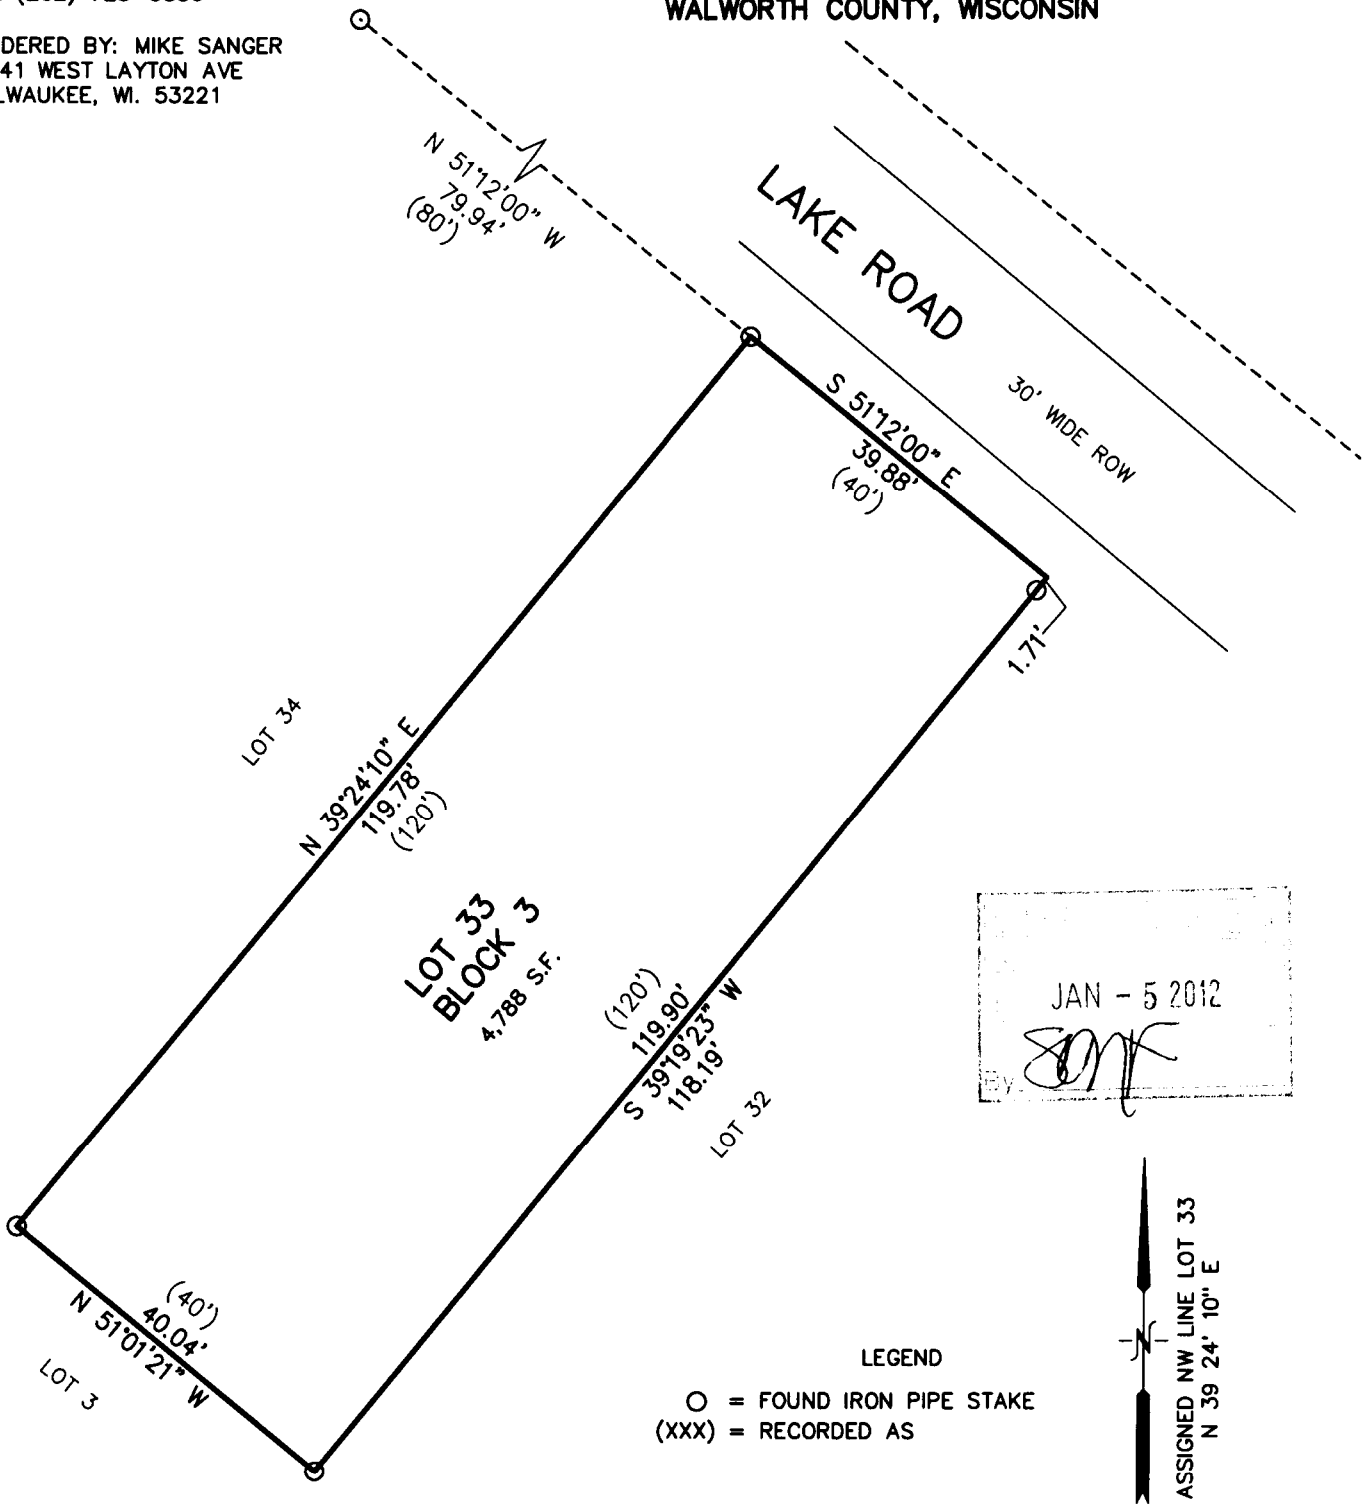

JAN - 5 2012
BY: *[Signature]*

NOTE: COPIES OF THIS MAP TO WHICH THE FOLLOWING CERTIFICATE WILL APPLY SHOW SURVEYOR'S ORIGINAL SEAL AND SIGNATURE IN RED INK. COPIES BY ANY OTHER MEANS MAY HAVE ALTERATIONS WHICH DO NOT REPRESENT THE SURVEYOR'S WORK PRODUCT.


I HEREBY CERTIFY THAT THE ABOVE DESCRIBED PROPERTY HAS BEEN SURVEYED UNDER MY DIRECTION AND THAT THE ABOVE MAP IS A TRUE REPRESENTATION THEREOF AND SHOWS THE SIZE AND LOCATION OF THE PROPERTY AND ITS EXTERIOR BOUNDARIES. THIS SURVEY IS MADE FOR THE USE OF THE PRESENT OWNERS OF THE PROPERTY, AND ALSO THOSE WHO PURCHASE, MORTGAGE, OR GUARANTEE THE TITLE THERETO WITHIN ONE YEAR FROM THE DATE HEREOF.

DATED: DECEMBER 09, 2011

REVISED 12-22-2011
CHANGE STREET NAME

[Signature]
PETER S. GORDON R.L.S. 2101

PROJECT NO. 8481
DATED: 12-09-2011
SHEET 1 OF 1 SHEETS

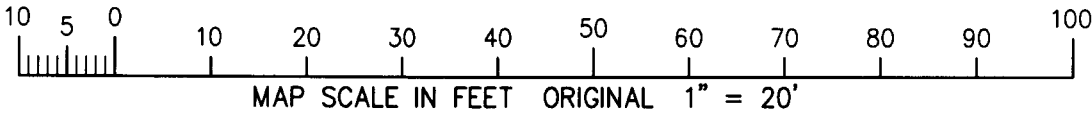

CSA62

315-1161