

LOTS 32, 33 AND 34, BLOCK 3, FOREST BEACH, TOWN OF RICHMOND, WALWORTH COUNTY,
WISCONSIN.


STATE OF WISCONSIN
COUNTY OF ROCK SS.

I HEREBY CERTIFY THAT I HAVE SUPERVISED THE SURVEY OF THE PROPERTY DESCRIBED ABOVE FOR THE EXCLUSIVE USE OF LARRY NIQUET AND THAT TO THE BEST OF MY KNOWLEDGE AND BELIEF THE PLAT HEREON DRAWN CORRECTLY REPRESENTS SAID SURVEY AND ITS LOCATION.

GIVEN UNDER MY HAND AND SEAL THIS 10th DAY OF MAY, 2012, AT JANESVILLE, WISCONSIN.

Ronald J. Combs
R.L.S. Number 1330

If the surveyor's signature is not red in color, the map is a copy and may contain unauthorized alterations. The certification contained hereon shall not apply to any copies.

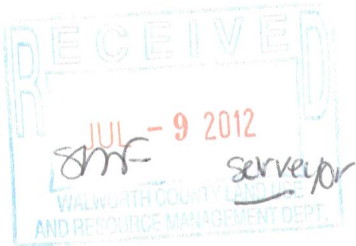

TERRY PISAREK SURVEY
REVISED 4/5/2010

BLOCK 4

N80°17'56"E

N80°17'56"E

123.50
15.15
15.15
15.15

32

33

34

S4°45'22"E

40'

LAKE LORRAINE

GRAPHIC SCALE 1"=50'



A horizontal graphic scale bar with alternating black and white segments. It is marked with '0'', '25'', '50'', and '75''.

- SET IRON PIN, 3/4"x 24", 1.5 LBS./LIN.FT.
- ◎ FOUND IRON PIPE
- FOUND CONCRETE MONUMENT

NOTES:

THIS SURVEY IS SUBJECT TO ANY AND ALL EASEMENTS
AND AGREEMENTS, RECORDED AND UNRECORDED.

ASSUMED N80°17'56"E ALONG THE SOUTH LINE OF BLOCK
4. AS SHOWN ON PISERAK SURVEY.

Project No. 112 - 114 For: NIQUET



Combs
& ASSOCIATES INC.

- LAND SURVEYING
- LAND PLANNING
- CIVIL ENGINEERING

109 W. Milwaukee St.
Janesville, WI 53548
www.compssurvey.com

tel: 608 752-0575
fax: 608 752-0534

CFB-20B CFB-20C

315-1173