

# Plat of Survey

of

## Lots 9 through 13 and 15 through 17 in Block 1 of Skansen Swedish Tribune News Subdivision,

located in the Northwest 1/4 and the Southwest 1/4 of Section 9, Town 3 North, Range 15 East, Town of Richmond, Walworth County, Wisconsin.


Surveyed for: **Emil Arens**  
W8690 Lake Road  
Delavan, Wisconsin. 53115

**Lake**

**Lorraine**

Water Elevation on February 23, 2012, 916.75.

Approximate high water elevation based upon evidence of erosion 921.1

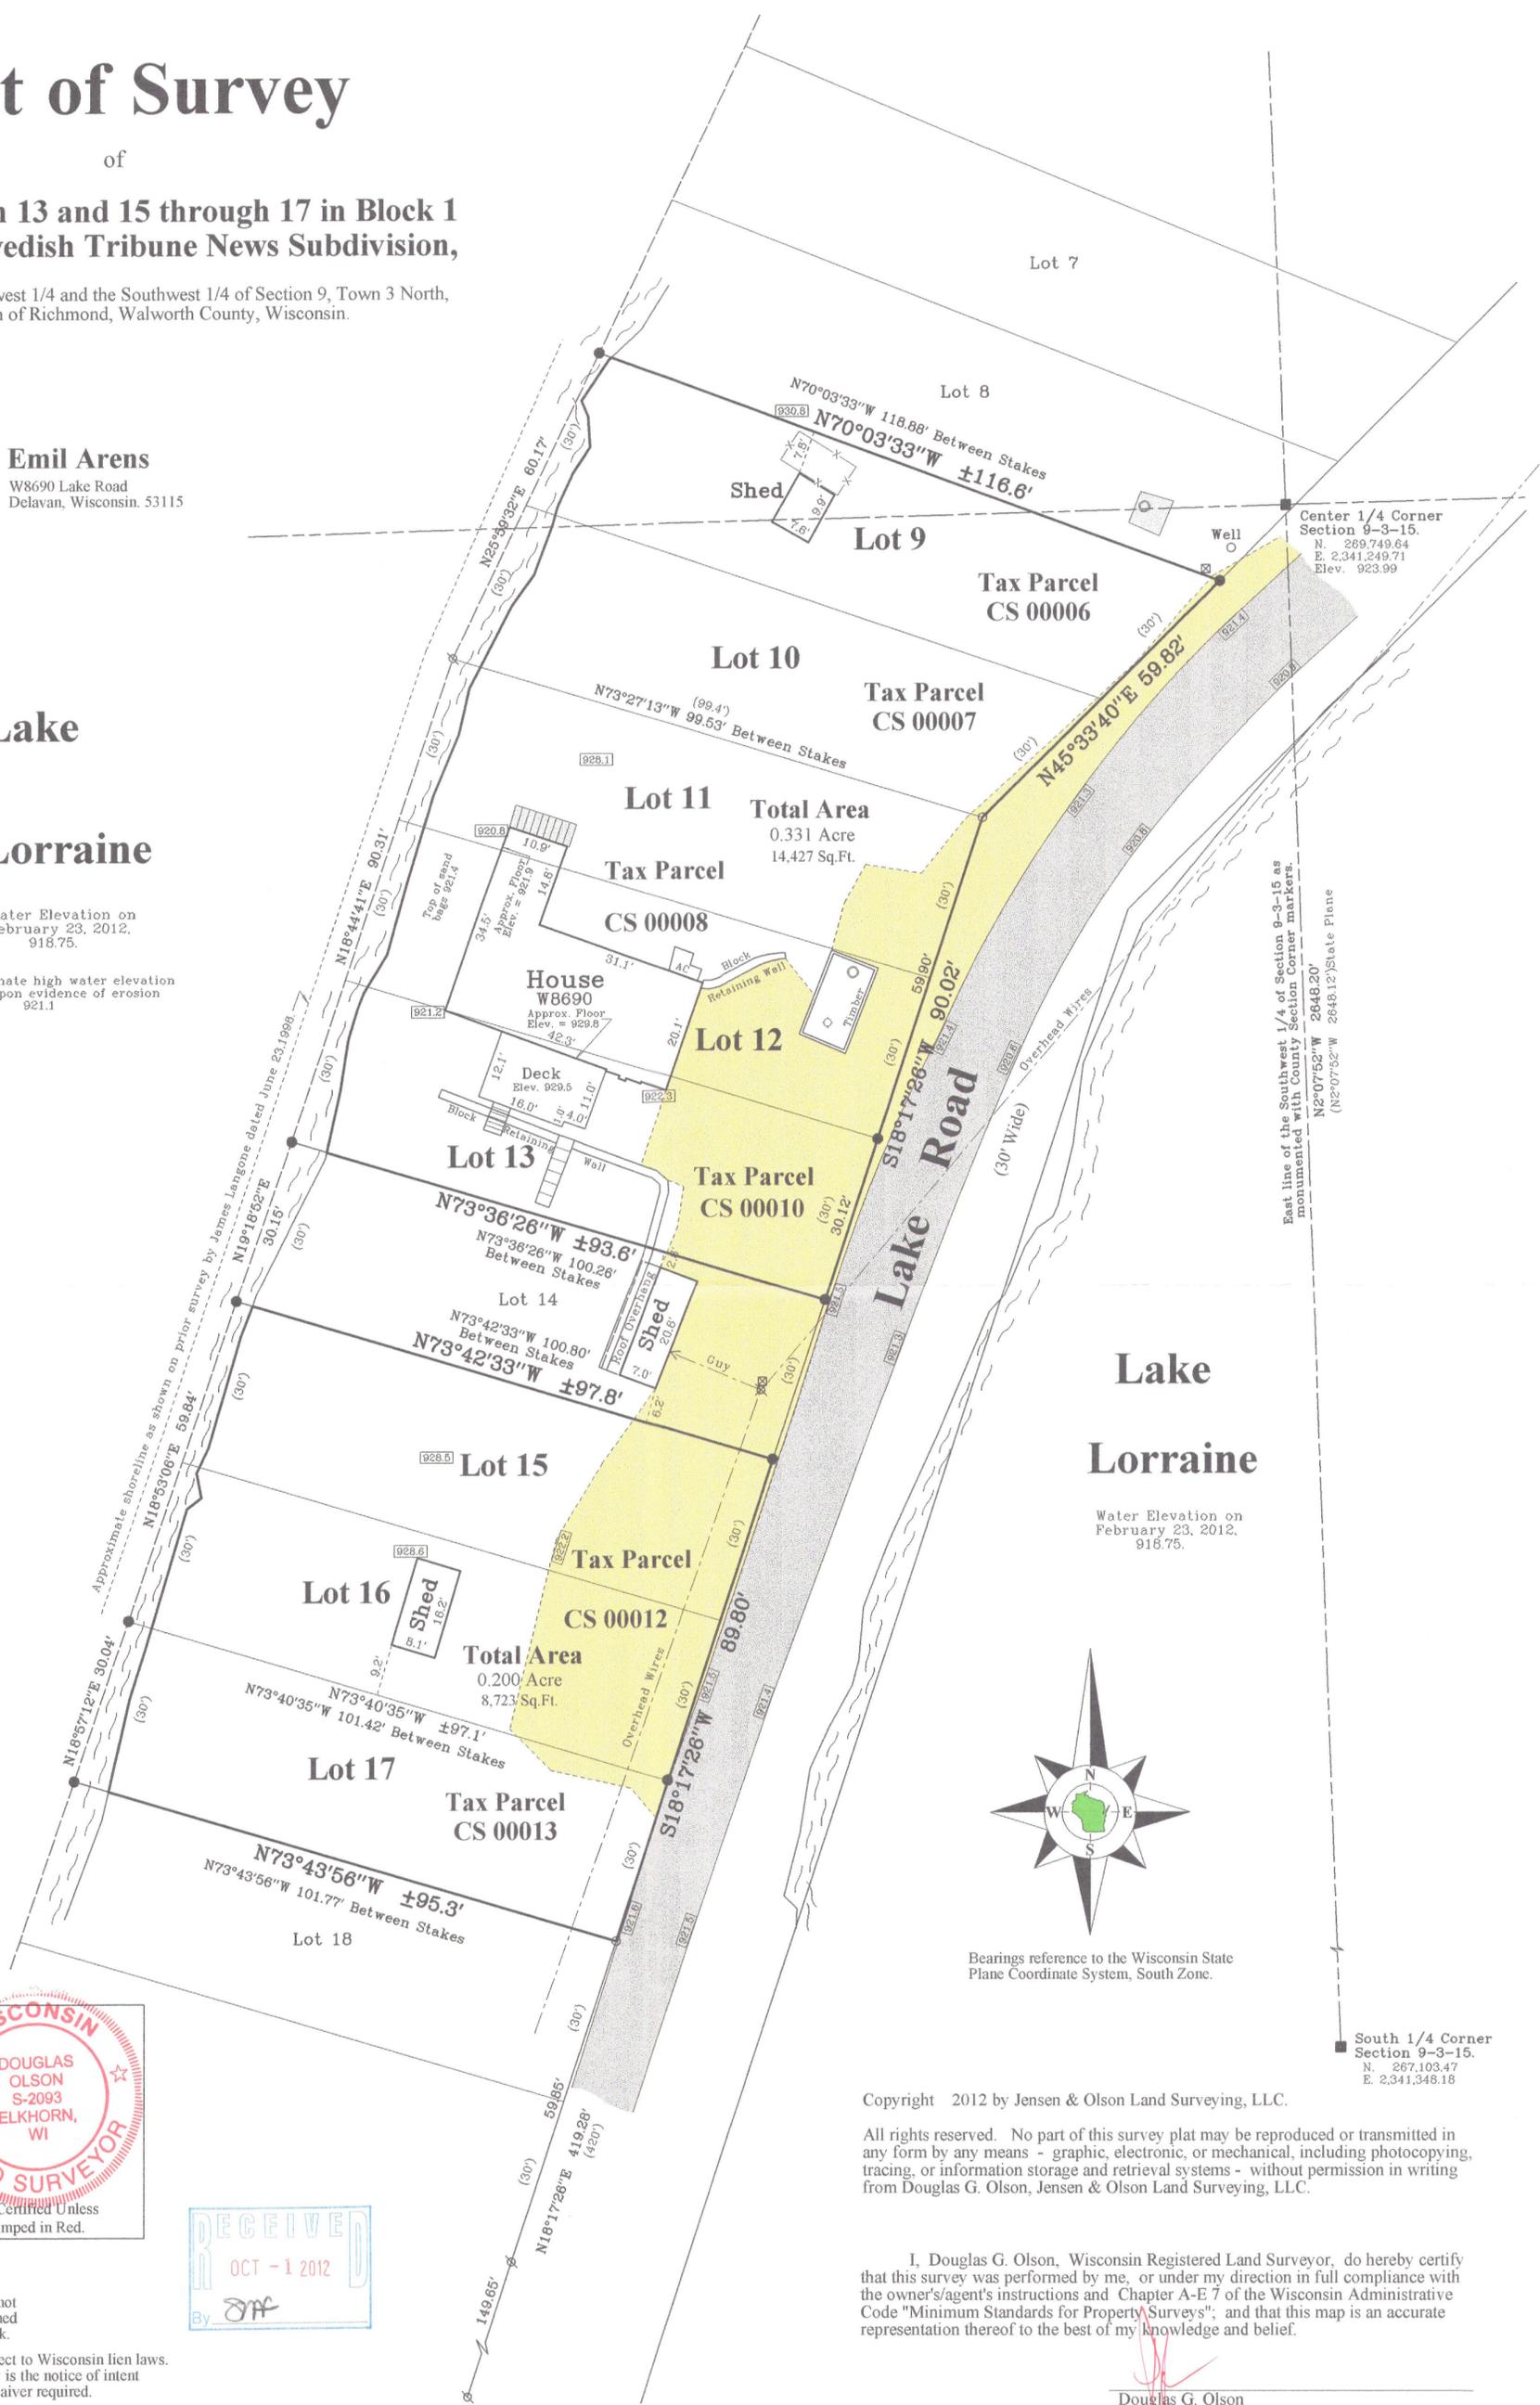

Center 1/4 Corner Section 9-3-15.  
N. 269.749.64  
E. 2,341.249.71  
Elev. 923.99

East line of the Southwest 1/4 of Section 9-3-15, as monumented with County Section Corner markers.  
N2°07'52"W 2648.20'  
(N2°07'52"W 2648.12') State Plane


**Lake**  
**Lorraine**

Water Elevation on February 23, 2012, 916.75.



Bearings reference to the Wisconsin State Plane Coordinate System, South Zone.

South 1/4 Corner Section 9-3-15.  
N. 267,103.47  
E. 2,341,348.18

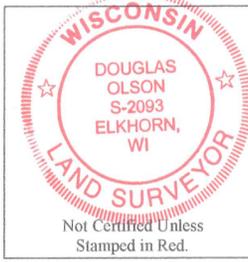

Not Certified Unless Stamped in Red.



**Notes:**

- 1) This survey plat is not certified unless signed and sealed in red ink.
- 2) This survey is subject to Wisconsin lien laws. This Plat of Survey is the notice of intent to file lien. Lien waiver required.

Copyright 2012 by Jensen & Olson Land Surveying, LLC.

All rights reserved. No part of this survey plat may be reproduced or transmitted in any form by any means - graphic, electronic, or mechanical, including photocopying, tracing, or information storage and retrieval systems - without permission in writing from Douglas G. Olson, Jensen & Olson Land Surveying, LLC.

I, Douglas G. Olson, Wisconsin Registered Land Surveyor, do hereby certify that this survey was performed by me, or under my direction in full compliance with the owner's/agent's instructions and Chapter A-E 7 of the Wisconsin Administrative Code "Minimum Standards for Property Surveys", and that this map is an accurate representation thereof to the best of my knowledge and belief.

Douglas G. Olson  
Wisconsin Registered Land Surveyor - 2093

2012.006	Sheet 1 of 1 Sheets	<b>Jensen &amp; Olson Land Surveying, LLC</b> 45 South Wisconsin Street * P.O. Box 322 * Elkhorn, Wisconsin. 53121 Telephone: (262) 723-3434 * Facsimile: (262) 723-8044 Email: jensen.olson@elknet.net	Scale in Feet 1" = 20'	Survey Date: February 23, 2012
	Drawing Name: C:\nr15e-2012006-2012006Plat.sj Job Reference Number <b>2012.006</b>		Legend ● Found County Section Corner ○ Found Iron Pipe ○ Found Iron Rod ○ Set Iron Rod ○ Recorded Information ○ Utility Pole ○ Concrete Cover ○ Utility Pedestal ○ Asphalt Surface ○ Concrete Surface ○ Gravel ○ Gravel	0' 10' 20' 40'

CS-6 CS-8 CS-11 CS-12 CS-13

315-175