

PREPARED FOR:
TYLER MYER
SHORWEST REALTY
AND
DARRELL DAVIS
W8835 HICKORY RD
DELAVAN, WI 53115

PLAT OF SURVEY



-OF-

PATHFINDER SURVEYING INC.
(formerly)
J.K. SURVEYING INC.
P.O BOX 322
LAKE GENEVA, WI 53147
WWW.PATHFINDERSURVEYING.NET
262-248-8303


LOTS 16 THROUGH 19 INCLUSIVE, IN BLOCK 7, IN THE PLAT OF SKANSEN 1ST
ADDITION, BEING LOCATED IN THE SOUTHWEST 1/4 OF SECTION 9, TOWN 3 NORTH,
RANGE 15 EAST, IN THE TOWN OF RICHMOND, COUNTY OF WALWORTH, STATE OF
WISCONSIN.

HICKORY ROAD

(30' WIDE)

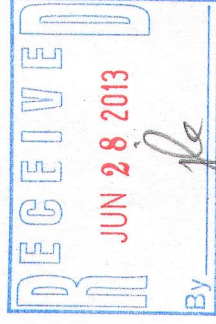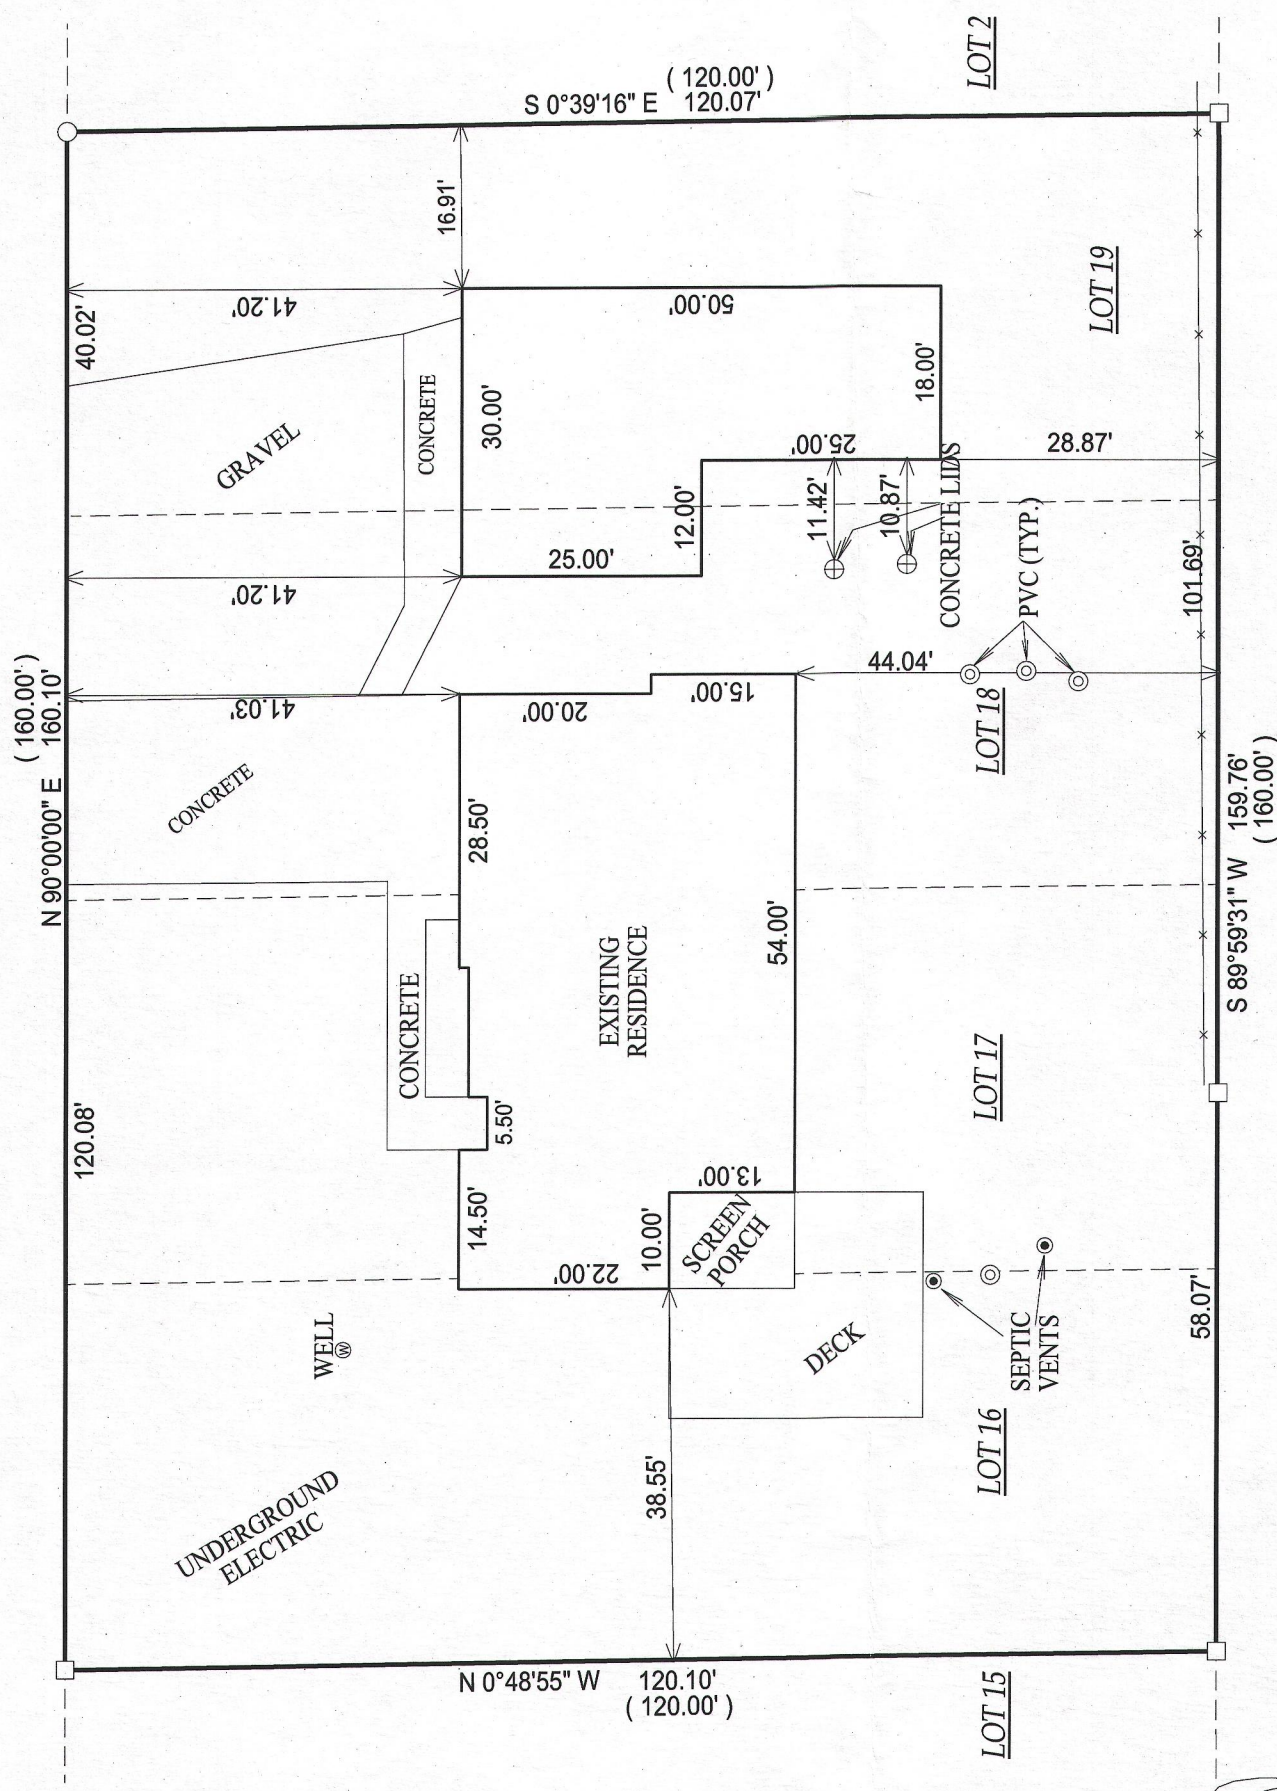

REVISED 5-14-2013 ADDED CHANGES
AND ADDITIONAL STRUCTURE

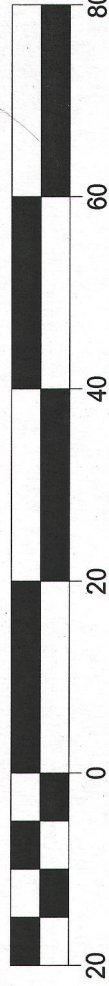

NOTE: BASIS OF BEARING IS LINDEN ROAD ASSUMED EAST-WEST

- () = RECORDED AS
- = FOUND IRON BAR
 - = FOUND IRON PIPE
 - = SET IRON PIPE
 - = SET IRON BAR
- SCALE: 1" = 20'

"I hereby certify that I have surveyed the above described property and that the above map is a true representation of its exterior boundary and shows the size and location of all visible structures, apparent easements and encroachments if any."

This survey is made for the present owners of the property, and those who purchase, mortgage, or guarantee the title thereto, within one year from the date hereof.

JOB #: 06-422AB4

TAX ID #: CSA 00115

JEFFREY L KIMPS S-2436
Wisconsin Registered Land Surveyor
(original if signed in red)

DATED THIS 8th DAY OF SEPTEMBER, 2006.

315-1198