


TURTLE LAKE

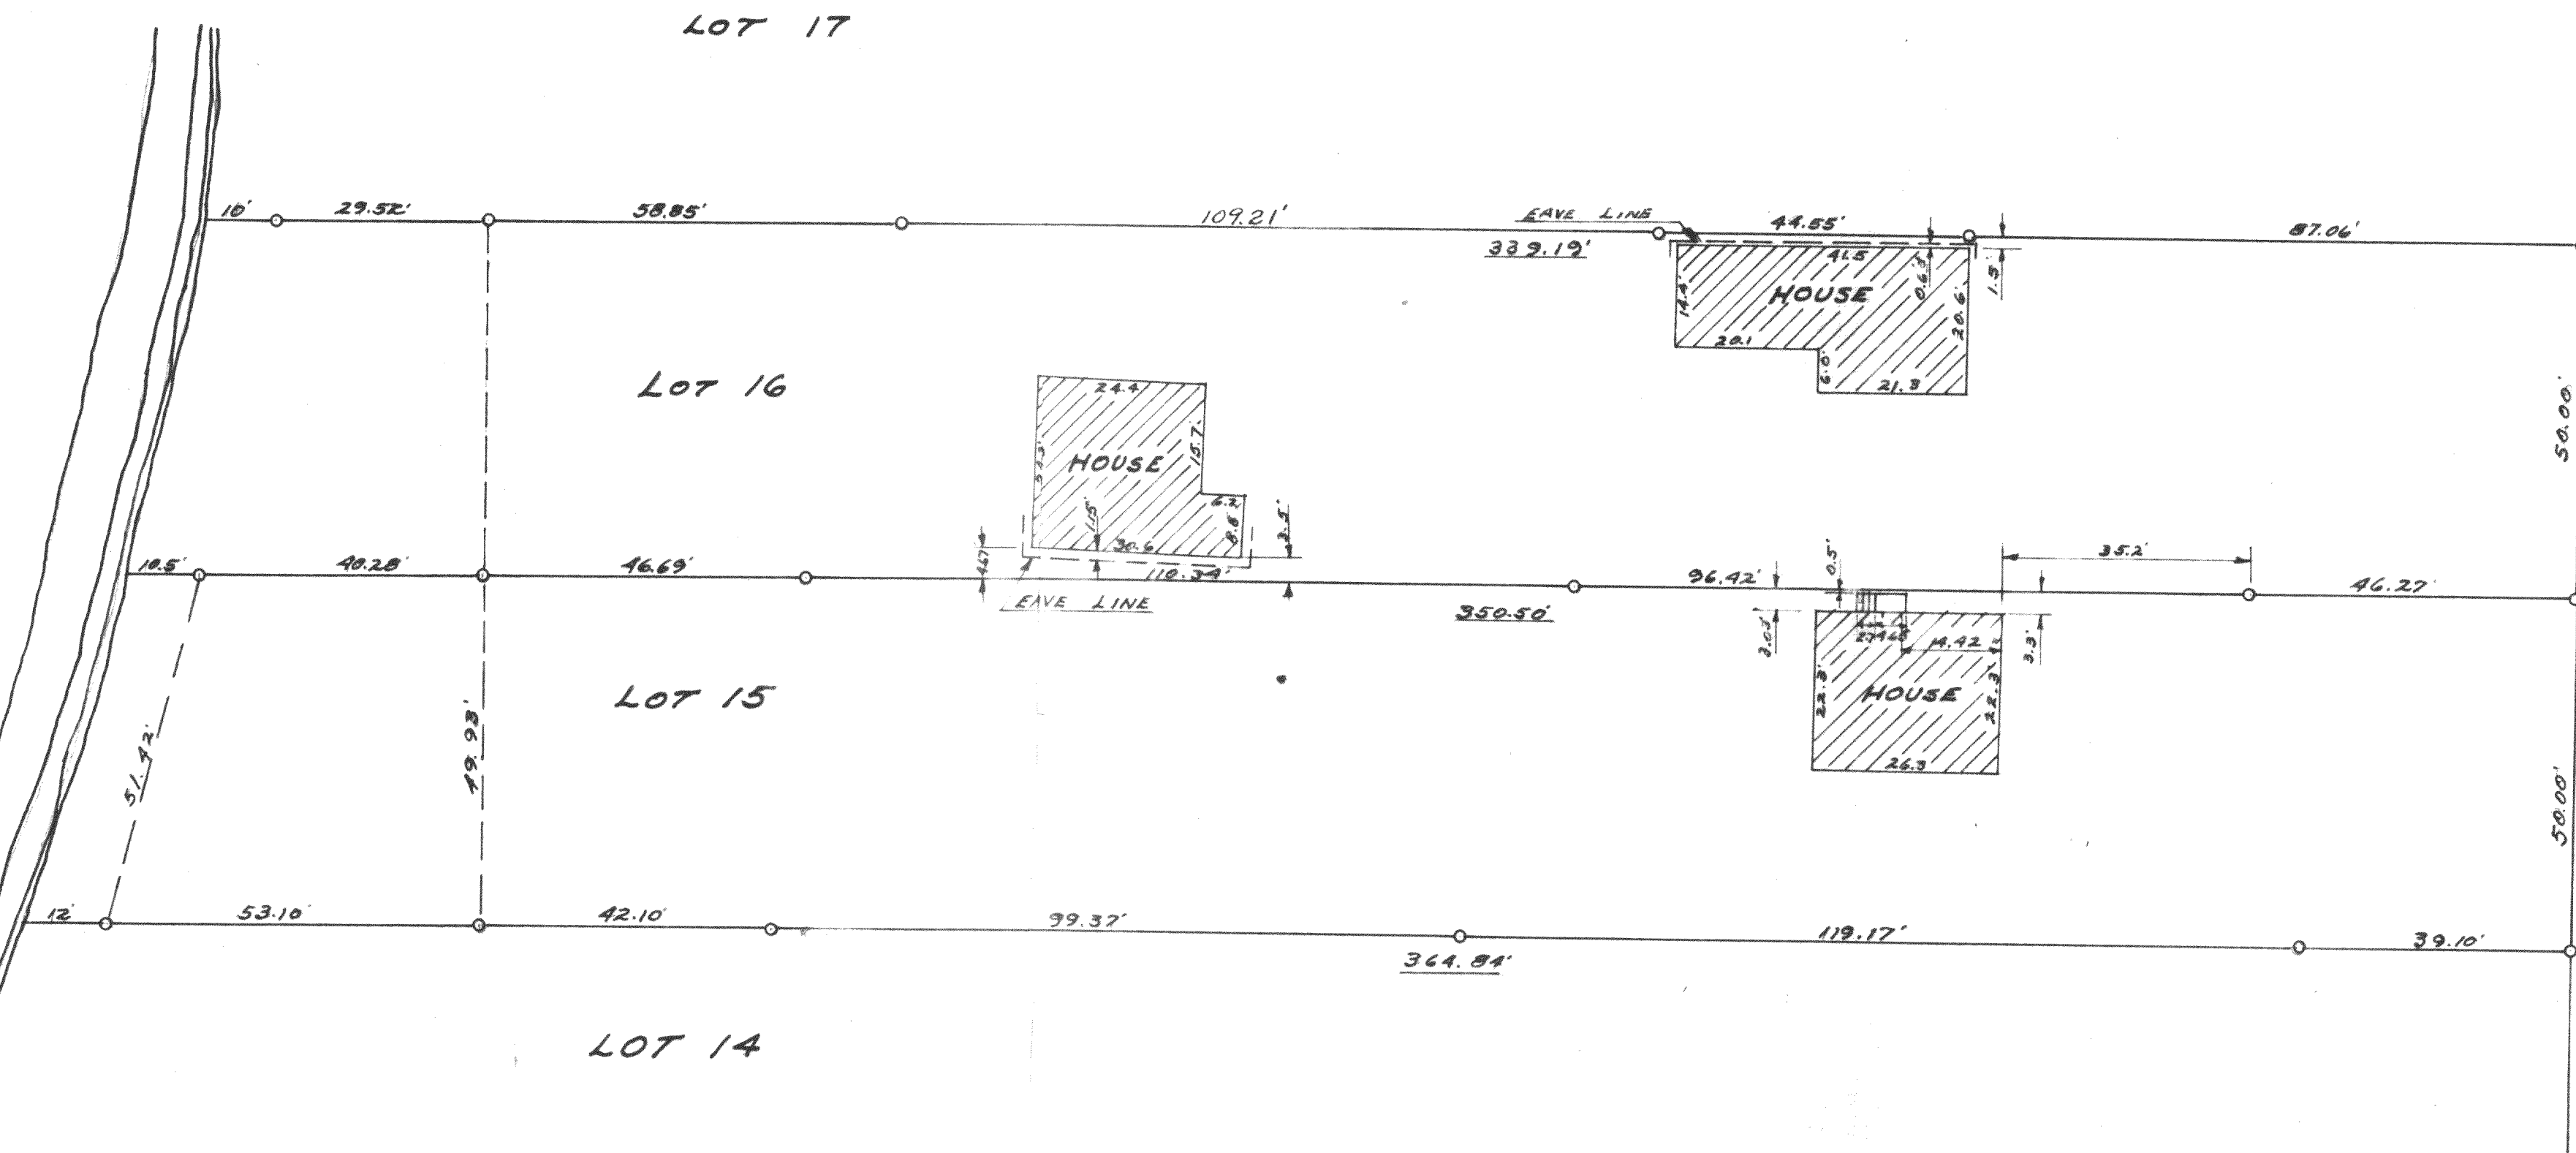

SCALE 1"=20'
O IRON PIPE

N

PLAT OF LOTS 15 AND 16 OF OAK PARK
SUBDIVISION IN SECTION 11 T3N R15E RICHMOND
TOWN TO SHOW THE LOCATION OF RESIDENCES.
JULY 6, 1954

Lloyd L. Jensen
COUNTY SURVEYOR

COP-12
"-13

315-12.1