

PREPARED FOR:  
TYLER MYER  
SHORWEST REALTY  
AND  
DARRELL DAVIS  
W8835 HICKORY RD  
DELAVAN, WI 53115

## PLAT OF SURVEY


-OF-

PATHFINDER SURVEYING INC.  
(formerly)  
J.K. SURVEYING INC.  
P.O BOX 322  
LAKE GENEVA, WI. 53147  
WWW.PATHFINDERSURVEYING.NET  
262-248-8303


LOTS 16 THROUGH 19 INCLUSIVE, IN BLOCK 7, IN THE PLAT OF SKANSEN 1ST  
ADDITION, BEING LOCATED IN THE SOUTHWEST 1/4 OF SECTION 9, TOWN 3 NORTH,  
RANGE 15 EAST, IN THE TOWN OF RICHMOND, COUNTY OF WALWORTH, STATE OF  
WISCONSIN.

## HICKORY ROAD

(30' WIDE)

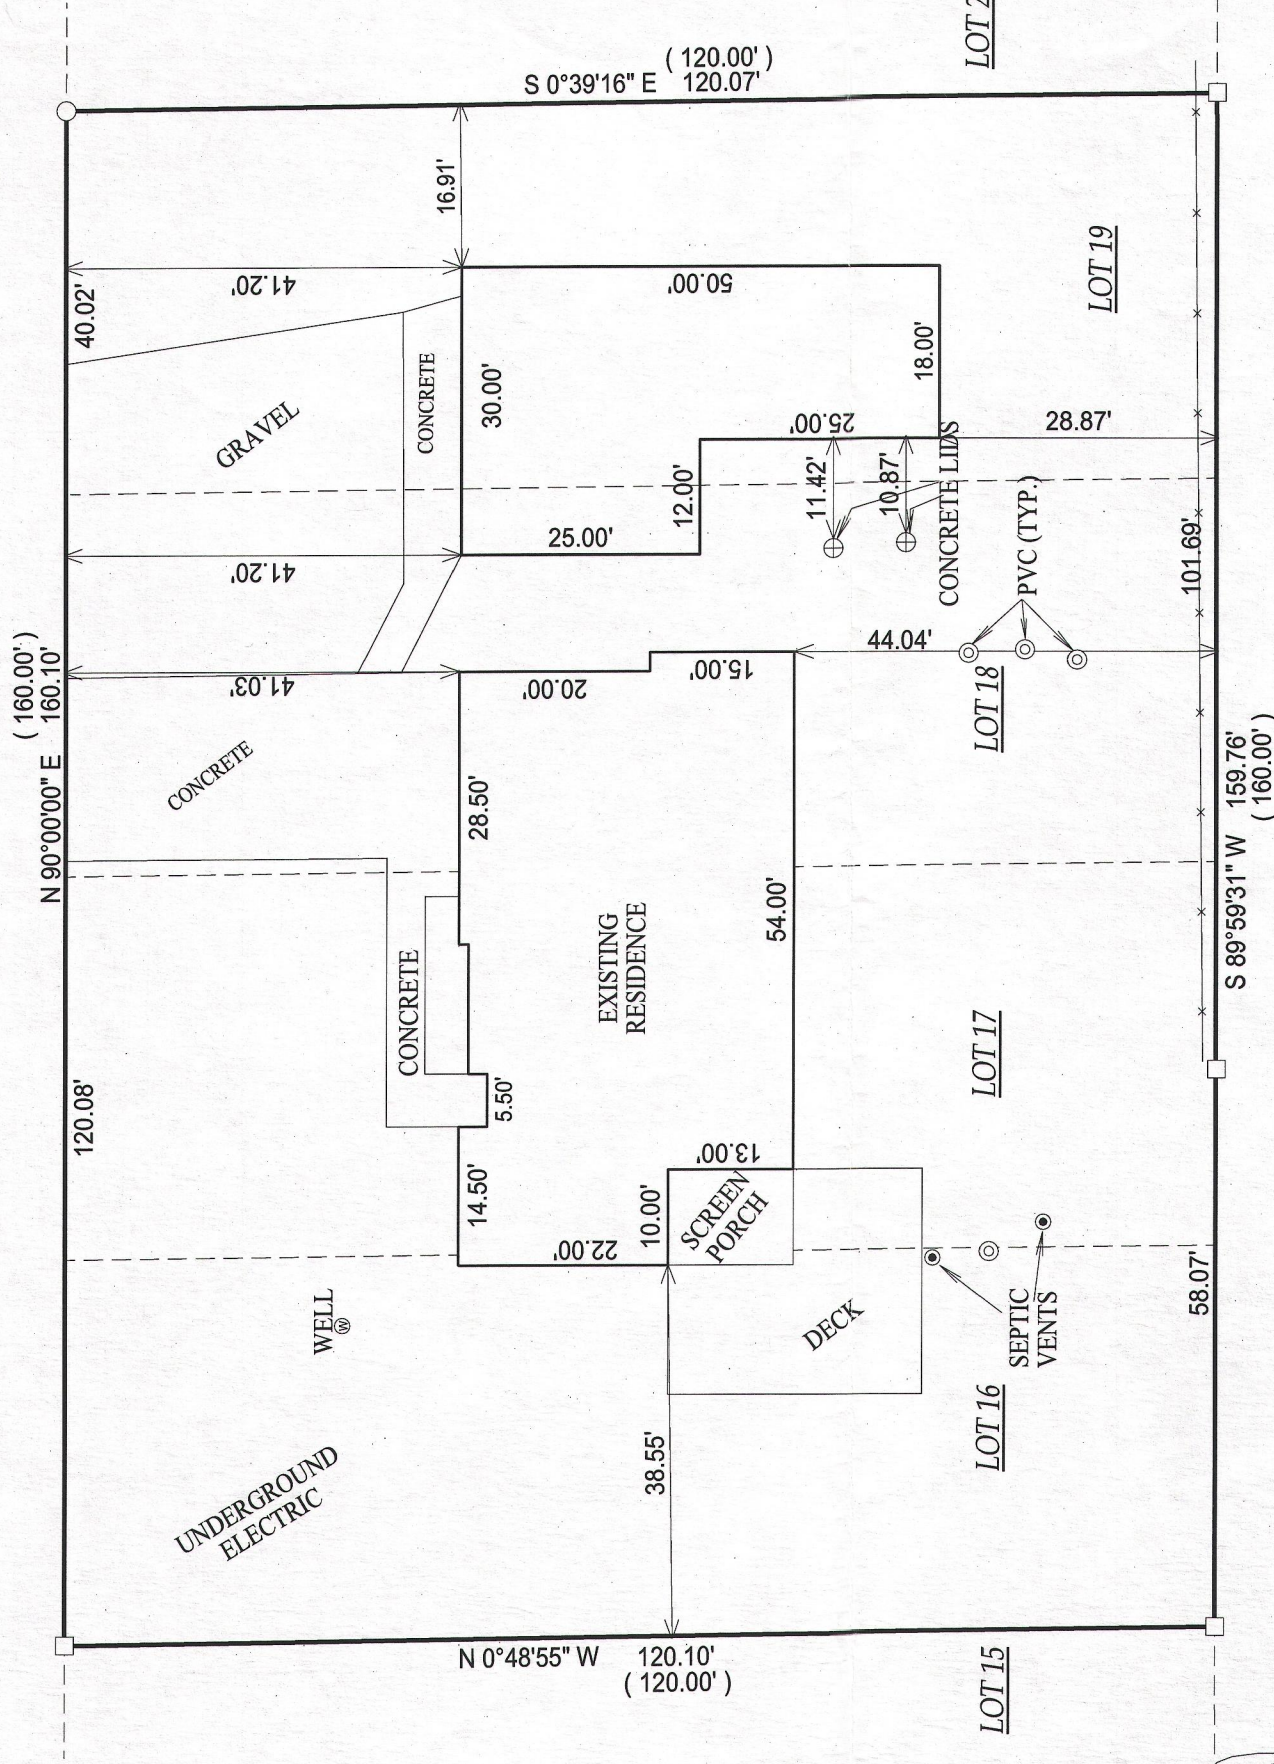

REVISED 5-14-2013 ADDED CHANGES  
AND ADDITIONAL STRUCTURE

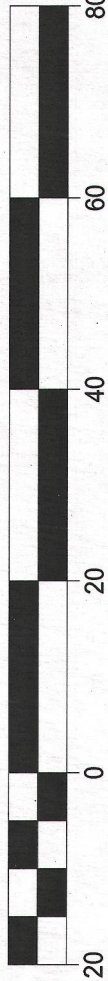

NOTE: BASIS OF BEARING IS LINDEN ROAD ASSUMED EAST-WEST

- ( ) = RECORDED AS
- = FOUND IRON BAR
  - = FOUND IRON PIPE
  - = SET IRON PIPE
  - = SET IRON BAR
- SCALE: 1" = 20'

"I hereby certify that I have surveyed the above described property and that the above map is a true representation of its exterior boundary and shows the size and location of all visible structures, apparent easements and encroachments if any."

This survey is made for the present owners of the property, and those who purchase, mortgage, or guarantee the title thereto, within one year from the date hereof.

JOB #: 06-422AB4

TAX ID #: CSA 00115



JEFFREY L. KIMPS S-2436  
Wisconsin Registered Land Surveyor  
(original if signed in red)

DATED THIS 8th DAY OF SEPTEMBER, 2006.

315-1203