


PREPARED FOR
LYNETTE PHILLIPS
SHOREWEST REALTY
DELAVER, WI.

PLAT OF SURVEY

- OF -

PATHFINDER SURVEYING INC.
(formerly)
J.K. SURVEYING INC.
P.O BOX 322
LAKE GENEVA, WI. 53147
WWW.PATHFINDERSURVEYING.NET
262-248-8303

LOT 9 OAK KNOLLS SUBDIVISION, LOCATED IN THE SW 1/4 OF THE SE 1/4 OF SECTION 34, TOWN 4 NORTH, RANGE 15 EAST, AND THE NW 1/4 OF THE NE 1/4 OF SECTION 3, TOWN 3 NORTH, RANGE 15 EAST, WALWORTH COUNTY, WISCONSIN.

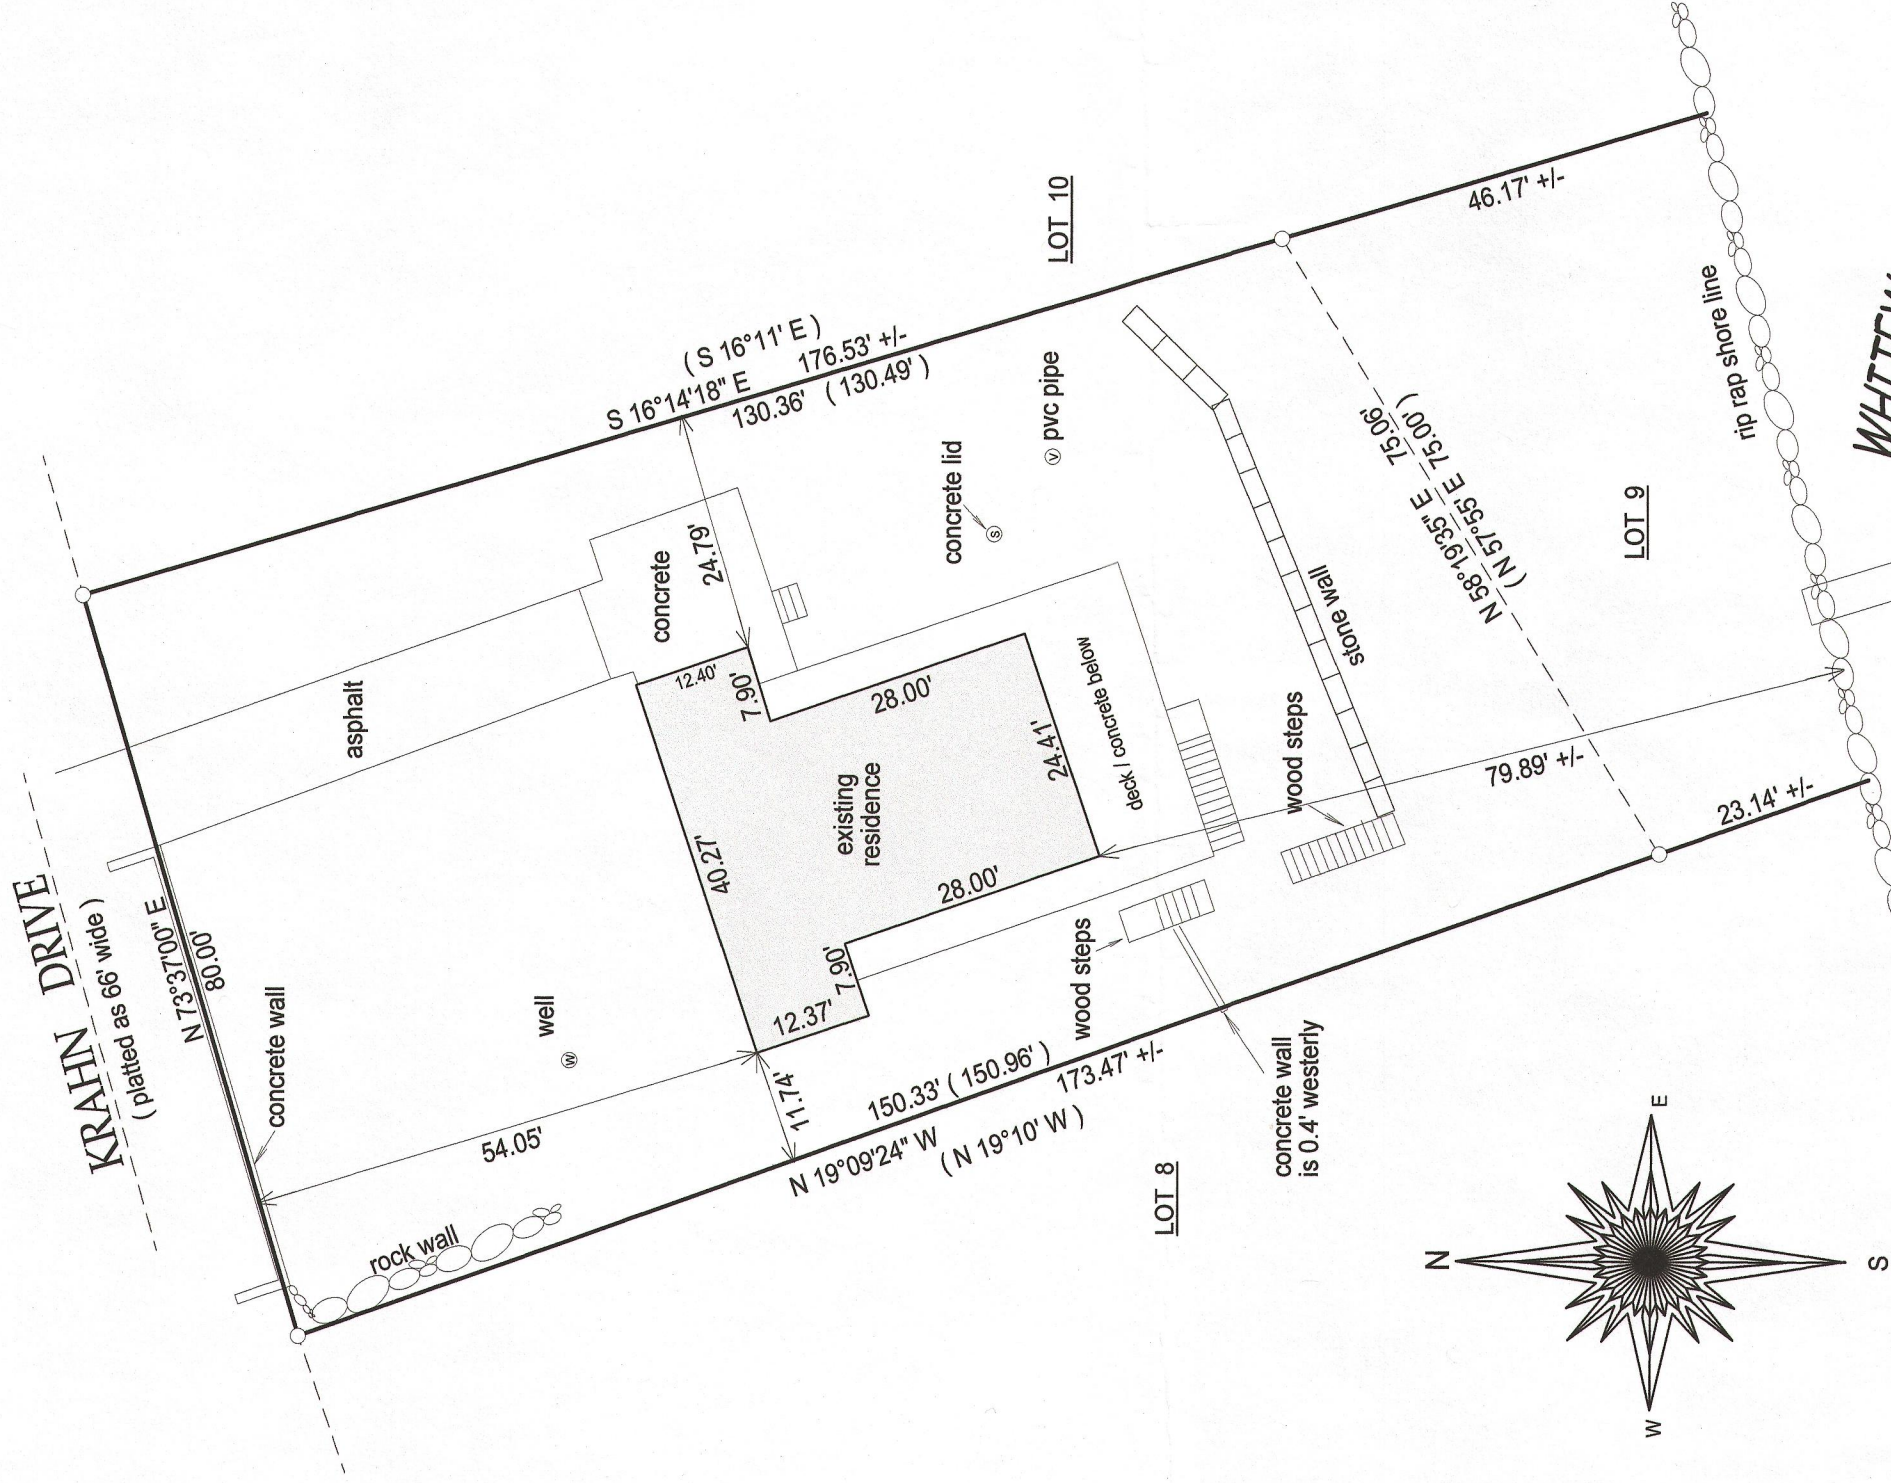

20 0 20 40

BASIS OF BEARING OF THIS PLAT THE SOUTH LINE OF KRAHN DR WAS ASSUMED TO BEAR N73°37' E AS SHOWN ON THE RECORD PLAT OF OAK KNOLLS

- () = recorded as
- = found iron bar
 - = found iron pipe
 - = set iron pipe
 - = set iron bar

SCALE 1" = 20'


JOB # 13-156

TAX ID # COK00009

I hereby certify that I have surveyed the above-described property and the above map is a true representation thereof and shows the size and location of the property, its exterior boundaries, the location and dimensions of all structures thereon, fences, apparent easements and roadways and visible encroachments if any.

This survey is made for the present owners of the property, and those who purchase, mortgage, or guarantee the title thereto, within one year from the date hereof.

DATED THIS 3RD DAY OF SEPTEMBER, 2013.

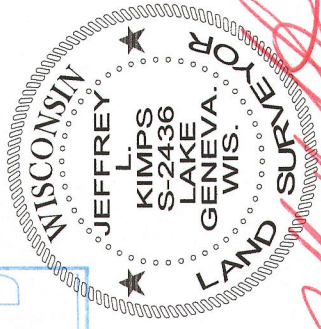

JEFFREY L. KIMPS S - 2436
Wisconsin Registered Land Surveyor
(original if signed in red)

315-1204