


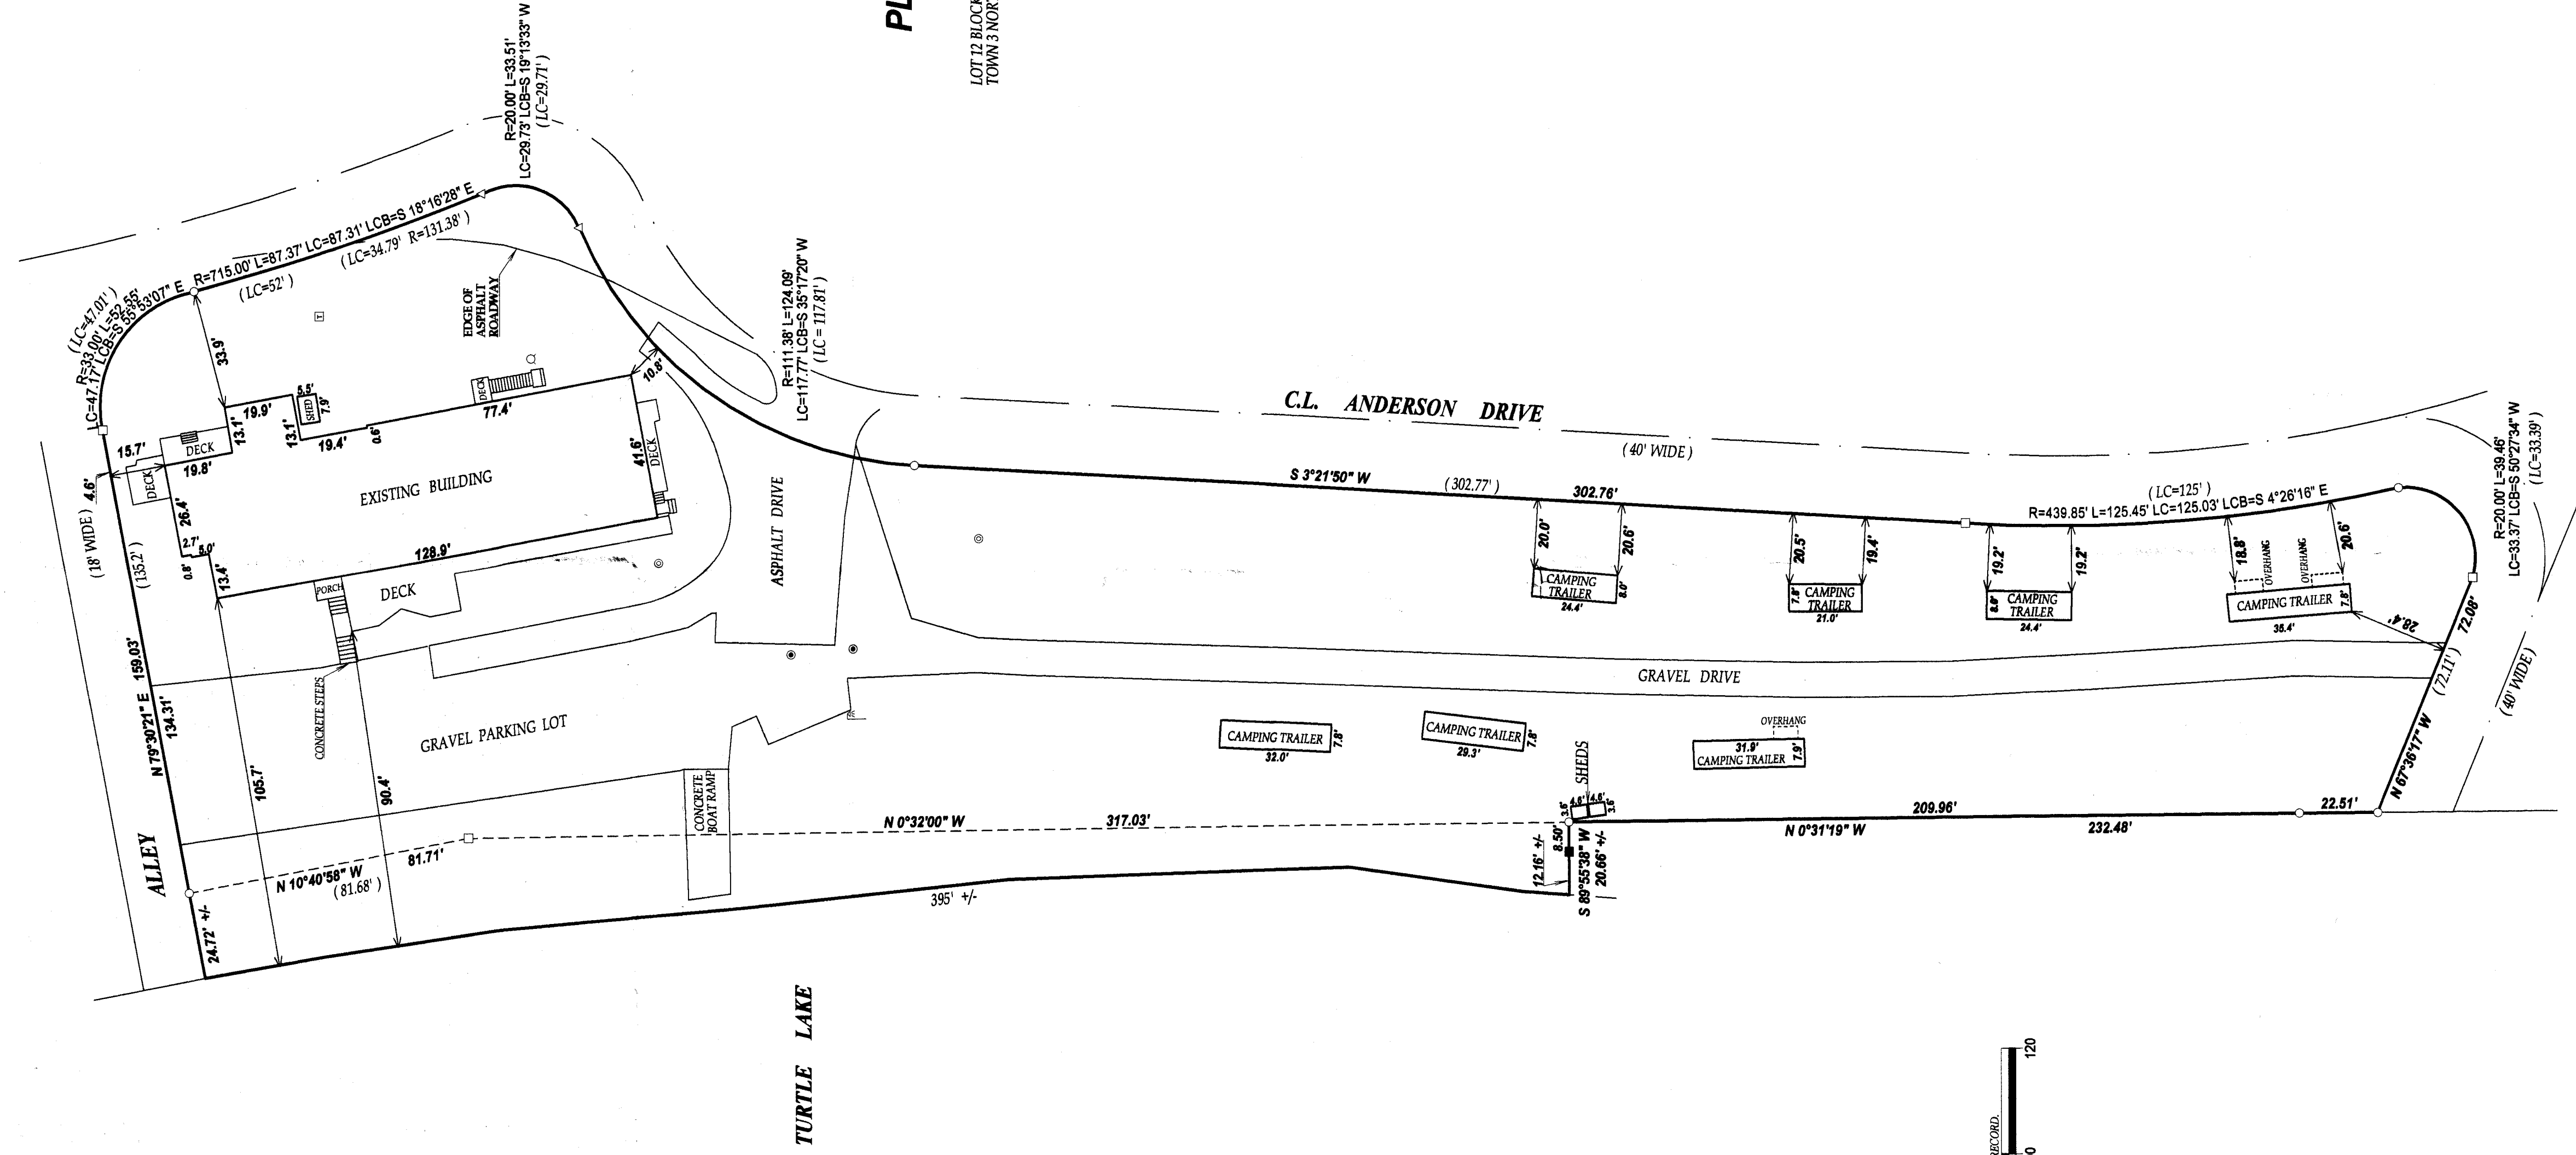

PLAT OF SURVEY

-OF-
LOT 12 BLOCK "C" OF CRYSTAL BOWL SUBDIVISION LOCATED IN
TOWN 3 NORTH, RANGE 15 EAST, WALWORTH COUNTY, WISCONSIN.


LEGEND

- FOUND IRON PIPE
- FOUND IRON BAR
- △ FOUND 60 PENNY SPIKE
- SET IRON BAR
- WELL
- CONCRETE LID
- METAL LID
- ⊥ LIGHT POLE
- ⊞ ELECTRICAL TRANSFORMER

RECORDED AS

JOB # 10-177UD2013

TAX ID # CCR00069

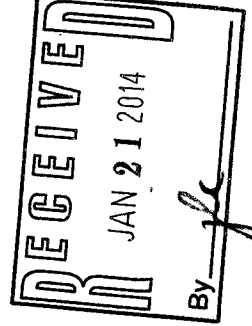

DATED THIS 8th DAY OF NOVEMBER 2010.
DATE OF LAST REVISION 12/18/2013
REVISED 11/20/2012

JOHN P. KROTT S-2558
WISCONSIN REGISTERED LAND SURVEYOR
(NOTE: THIS IS NOT A CERTIFIED COPY
UNLESS SIGNED IN RED INK)

I have surveyed the above-described property and the above map is a true representation thereof and shows the size and location of the property, its exterior boundaries, the location and dimensions of all structures thereon, fences, apparent easements and roadways and visible encroachments, if any.

This survey is made for the exclusive use of the present owners of the property and also for use and purchase, mortgage or lease of the property within one (1) year from date hereof, and as to them I warrant the accuracy of said survey map.