

PREPARED FOR
JULIE HANSEN


PLAT OF SURVEY

- OF -

PATHFINDER SURVEYING INC.
(formerly)
J.K. SURVEYING INC.
P.O. BOX 322
LAKE GENEVA, WI. 53147
WWW.PATHFINDERSURVEYING.NET
262-248-8303

LOT 13, BLOCK 3 CHAPEL HILLS SUBDIVISION, LOCATED IN THE SE 1/4 OF THE SE 1/4 OF SECTION 34, TOWN 4 NORTH, RANGE 15 EAST, AND THE NE 1/4 OF THE NE 1/4 AND IN THE EAST 1/2 OF THE SE 1/4 OF THE NE 1/4 OF SECTION 3, TOWN 3 NORTH, RANGE 15 EAST, WALWORTH COUNTY, WISCONSIN.

S 89°57'00" E

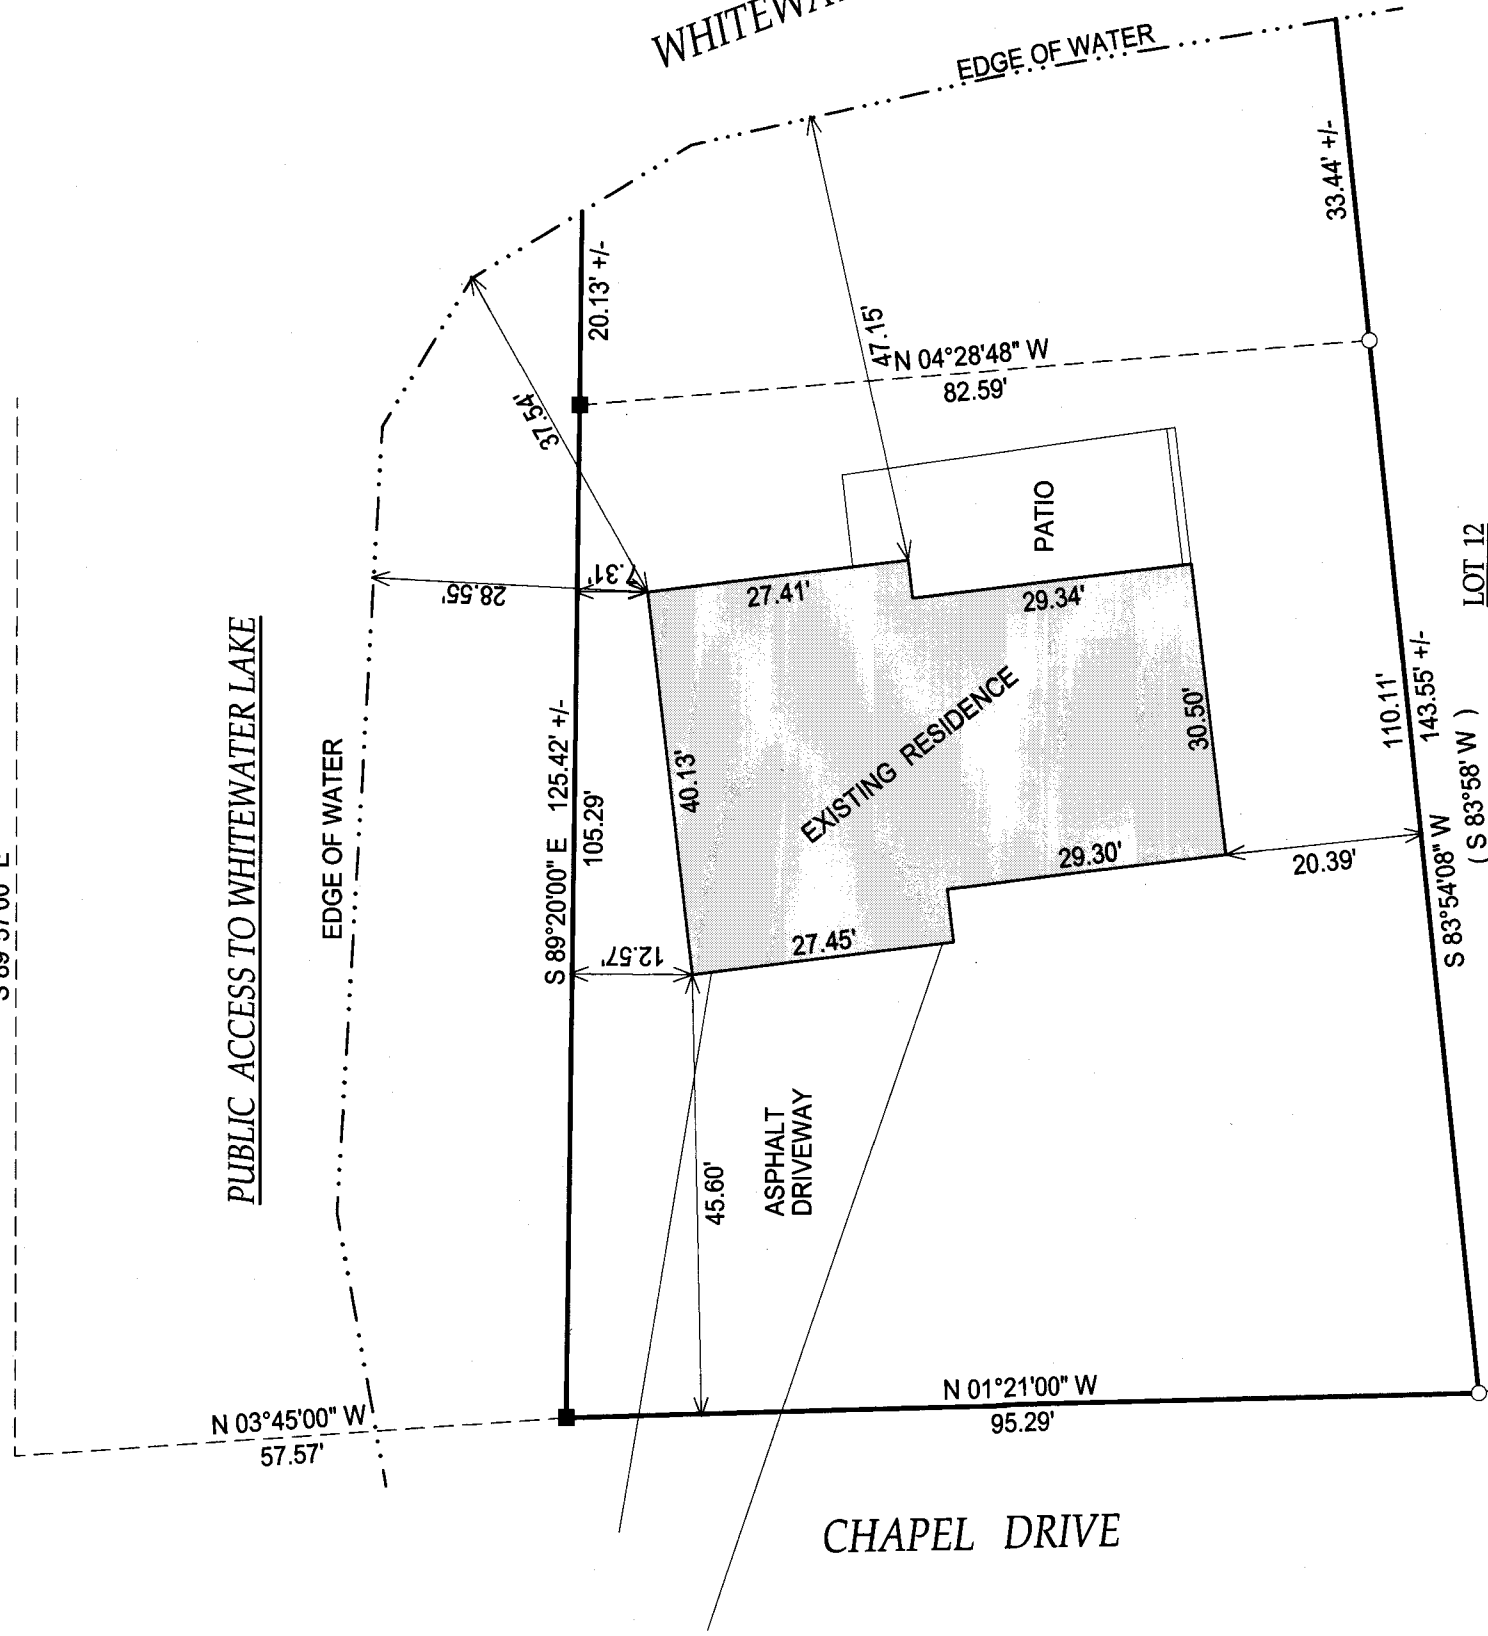


- () = recorded as
- = found iron bar
- = found iron pipe
- = set iron pipe
- = set iron bar

SCALE 1" = 20'

JOB # 14-02

TAX ID #
CCH 00009B

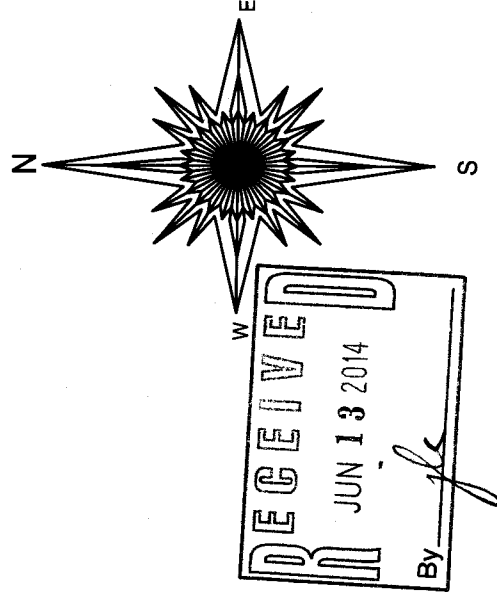

BASIS OF BEARING OF THIS PLAT: THE EAST LINE OF CHAPEL DRIVE WAS ASSUMED TO BEAR N01°21'00" W AS SHOWN ON THE RECD PLAT OF CHAPEL HILLS

I hereby certify that I have surveyed the above-described property and the above map is a true representation thereof and shows the size and location of the property, its exterior boundaries, the location and dimensions of all structures thereon, fences, appurtenant easements and roadways and visible encroachments if any.

This survey is made for the present owners of the property, and those who purchase, mortgage, or guarantee the title thereto, within one year from the date hereof.

DATED THIS 2ND DAY OF JANUARY, 2014.

NOTE: DUE TO HEAVY SNOW COVER ALL IMPROVEMENTS MAY NOT BE SHOWN.



JEFFREY L. KIMPS S - 2436
Wisconsin Registered Land Surveyor
(original if signed in red)

CCH - 9B 315-1214