



PLAT OF SURVEY of Lots 3, 4, 5 and 6 in Block 24 of Skansen Swedish Tribune - News Subdivision, located in the SW 1/4 of Section 9, T3N, R15E, Town of Richmond, Walworth County, Wisconsin.

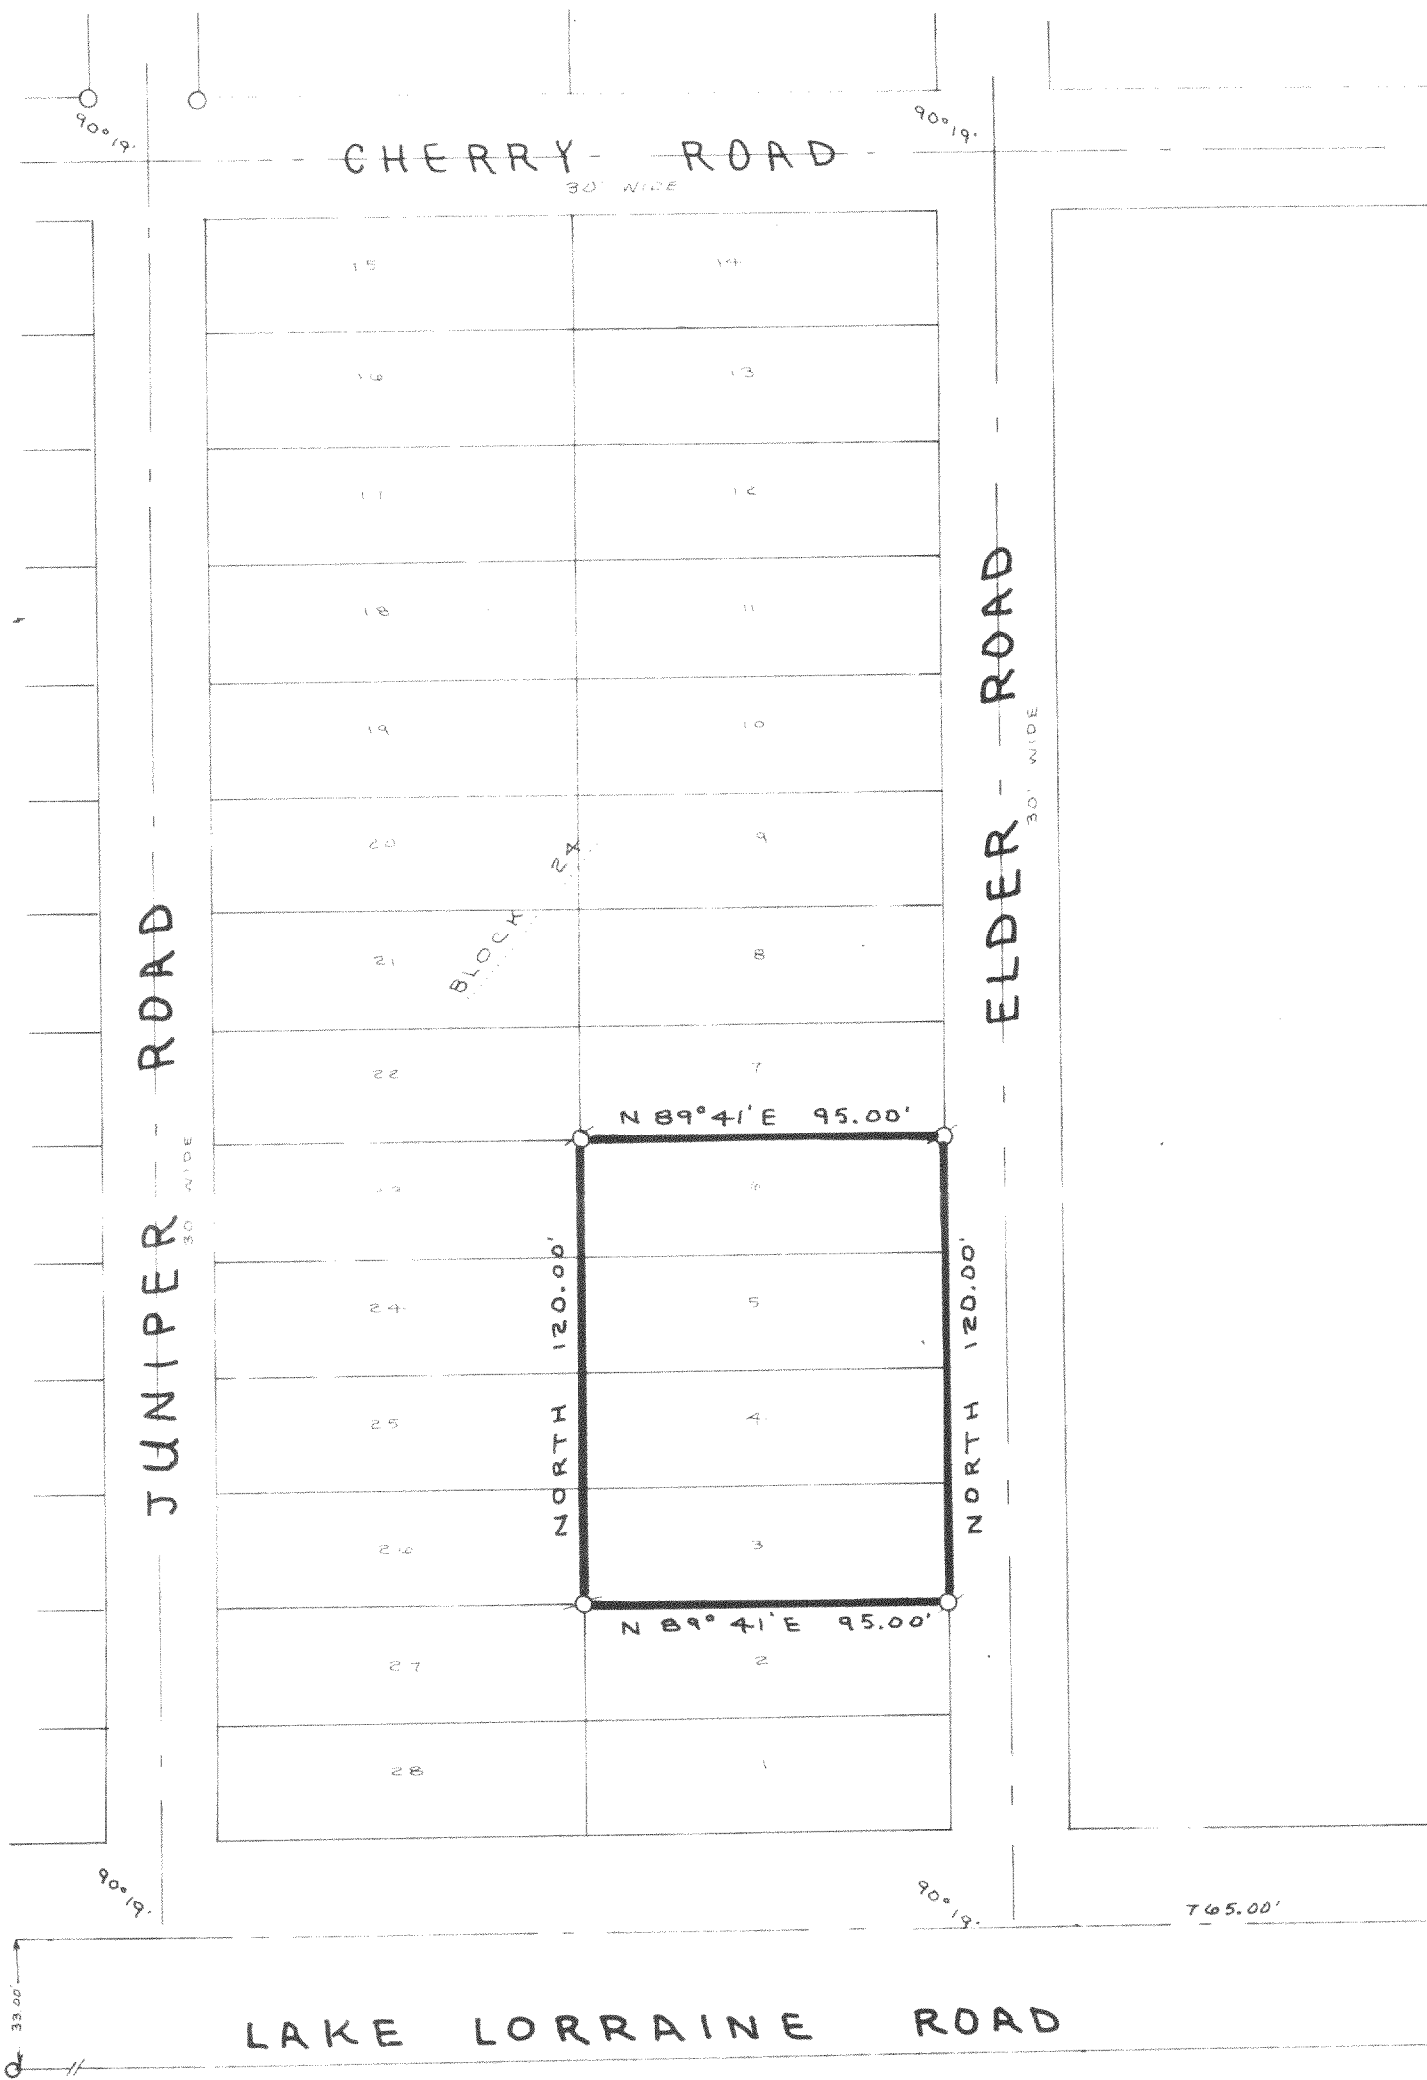

NOTE:
Westerly line of Elder Road assumed
to Bear North

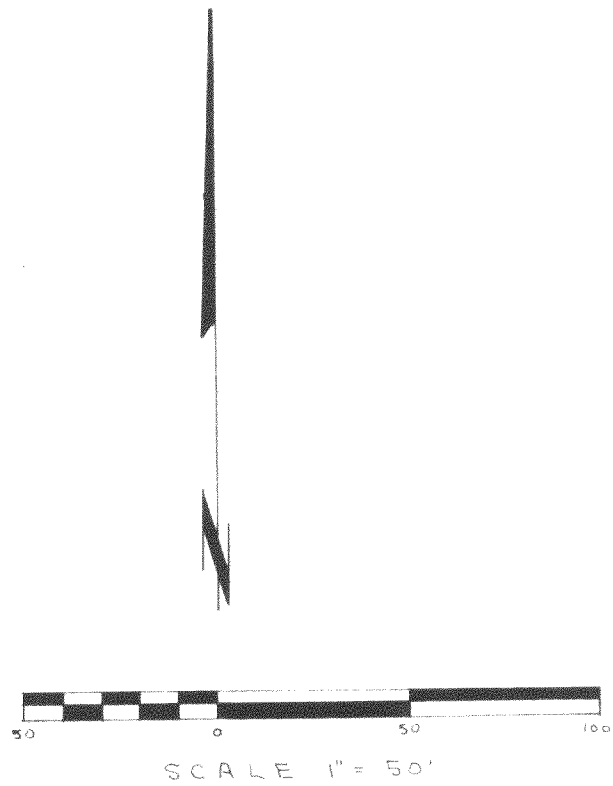

- Indicates 1" iron pipe found
- ⊖ Indicates 1" x 24" iron pipe set

WORK ORDERED BY: Wenzel Dvornik

I hereby certify that the property described hereon has been surveyed under my direction and that this Plat of Survey is a correct representation of the lot lines to the best of my knowledge and belief.

Robert A. Farris
Robert A. Farris
Surveyor No. S-1293

Dated this 10th day of August, 1978

FARRIS, HANSEN & COOPER, INC.
ENGINEERING, SURVEYING & LAND PLANNING

715 W. WALWORTH ST. - P.O. BOX 487 ELKHORN, WI 53121
PHONE 414 - 723 - 2098

CS-354, 355

1374
DRAWING NO. ~~1366~~
315-122