

# FARRIS, HANSEN & ASSOCIATES, INC.

ENGINEERING — ARCHITECTURE — SURVEYING  
7 RIDGWAY COURT — P.O. BOX 437 — ELKHORN, WISCONSIN 53121  
PHONE: (262) 723-2098 FAX: (262) 723-5886

## PLAT OF SURVEY

LOT 12 OF OAK PARK OF TURTLE LAKE  
LOCATED IN THE SE 1/4 OF THE SE 1/4 SEC. 11  
TOWN 3 NORTH, RANGE 15 EAST  
WALWORTH COUNTY, WI.

— WORK ORDERED BY —  
RITA DOHERTY  
478 GREYSTONE LANE  
PROSPECT HEIGHTS, IL. 60070

### LEGEND

○ = FOUND IRON PIPE STAKE  
(XXX) = RECORDED AS



NOTE: COPIES OF THIS MAP TO WHICH THE FOLLOWING CERTIFICATE  
WILL APPLY SHOW THE SURVEYOR'S ORIGINAL SEAL AND SIGNATURE  
IN RED INK. COPIES BY ANY OTHER MEANS MAY HAVE ALTERATIONS  
WHICH DO NOT REPRESENT THE SURVEYOR'S WORK PRODUCT.

I HEREBY CERTIFY THAT THE ABOVE DESCRIBED PROPERTY HAS BEEN  
SURVEYED UNDER MY DIRECTION AND THAT THE ABOVE MAP IS A TRUE  
REPRESENTATION THEREOF AND SHOWS THE SIZE AND LOCATION OF  
THE PROPERTY AND ITS EXTERIOR BOUNDARIES. THIS SURVEY IS  
MADE FOR THE USE OF THE PRESENT OWNERS OF THE PROPERTY, AND  
ALSO THOSE WHO PURCHASE, MORTGAGE, OR GUARANTEE THE TITLE  
THERETO WITHIN ONE YEAR FROM THE DATE HEREOF.

DATED: OCTOBER 17, 2013


*Peter S. Gordon*  
PETER S. GORDON R.L.S. 2101

REVISED 11-7-2016  
TO SHOW SIDE SETBACK TO FOUNDATION

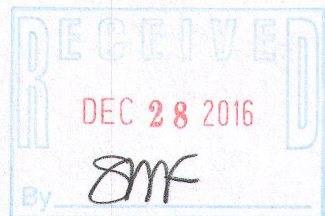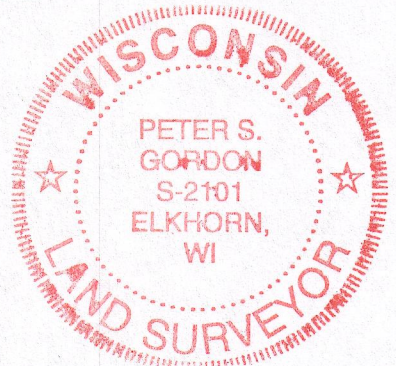

PROJECT: 8898  
DATE: 10-17-2013  
SHEET 1 OF 1

WISCONSIN PARKWAY

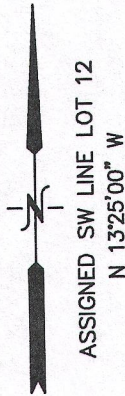

LOT 12

19,625 S.F.  
0.45 AC.

EL. BOX

SEPTIC  
VENT

PORCH

EXISTING  
RESIDENCE

DECK

TURTLE LAKE

MAP SCALE IN FEET ORIGINAL 1" = 30'