




APR 11 2017

4/11/2017 X:\Projects\8203\Dead\Survey\2017


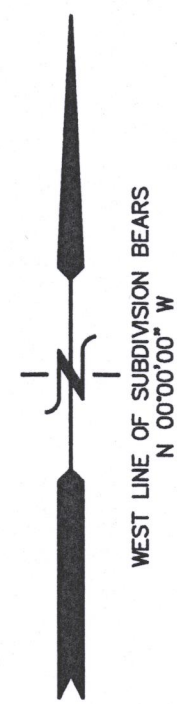


PLAT OF SURVEY

LOTS 1, 2, 3 & 4 OF BLOCK 10, THE NORTH 65' OF LOTS 33, 34 & 35 OF BLOCK 15 & UNIMPROVED PORTION OF SPRUCE ROAD OF SKANSSENS SWEDISH TRIBUNE NEWS SUBDIVISION LOCATED IN PART OF THE SE 1/4 OF THE SW 1/4 OF SECTION 9, TOWN 3 NORTH, RANGE 15 EAST, WALWORTH COUNTY, WISCONSIN

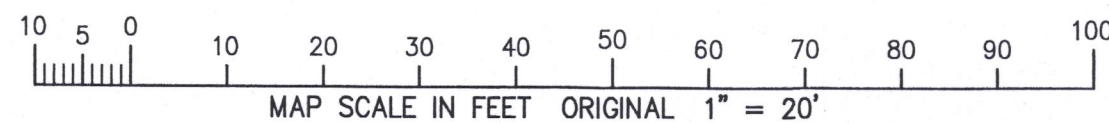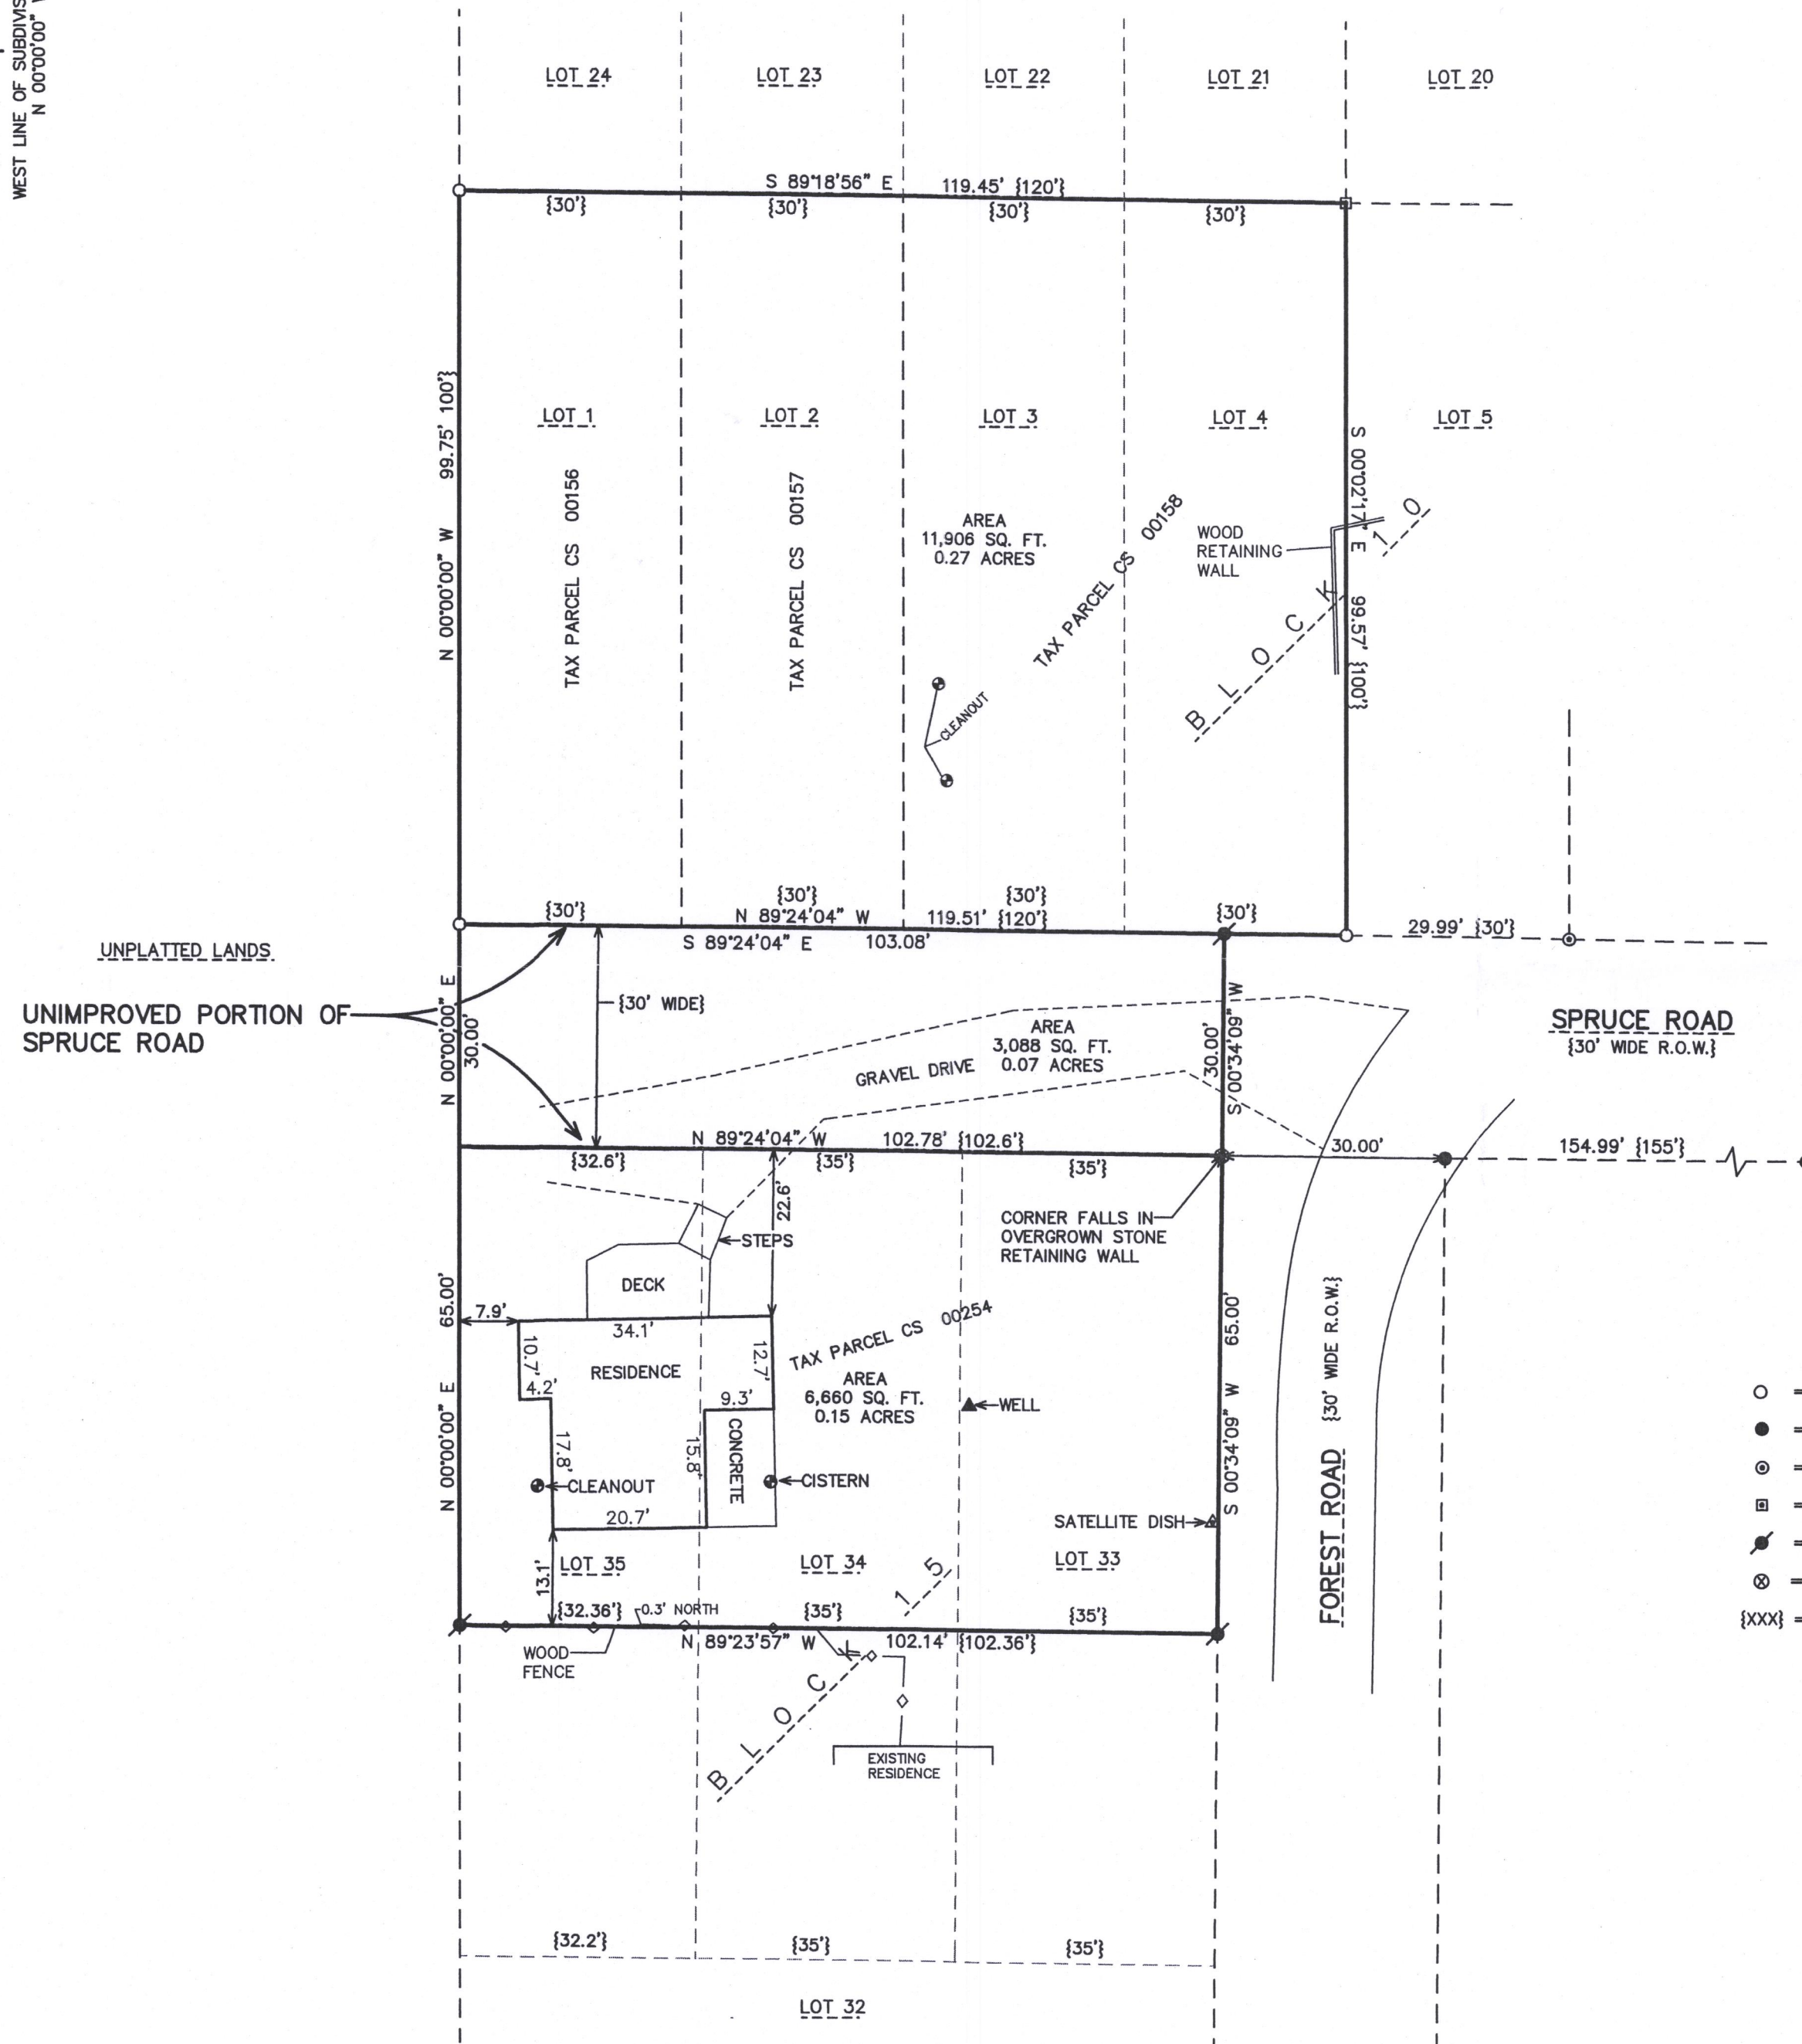

- LEGEND
- = IRON PIPE STAKE FOUND
 - = IRON REBAR STAKE FOUND
 - ⊙ = "PK" NAIL FOUND
 - ⊞ = "PK" NAIL FOUND IN RAILROAD TIE
 - ⦿ = IRON REBAR STAKE SET
 - ⊗ = SET CHIZ X IN BASE STONE RET. WALL
 - {XXX} = RECORDED AS

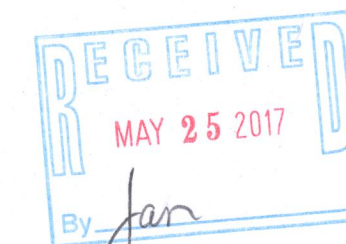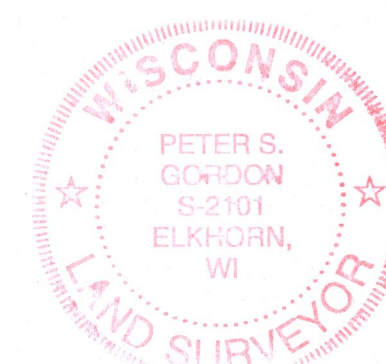

NOTE: COPIES OF THIS MAP TO WHICH THE FOLLOWING CERTIFICATE WILL APPLY SHOW THE SURVEYOR'S ORIGINAL SEAL AND SIGNATURE IN RED INK. COPIES BY ANY OTHER MEANS MAY HAVE ALTERATIONS WHICH DO NOT REPRESENT THE SURVEYOR'S WORK PRODUCT.

I HEREBY CERTIFY THAT THE ABOVE DESCRIBED PROPERTY HAS BEEN SURVEYED UNDER MY DIRECTION AND THAT THE ABOVE MAP IS A TRUE REPRESENTATION THEREOF AND SHOWS THE SIZE AND LOCATION OF THE PROPERTY AND ITS EXTERIOR BOUNDARIES. THIS SURVEY IS MADE FOR THE USE OF THE PRESENT OWNERS OF THE PROPERTY, AND ALSO THOSE WHO PURCHASE, MORTGAGE, OR GUARANTEE THE TITLE THERETO WITHIN ONE YEAR FROM THE DATE HEREOF.

REVISOR 8/23/2010-KB
REVISED CISTERN NOTE
RESURVEYED 04-11-2017

DATE: AUGUST 6, 2010

PETER S. GORDON R.L.S. 2101



WORK ORDERED BY -
DENNIS PHILLIPPI
N6583 FOREST ROAD
DELAVER, WI 53115

FARRIS, HANSEN & ASSOCIATES, INC.
ENGINEERING - ARCHITECTURE - SURVEYING
7 RIDGWAY COURT P.O. BOX 437
ELKHORN, WISCONSIN 53121
OFFICE: (262) 723-2098 FAX: (262) 723-5886

REVISIONS

PROJECT NO.
8203
DATE:
8/6/2010
SHEET NO.
1 OF 1

C8-158

C8-254

315-1299