


PLAT OF SURVEY

LOT 14, OF OAK KNOLL SUBDIVISION, located in the Southwest  $\frac{1}{4}$  of the Southeast  $\frac{1}{4}$  of 34, Town 4 North, Range 15 East, Town of Whitewater and the Northwest  $\frac{1}{4}$  of the Northeast  $\frac{1}{4}$  of Section 3, Town 3 North, Range 15 East, Town of Richmond, all in Walworth County, Wisconsin.

Surveyed for: Chicago Title/Ryan Rouse

Survey Address: N7276 Krahn Drive

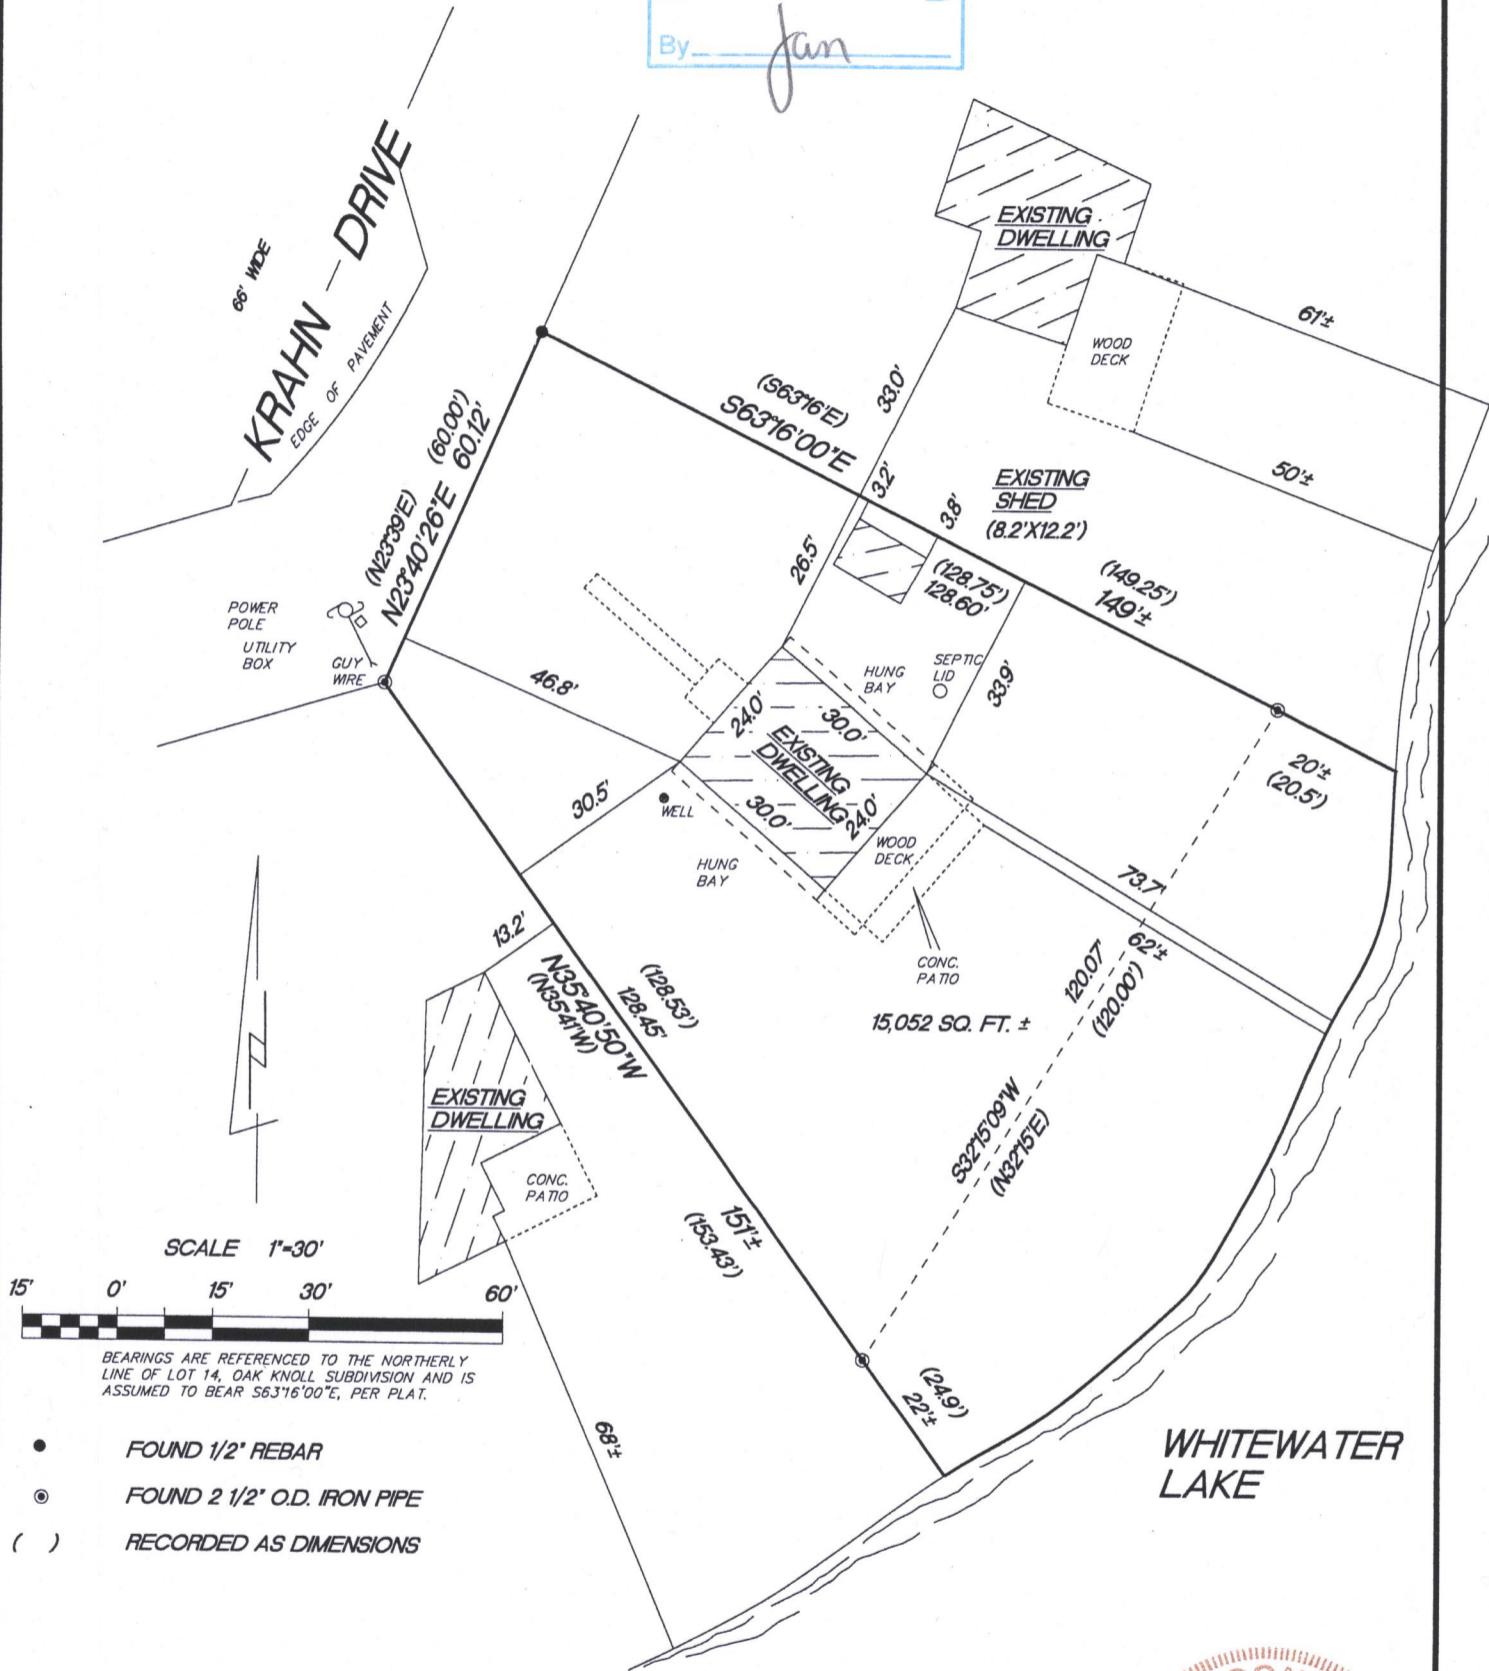

I hereby certify that I have surveyed the above described property and that the above map is a true representation thereof and shows the size and location of the property, its exterior boundaries, the location of all visible structures and dimensions of all principal buildings thereon, boundary fences, apparent easements, roadways and encroachments if any.

"This survey is made for the use of the present owners of the property, and also those who purchase, mortgage or guarantee the title thereto within one year from date hereof."

REV. 5/3/17  
4/15/03

KETTLE MORAINESURVEYING INC.  
S75 W36245 Wilton Road  
Eagle Wisconsin 53119  
P.O. Box 357  
(262) 594-3484  
kettlemorainesurvey.com  
Terrance E. Pisarek P.L.S.



THIS IS NOT AN ORIGINAL SURVEY UNLESS THE SEAL IS RED.

DATE	FIELD WORK BY	TEP	DRAWN BY	JOB NUMBER
------	---------------	-----	----------	------------

COK-14

315-1303