

LAND-MARK SURVEYING
Mark L. Miritz
Wisconsin Professional Land Surveyor S-2582


N9330 Knuteson Drive
Whitewater, WI 53190
Phone: (262) 495-3284
MARKMIRITZ@
LAND-MARKSURVEYING.COM

ORDERED BY:
JULIE HANSEN
COLDWELL BANKER
10 W. MAIN STREET
CARY, IL 60013

PLAT OF SURVEY

LOT 16, BLOCK 6, OF CHAPEL HILLS SUBDIVISION,
LOCATED IN THE NORTHEAST 1/4 OF SECTION 3,
TOWN 3 NORTH, RANGE 15 EAST, RICHMOND
TOWNSHIP, WALWORTH COUNTY, WISCONSIN.

LOT 15

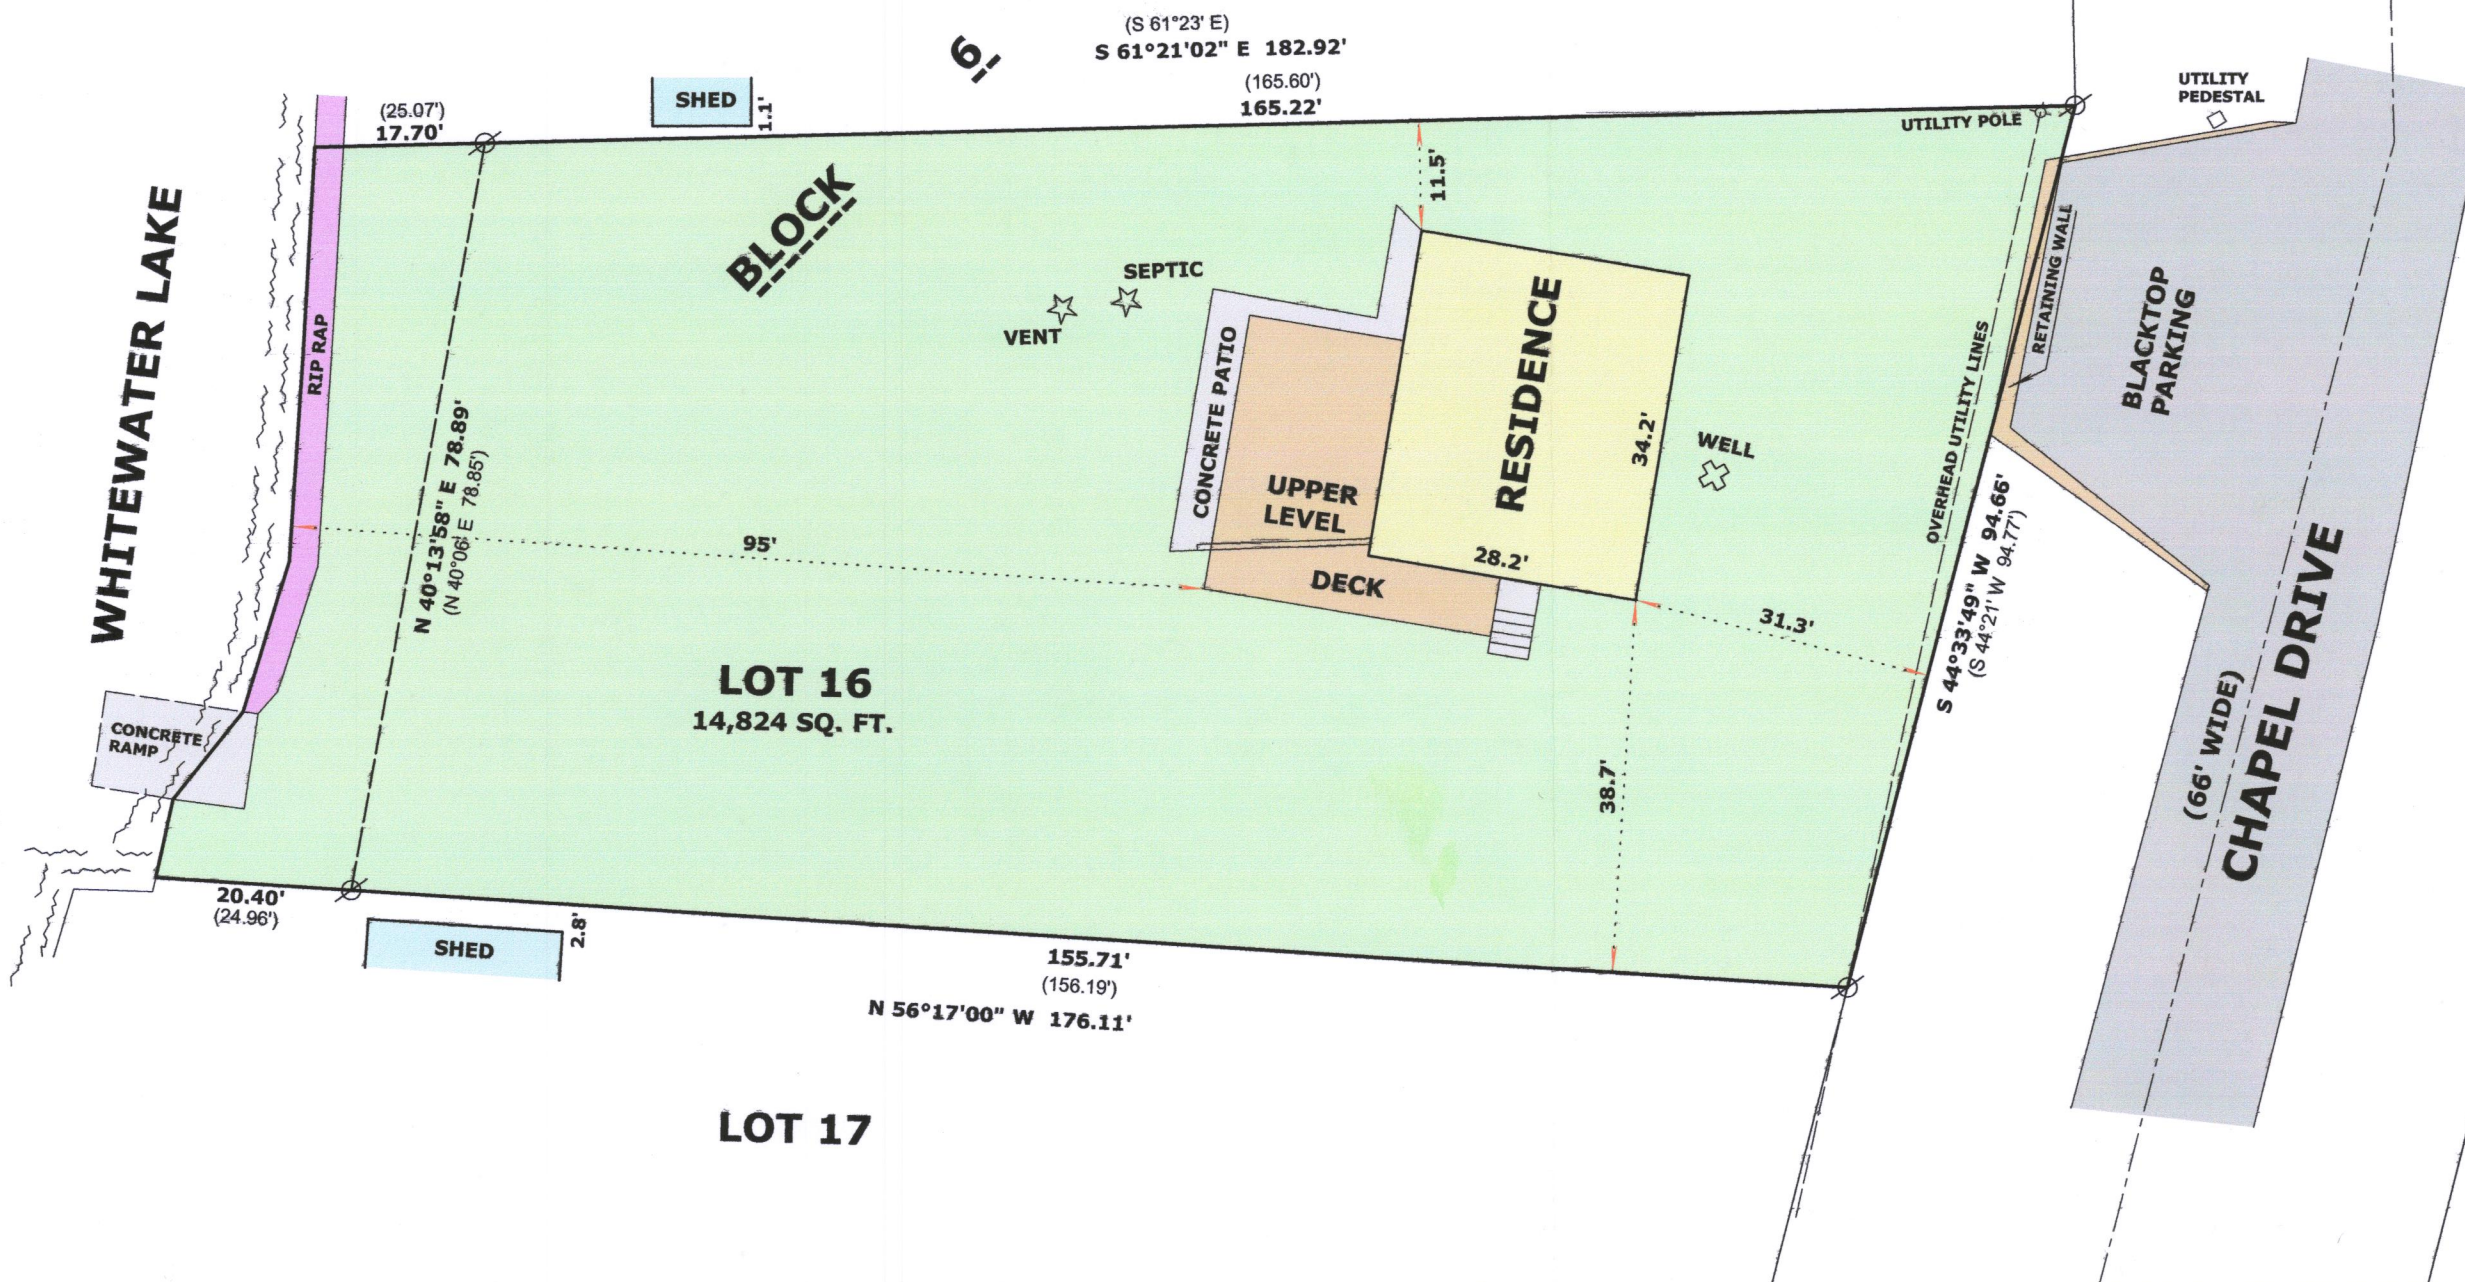

CCH-16

315-1306